


06-25-038-108-031,032,013,015

6-104

SCAN #46006

GULF ROAD

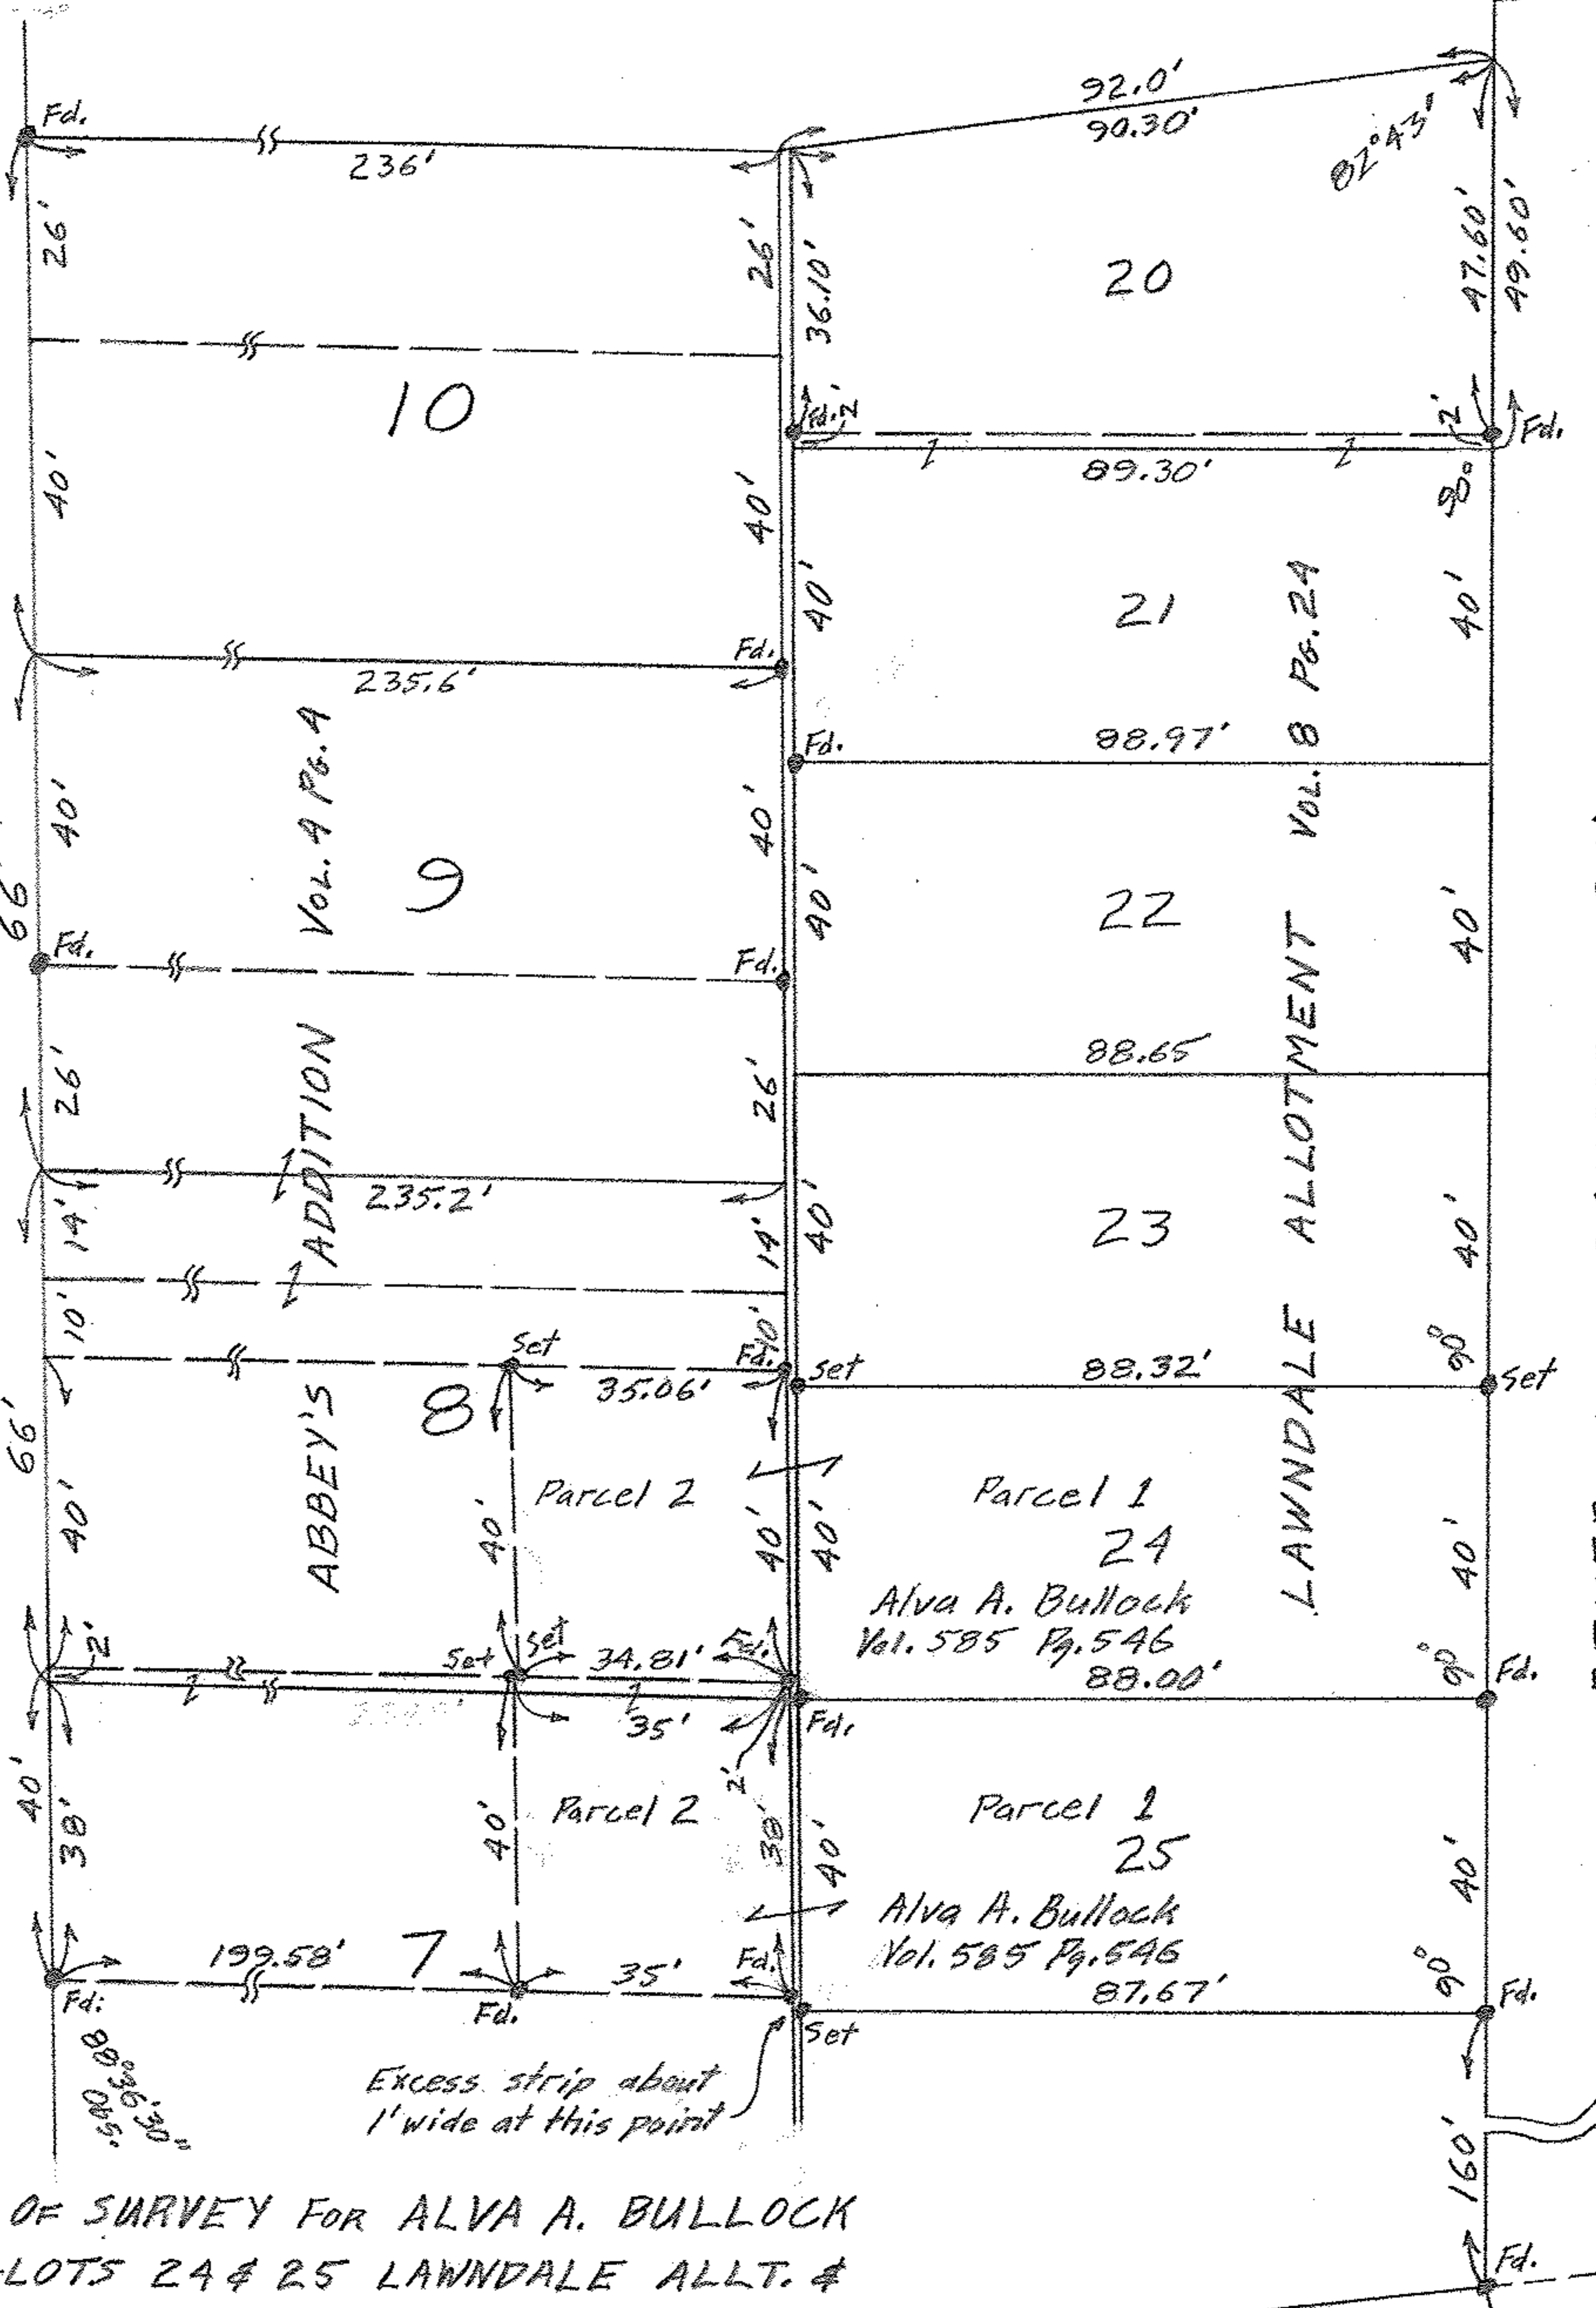

PLAT OF SURVEY FOR ALVA A. BULLOCK  
 SUB-LOTS 24 & 25 LAWNDALE ALLT. &  
 PARTS OF SUB-LOTS 7 & 8 ABBEY'S ADDN.

ORIG. LOT 38 EAST OF BLACK RIVER - ELYRIA TWP.  
 LORAIN COUNTY - OHIO

C.E. Perfound Registered Surveyor

SCALE: 1" = 30'  
 Iron pins found or set  
 shown thus: ●