


100-20-021-001

06-25-057-000-001

CITY TITLE Co. Order No. E-1177-8 6-103 Scan # 46009  
Frank & Anne L. Urpschot to David S. & Mary Jo Kaszubinski

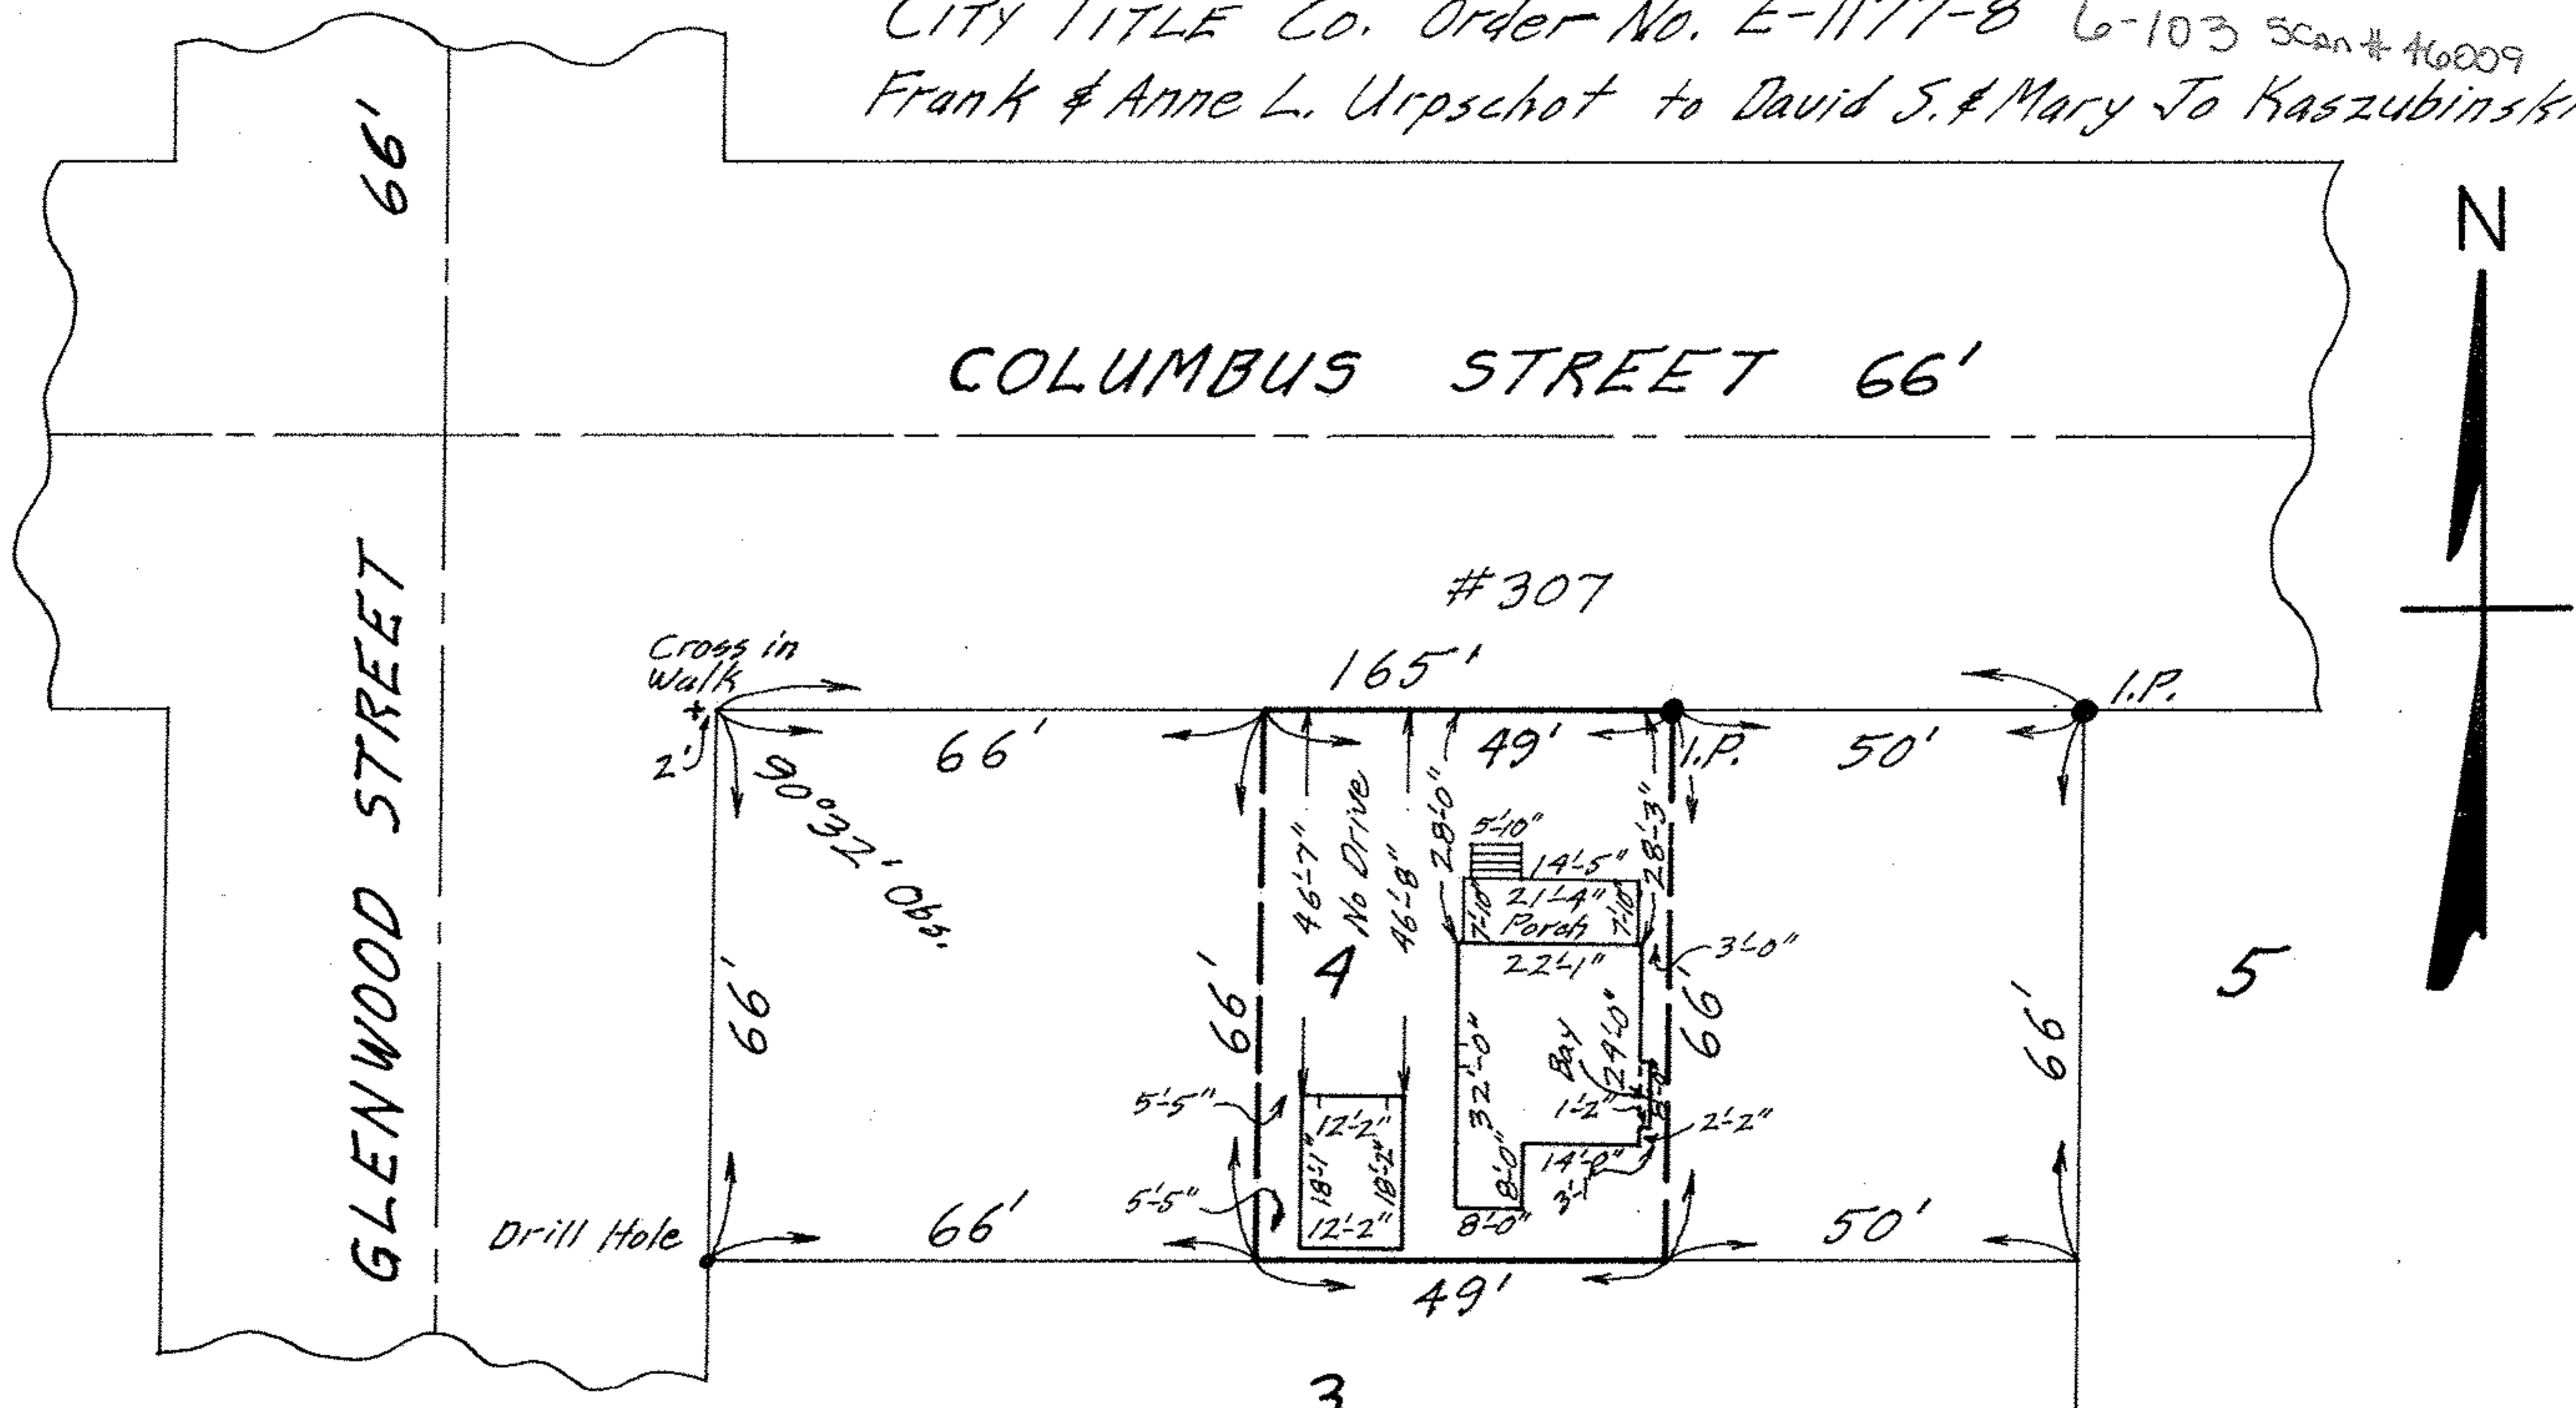

MAP OF THE EASTERLY 49 FEET OF THE WESTERLY 115 FEET OF  
 SUB-LOT NO. 4 OF T. L. NELSON'S ADD'N. VOL. 2 Pg. 14 PLATS  
 ORIGINAL LOT 51 - EAST OF BLACK RIVER - ELYRIA TWP.  
 ELYRIA CITY LORAIN COUNTY OHIO  
 SCALE: 1" = 30' JUNE 25-1970 11:50 A.M.  
 NOTE: There are no encroachments on this property.  
 Gary E. Penfound REG. SURVEYOR NO. 4457