


L-103
SCAN# 46010

EAST RIVER STREET

66'

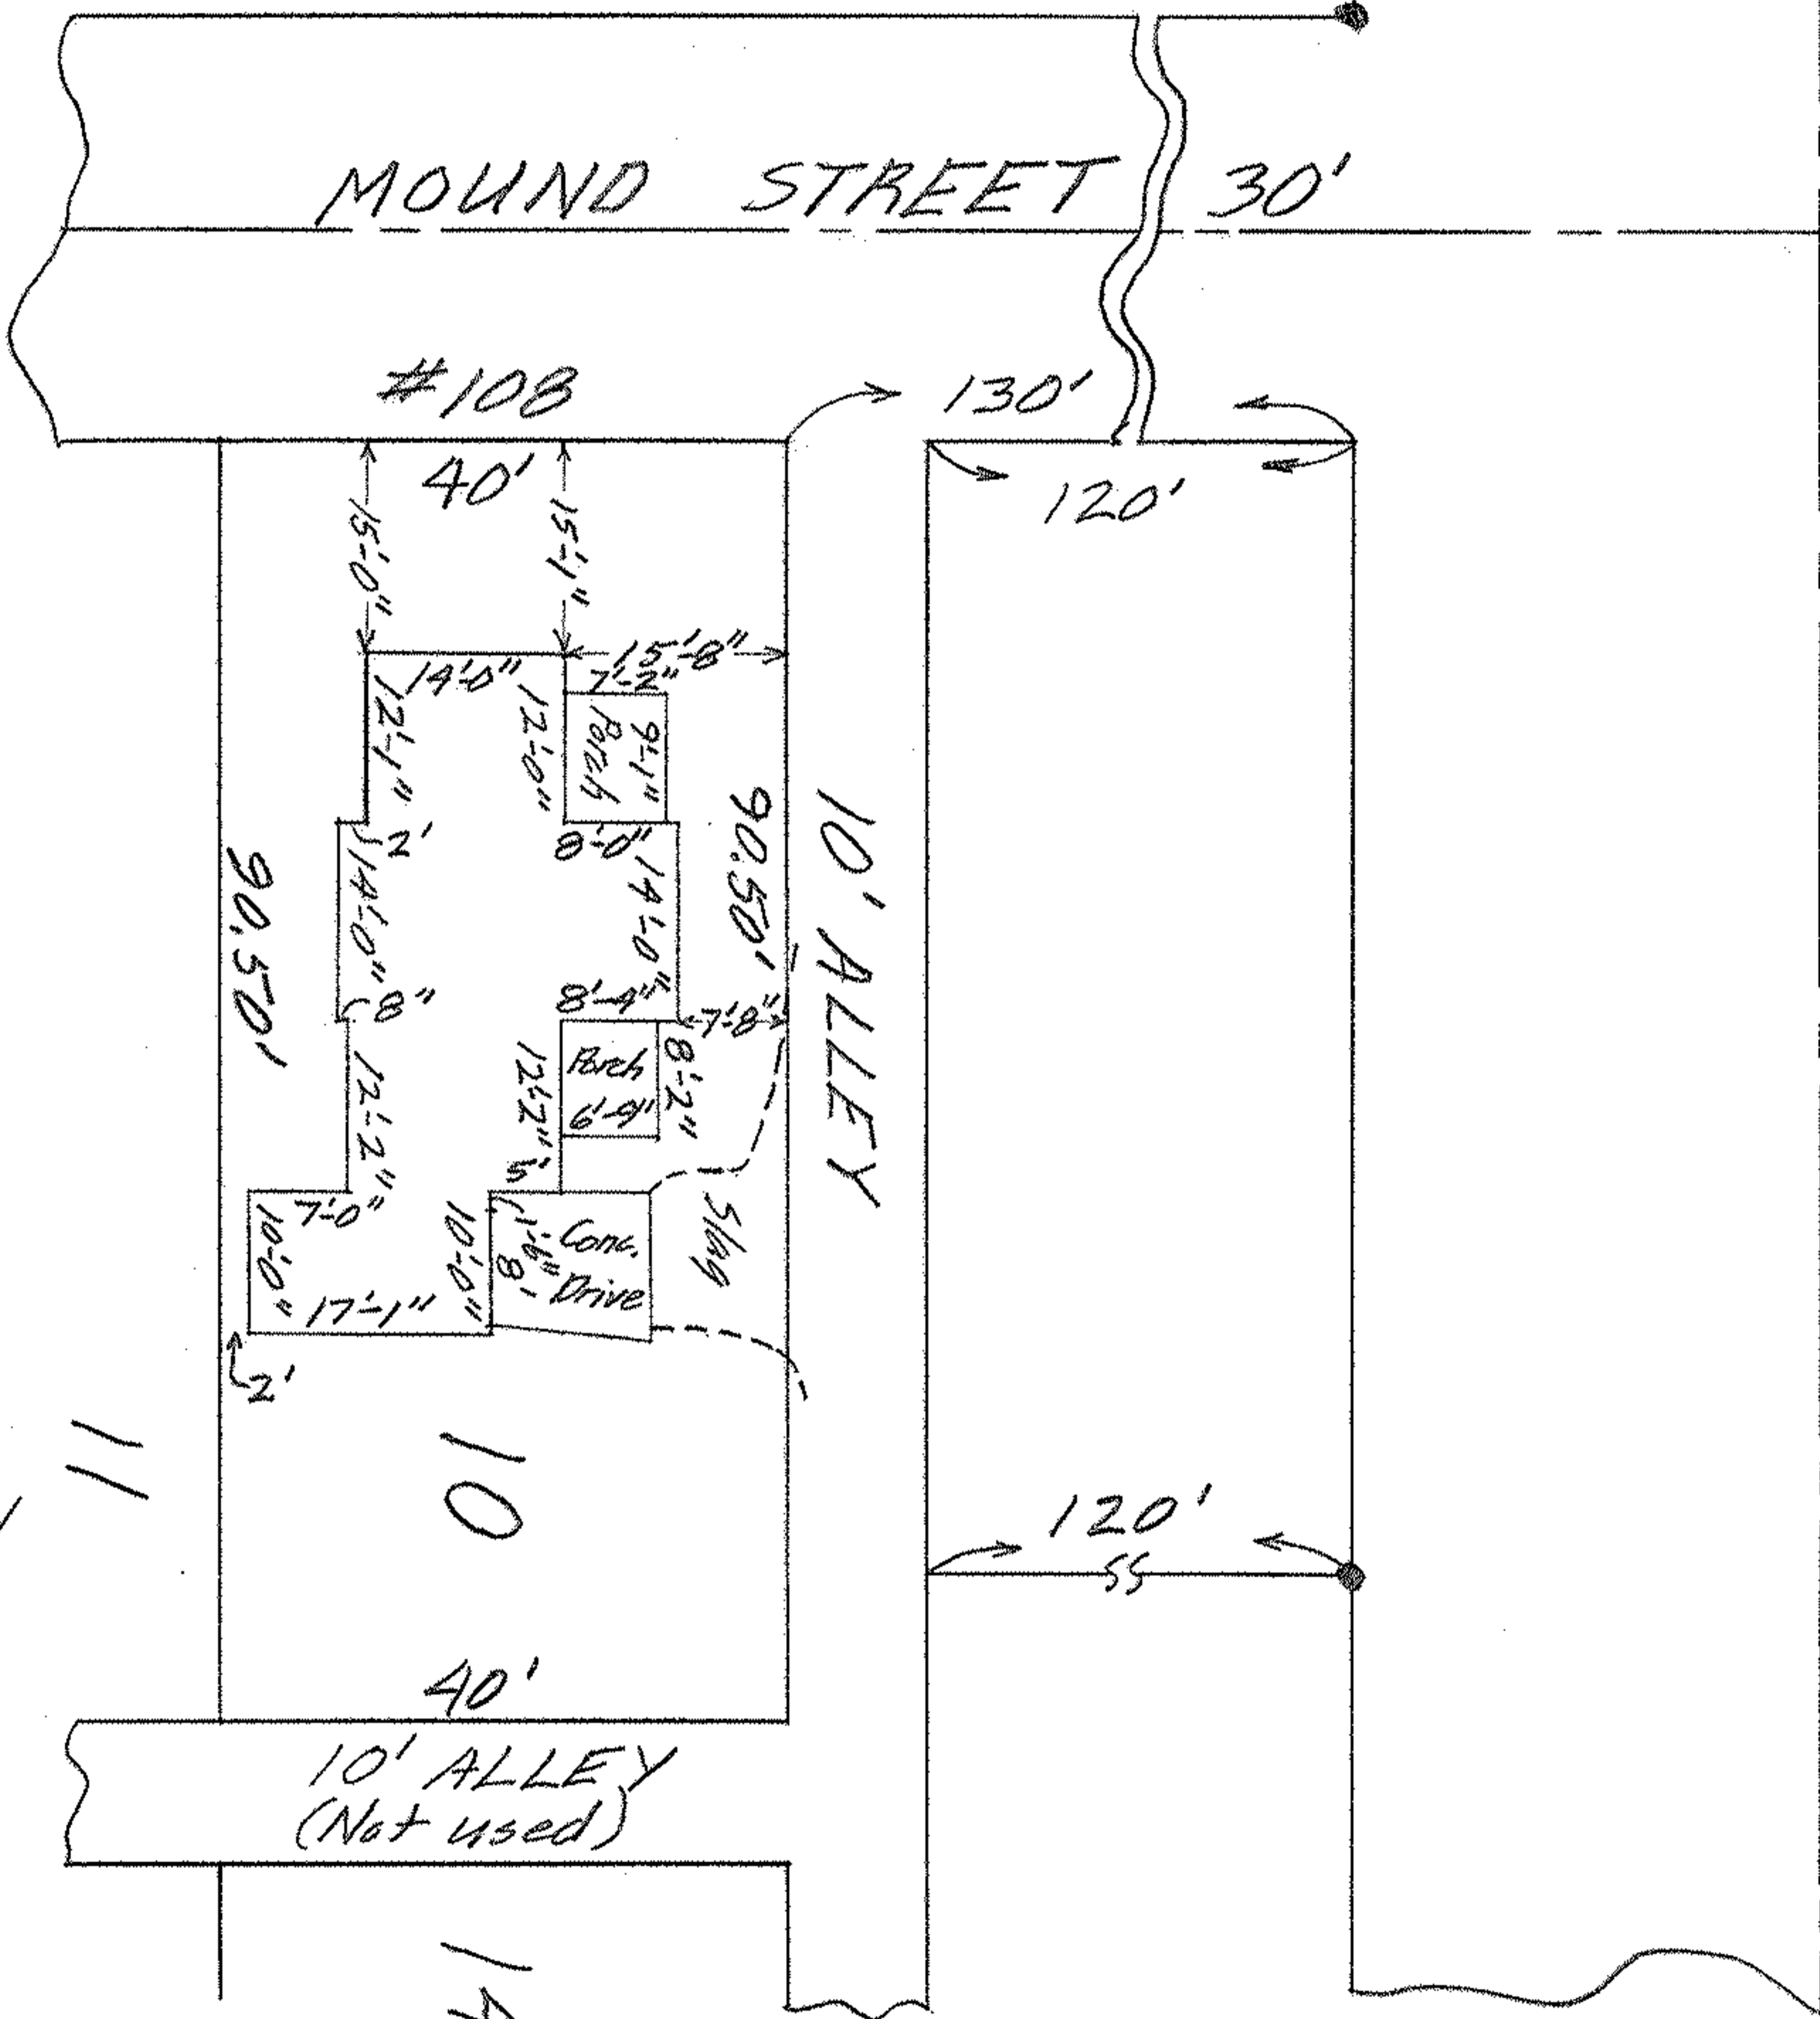

MAP OF SUB-LOT NO. 10

W. E. BROOKS SUB'DIV. VOL. 4 PG. 35

ELYRIA TWP. ELYRIA CITY

LORAIN COUNTY - OHIO

SCALE: 1"=20' JULY 10-1963 2:30 P.M.

Ray E. Tomford RES. SURVEYOR

Kenneth C. & Barbara J. McNeil W/W

