

06-25-056-000-016

6-103


Scan # 46011

EAST RIVER STREET 66'

120'


120'  
130'

30'

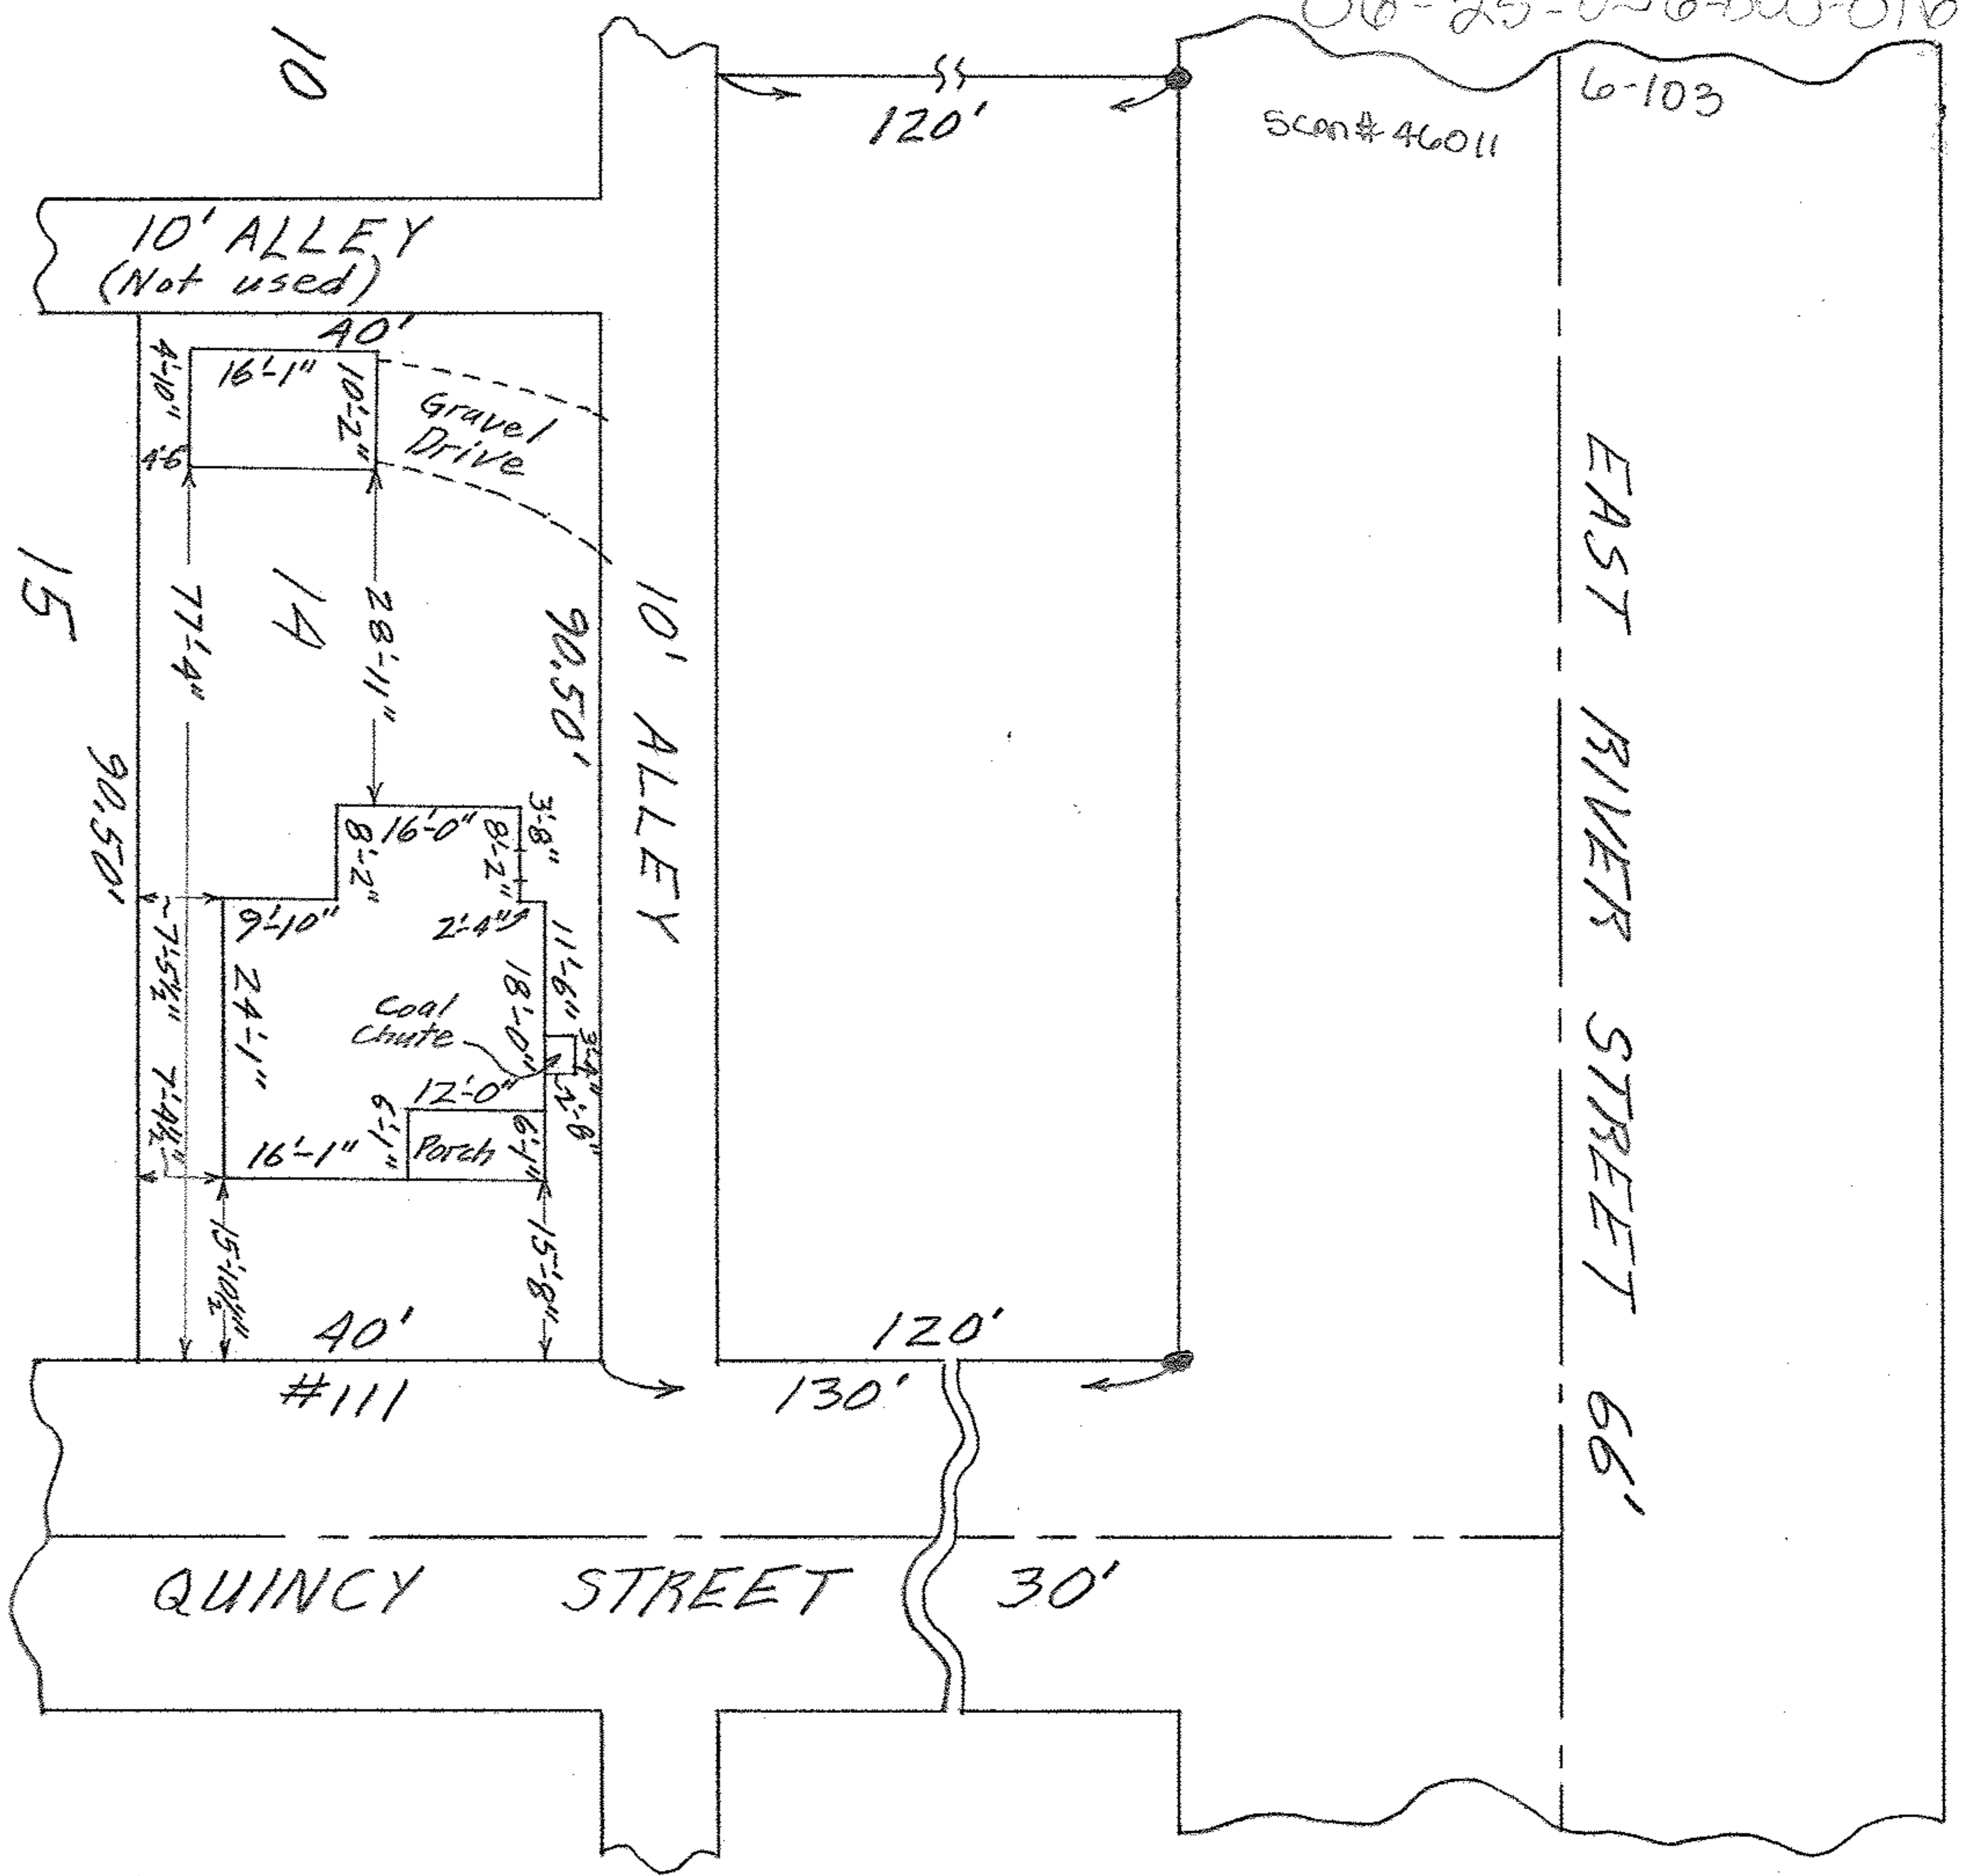

15

10

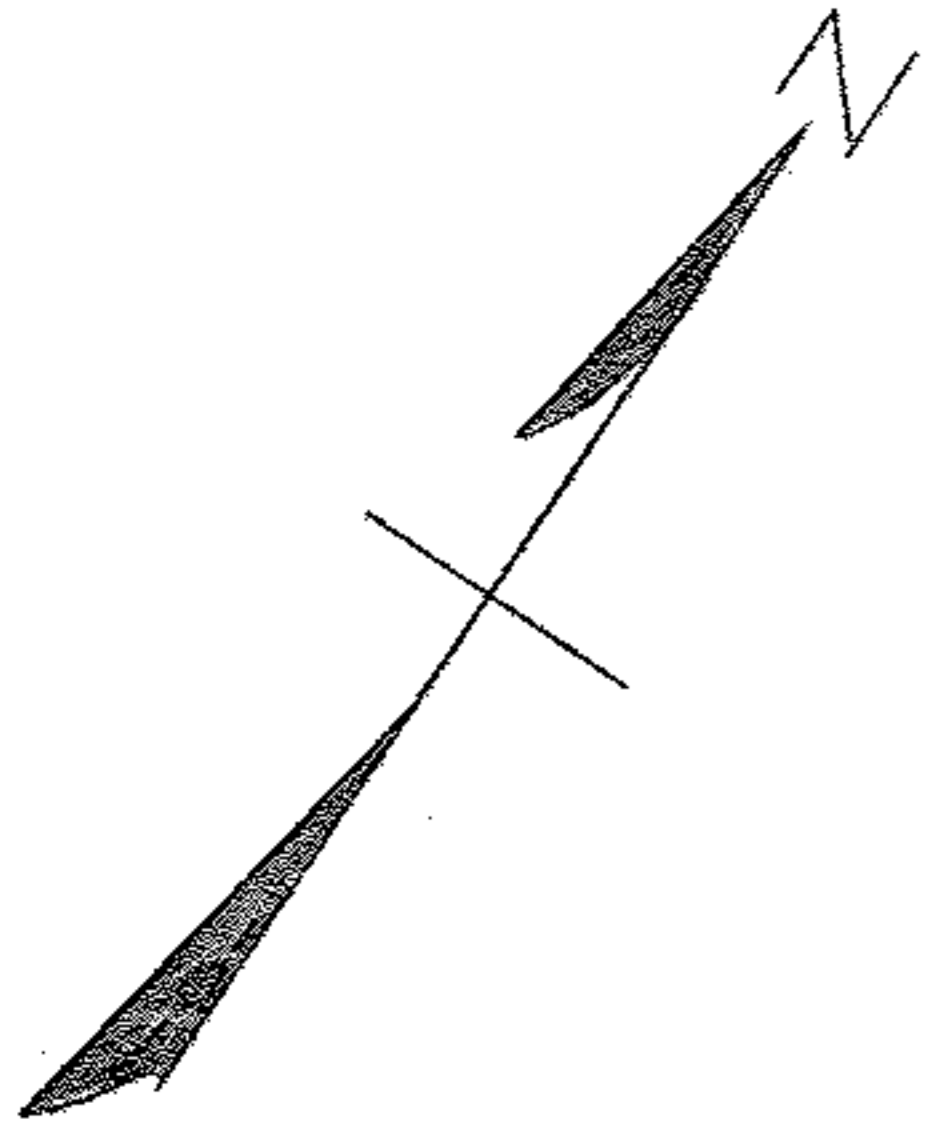

MAP OF SUB-LOT NO. 14  
 W. E. BROOKS SUBN. Vol. 4 Pg. 35  
 ELYRIA TWP. - ELYRIA CITY  
 LORAIN COUNTY - OHIO W W  
 SCALE: 1" = 20' MARCH 22-1963 2:45 PM.  
 Gary E. Penfound REG. SURVEYOR  
 Ervin Edward Cogar & Helen Lucille Cogar