


06-25-078-102-014  
6-121 SCAN # 4033

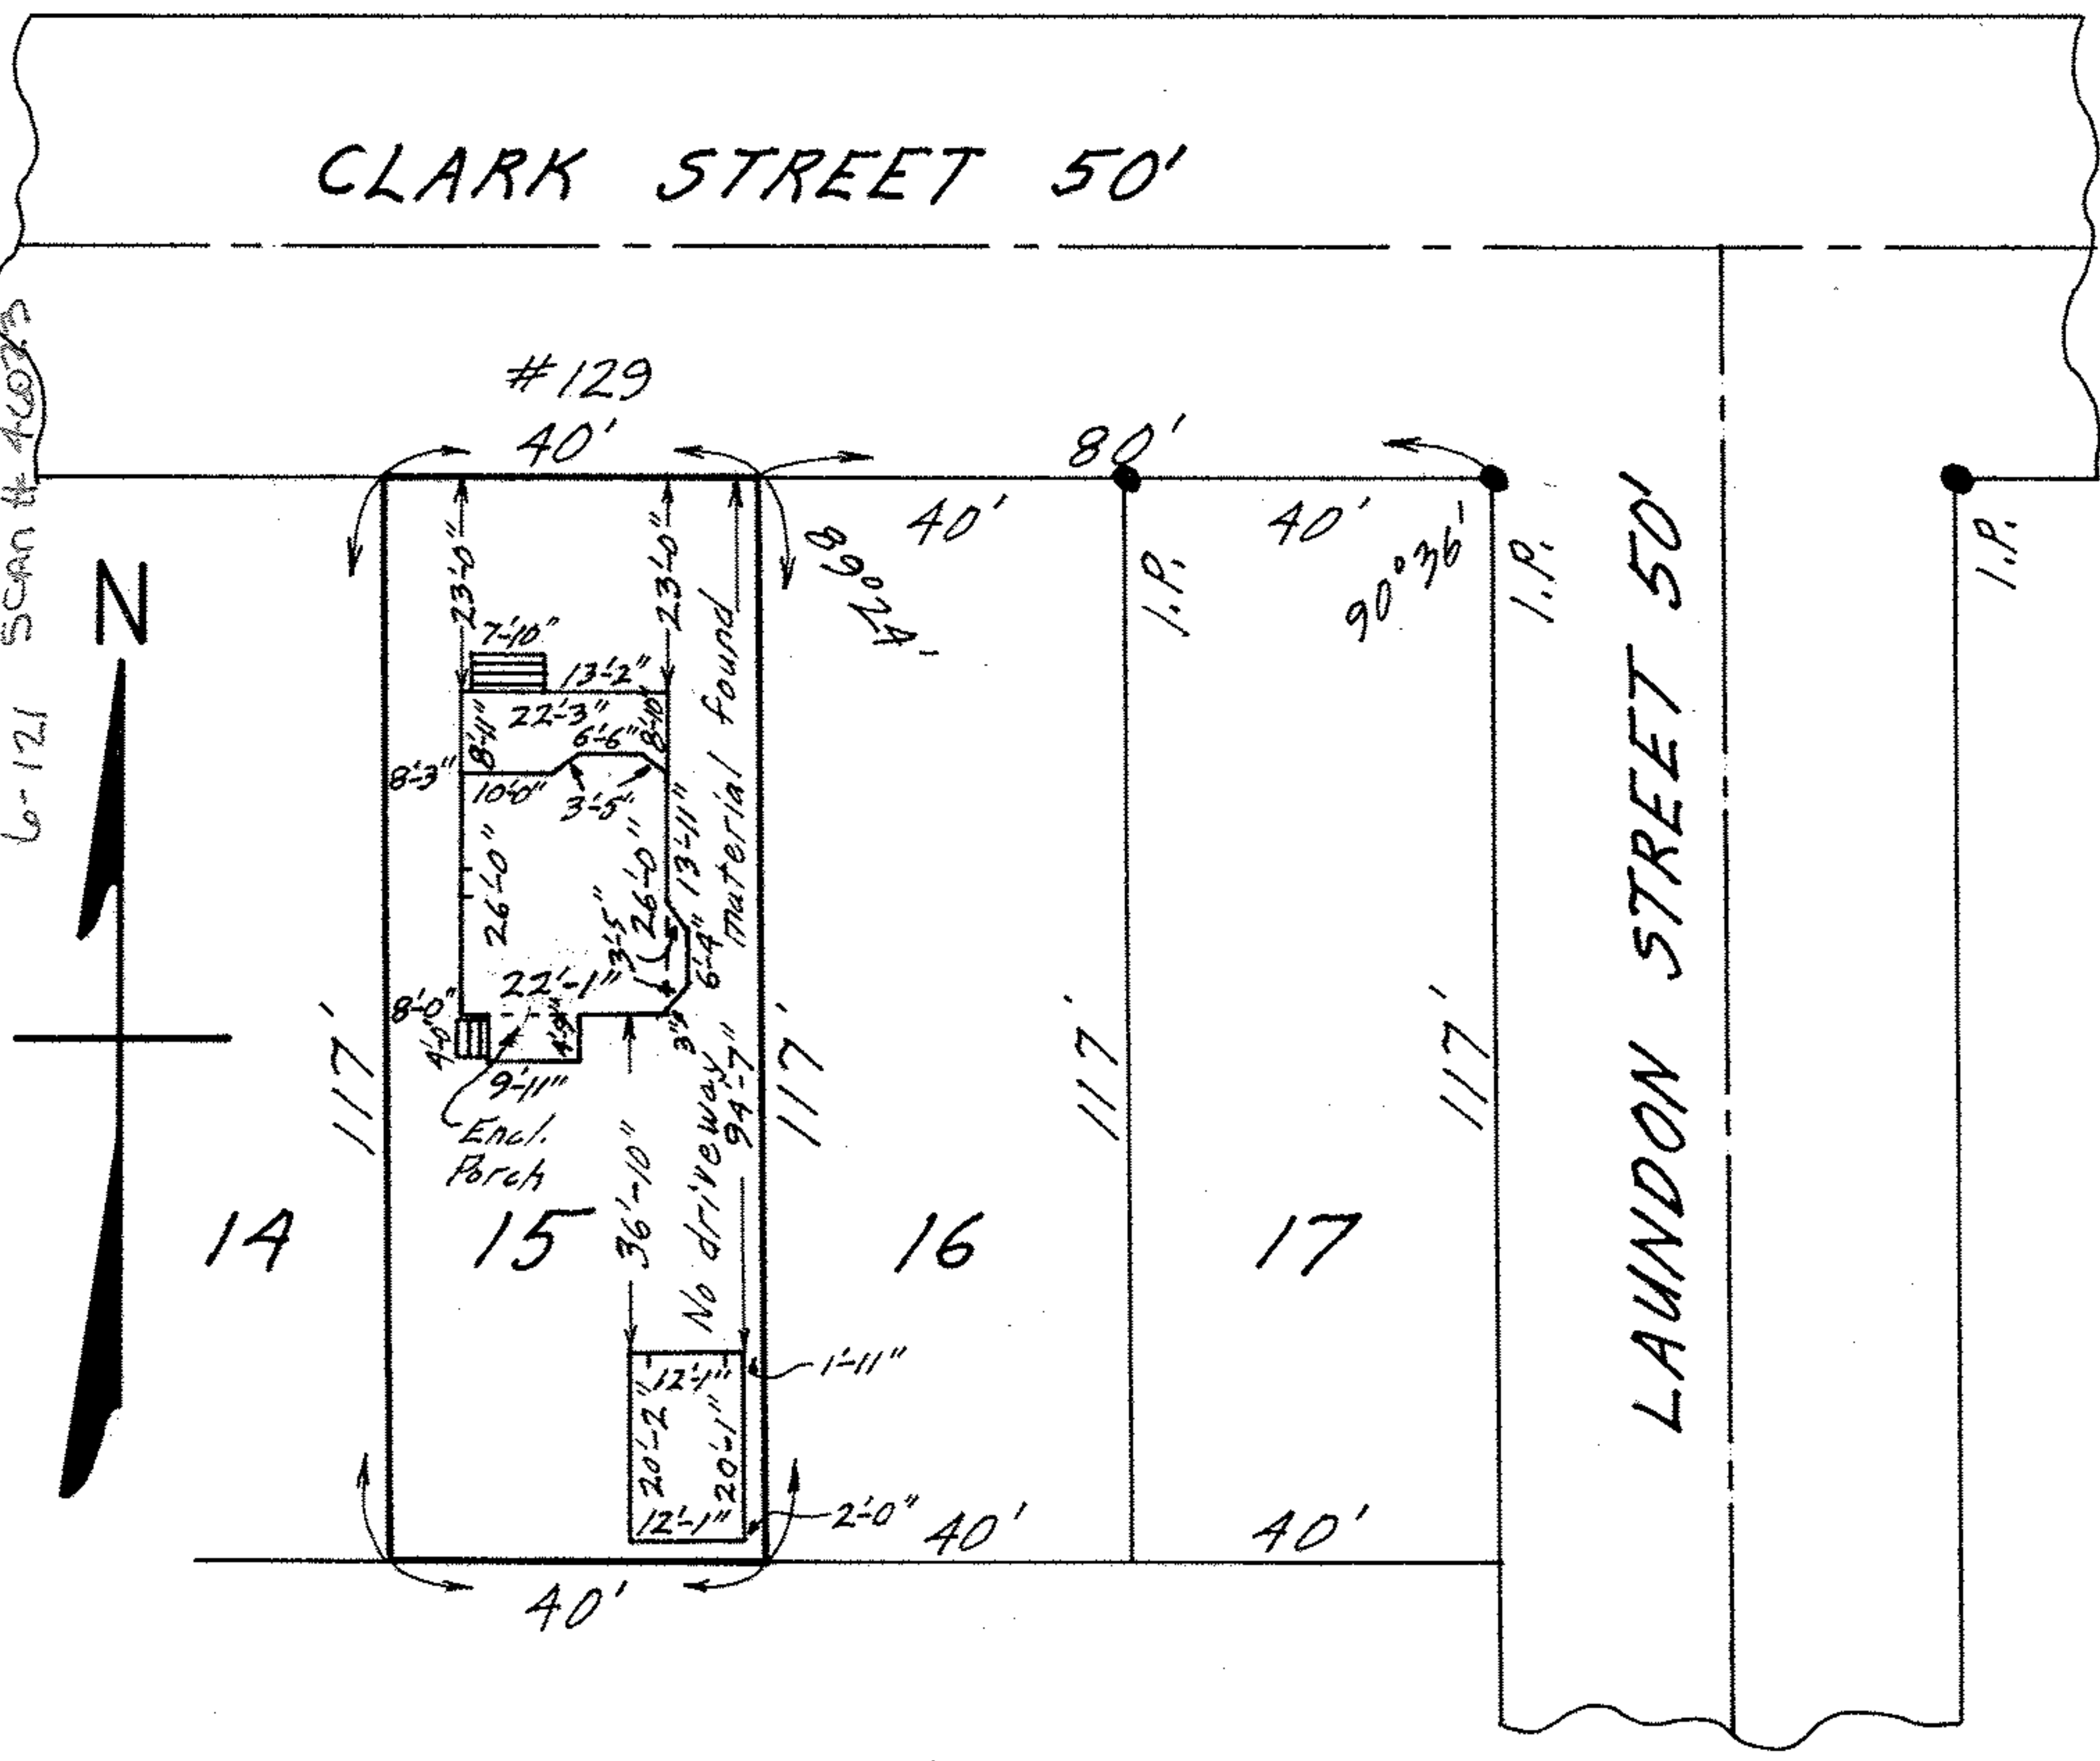

MAP OF SUB-LOT NO. 15

LAUNDON ALL'T. VOL. 8 PG. 1 PLATS  
ORIG. LOT 78-EAST OF RIVER-ELYRIA TWP.  
ELYRIA CITY LORAIN COUNTY OHIO  
SCALE: 1"=30' JAN. 6-1970 5:30 P.M.

NOTE: There are no encroachments on this property.  
Gary E. Penfound REG. SURVEYOR NO. 4457

CITY TITLE Co. Order No. E-994-5  
Laura Reed to Wade H. & Dale L. Phillips