


06-25-078-103-001
 6-122
 Scan # 46024

CLARK STREET 50'

LAUNDON STREET 50'

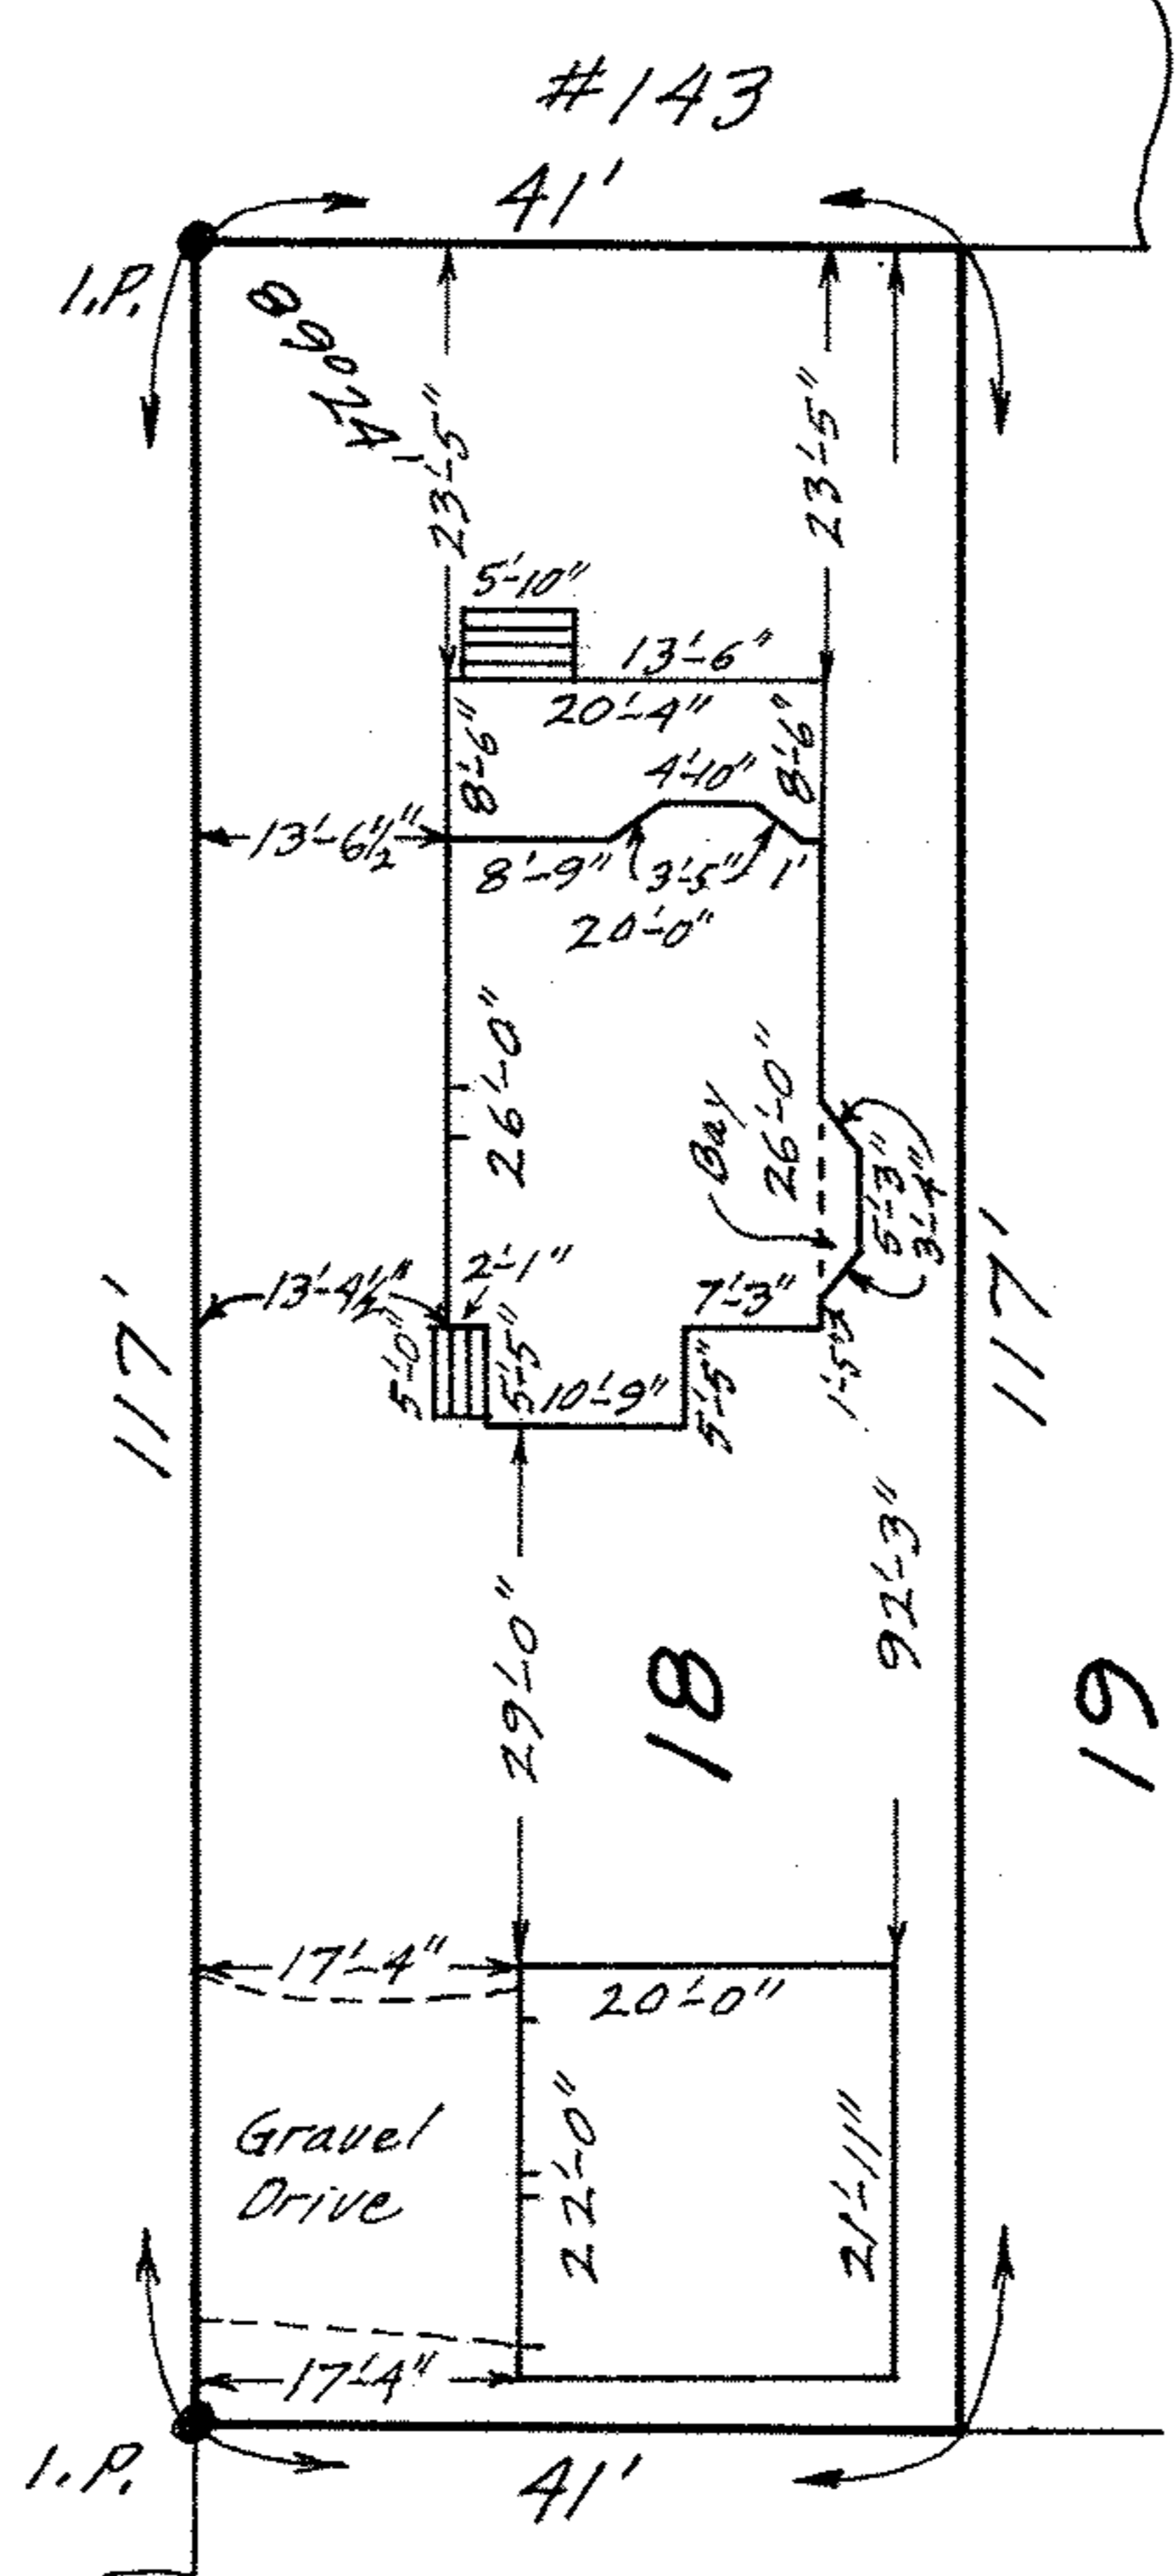

MAP OF SUB-LOT NO. 18
 LAUNDON ALL'T. VOL. 8 PG. 1 PLATS
 ORIG. LOT 78 - EAST OF BLACK RIVER - ELYRIA TWP.
 ELYRIA CITY - LORAIN COUNTY - OHIO
 SCALE: 1" = 20' SEPT. 25-1969 2:00 P.M.
 NOTE: There are no encroachments on this property.
 Gary E. Penfound REG. SURVEYOR NO. 4457

CITY TITLE Co. Order No. E-846-7
 William Fred Krach & Helen Louise Sheen
 to Ersel D. Lowther