


06-25-159-000-010, 011

L-84

SCAN #46028

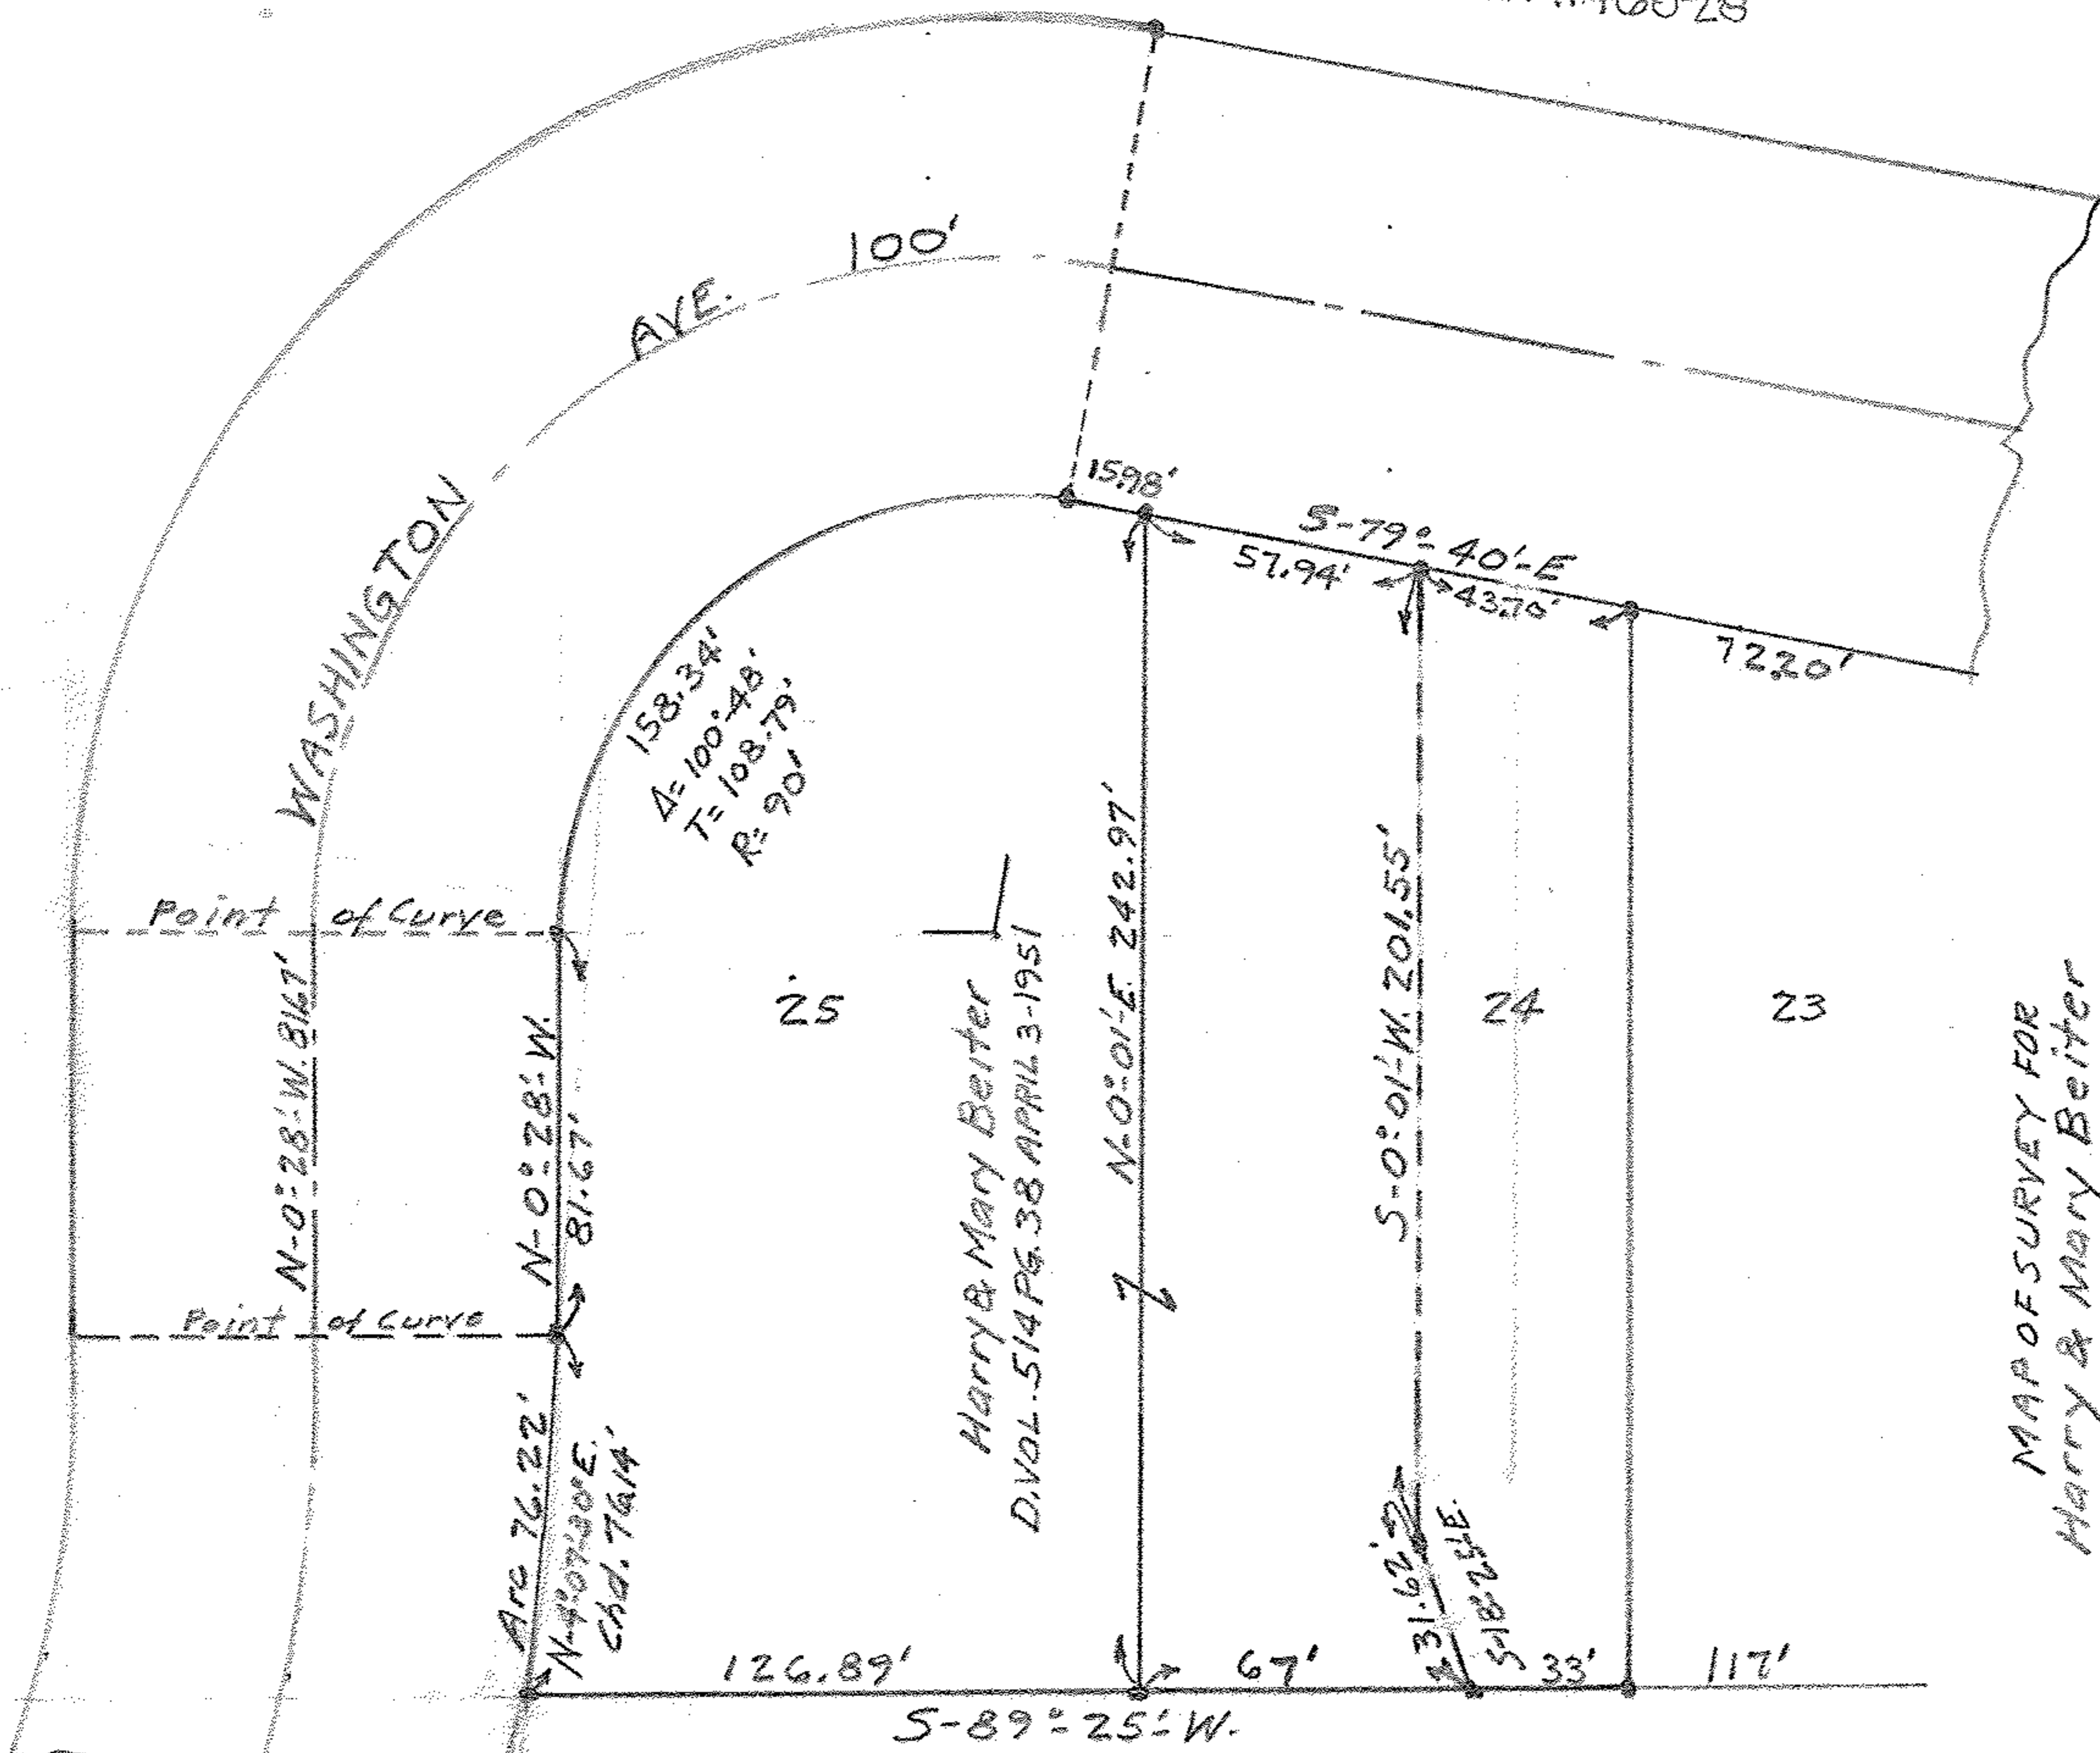

MAP OF SURVEY FOR
 Harry & Mary Beiter
 SUB-LOTS 24 & 25 ELYWOOD No. 4
 O.L. 41-42-156-158-159-160 EAST OF RIVER
 ELYRIA CITY - LORAIN COUNTY OHIO
 Scale 1" = 50 FT. May 2-1952
 C.E. Penfound Registered Surveyor

Note:- Iron pins found or set shown thus. ●