



06-26-002-101-005
6-137 5CAN#4034
L31-7

WEST AVENUE 66'

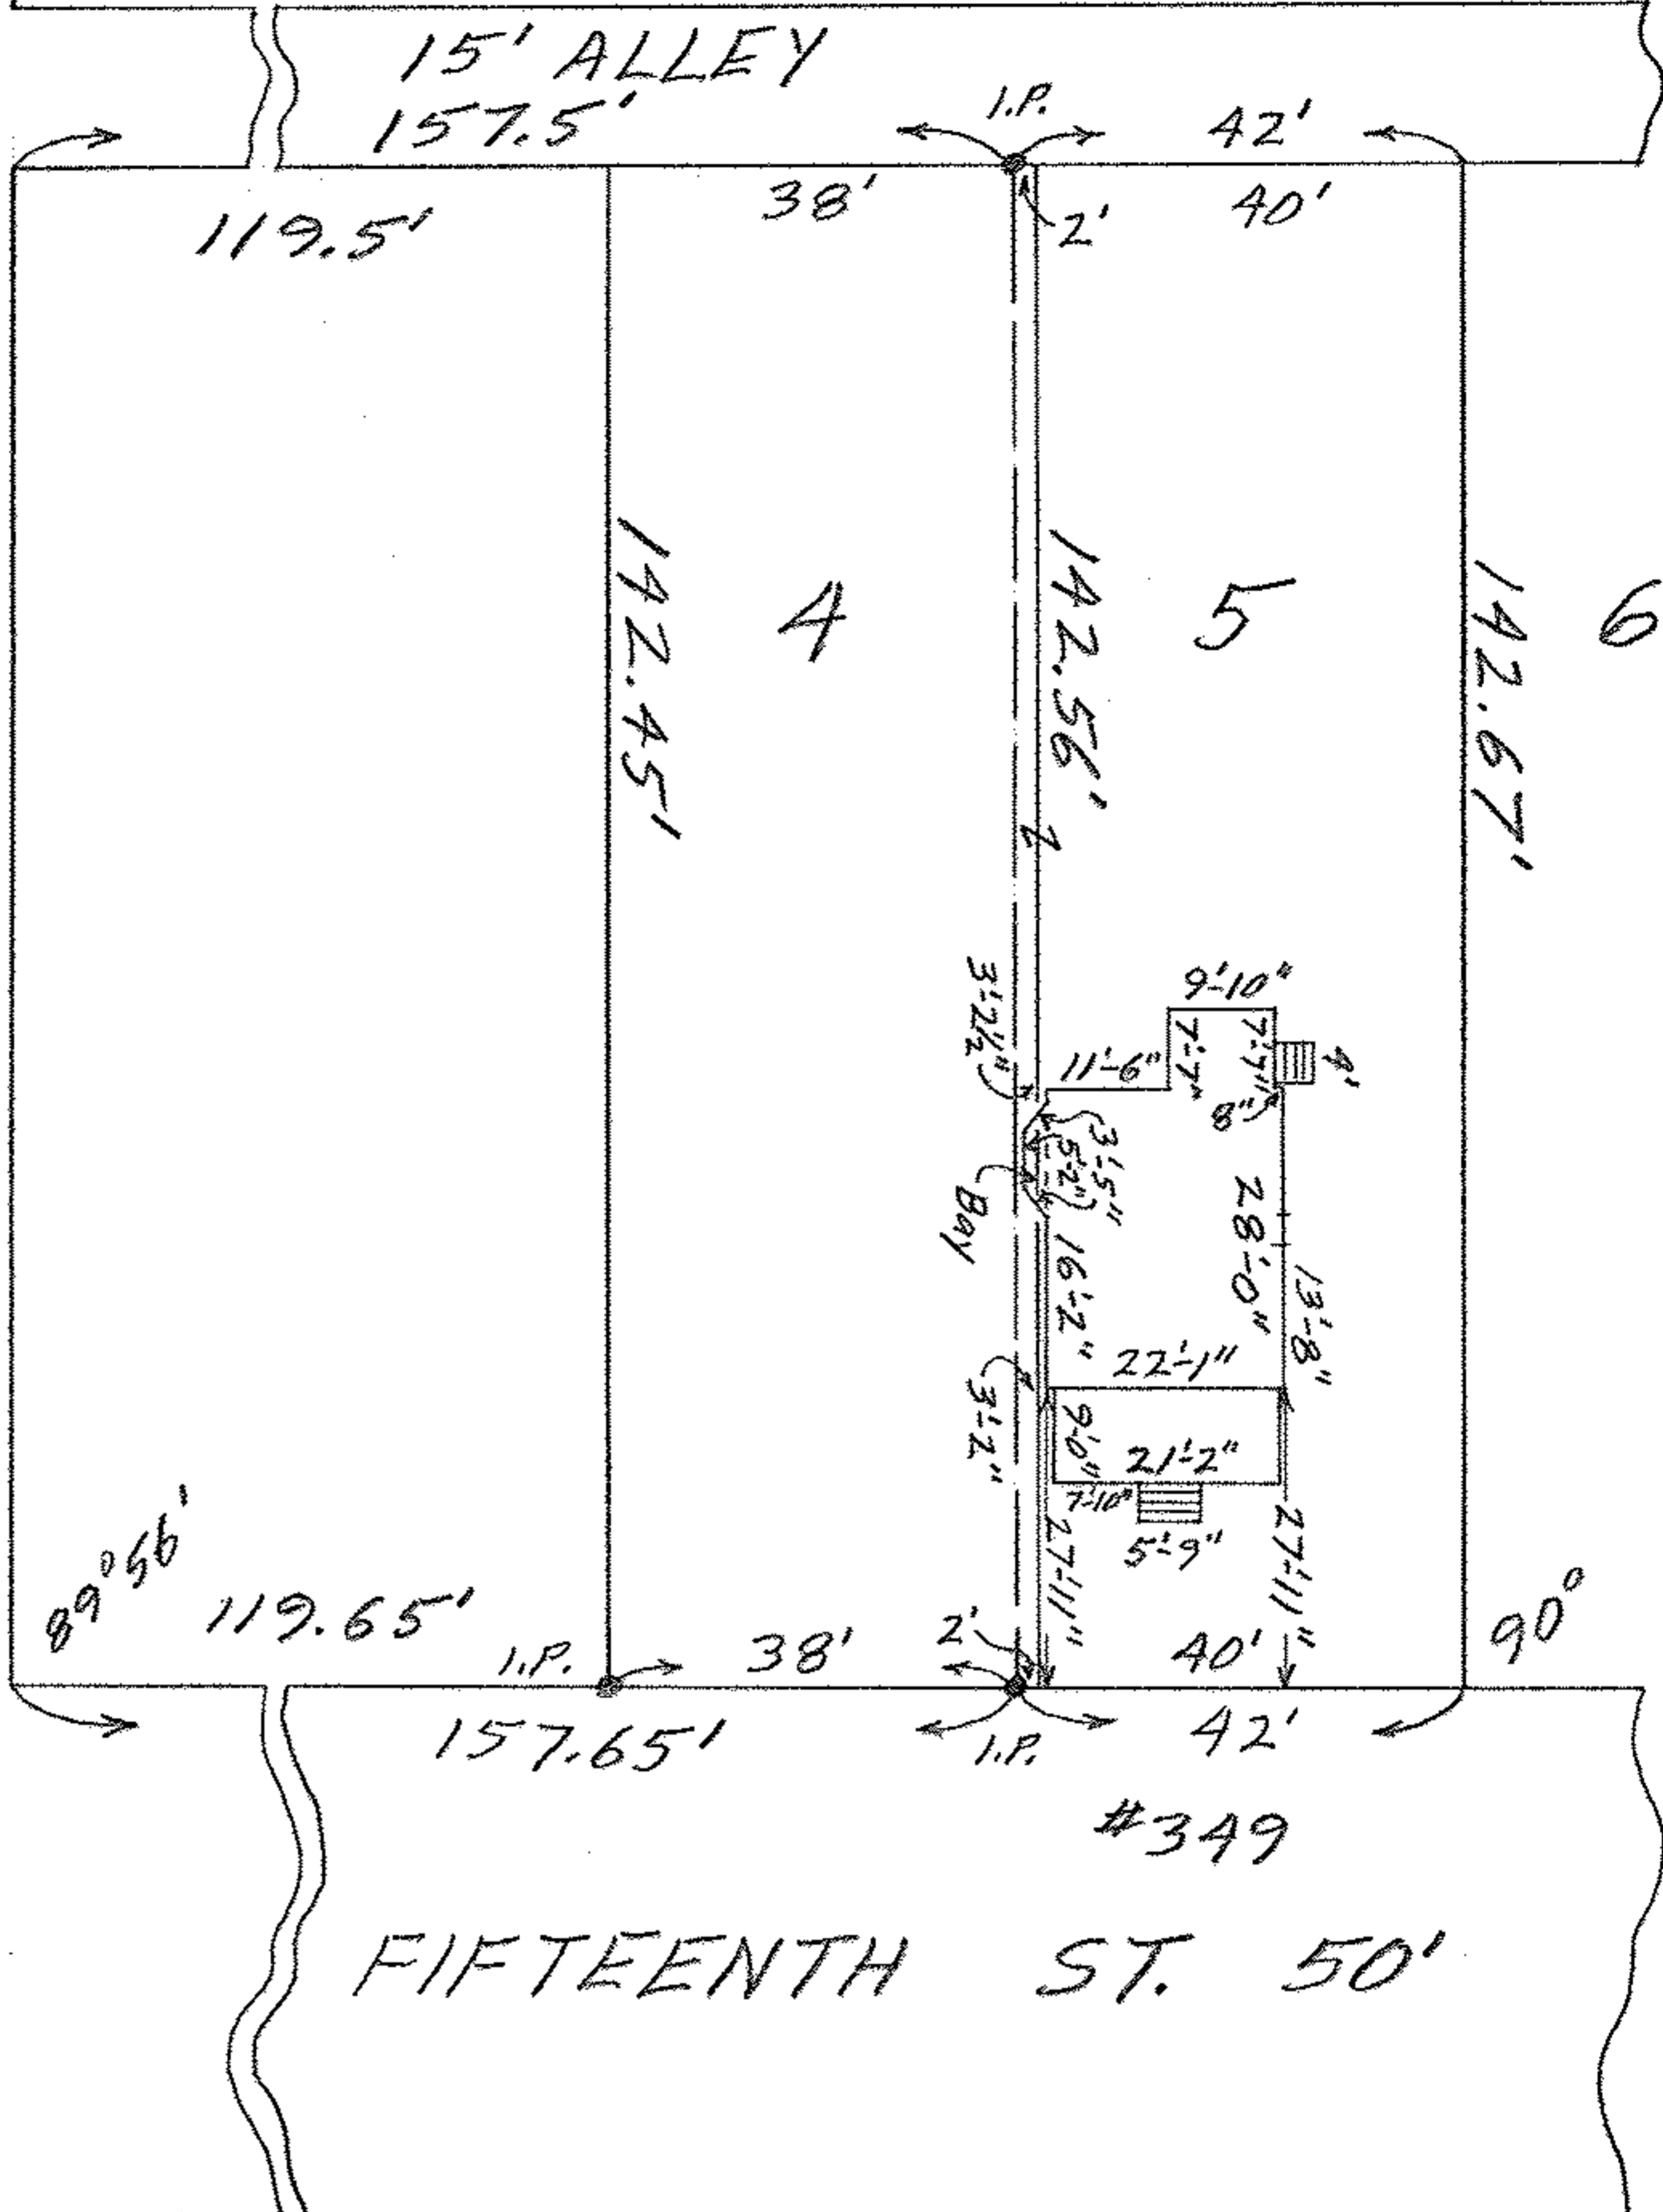

MAP OF SUB-LOT NO. 5 AND EASTERLY
 2 FEET OF SUB-LOT NO. 4 OF
 OBITTS SUB'N. VOL. 6 PG. 42 PLATS
 ELYRIA TWP. ELYRIA CITY
 LORAIN COUNTY OHIO
 SCALE: 1" = 30' JAN. 29-1964 5:00 P.M.
 Gary E. Penfound REG. SURVEYOR

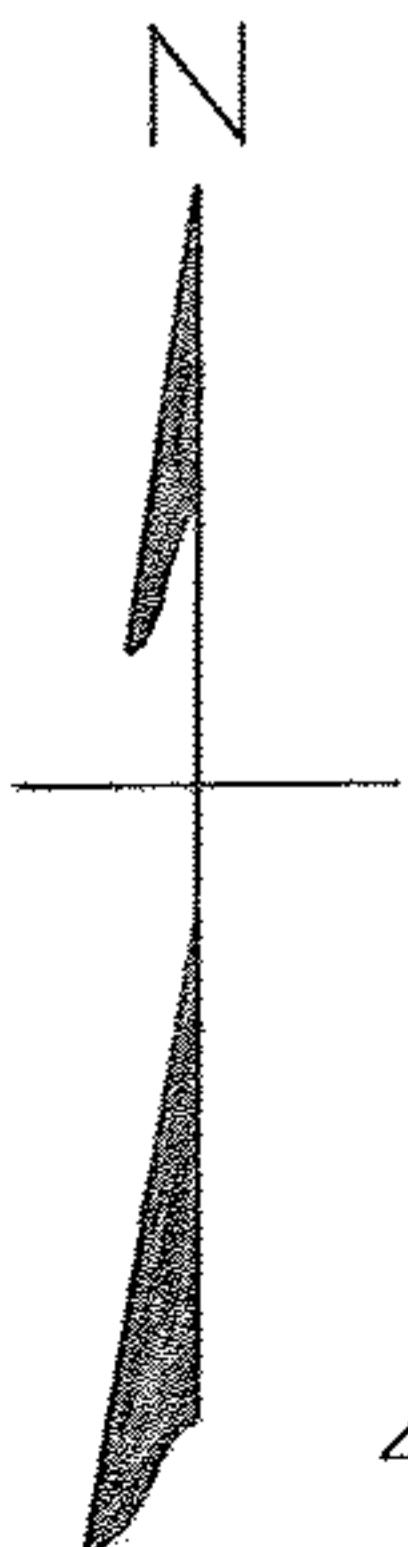

Earl Isaiah Woods & Hayako Y. Woods WW