
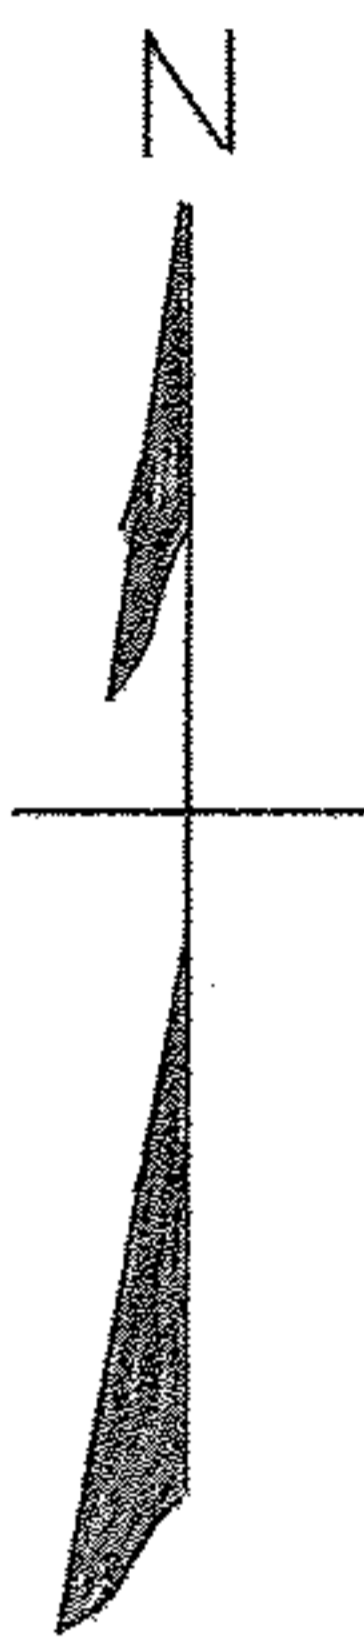


06-26-016-101-047

6-137
94

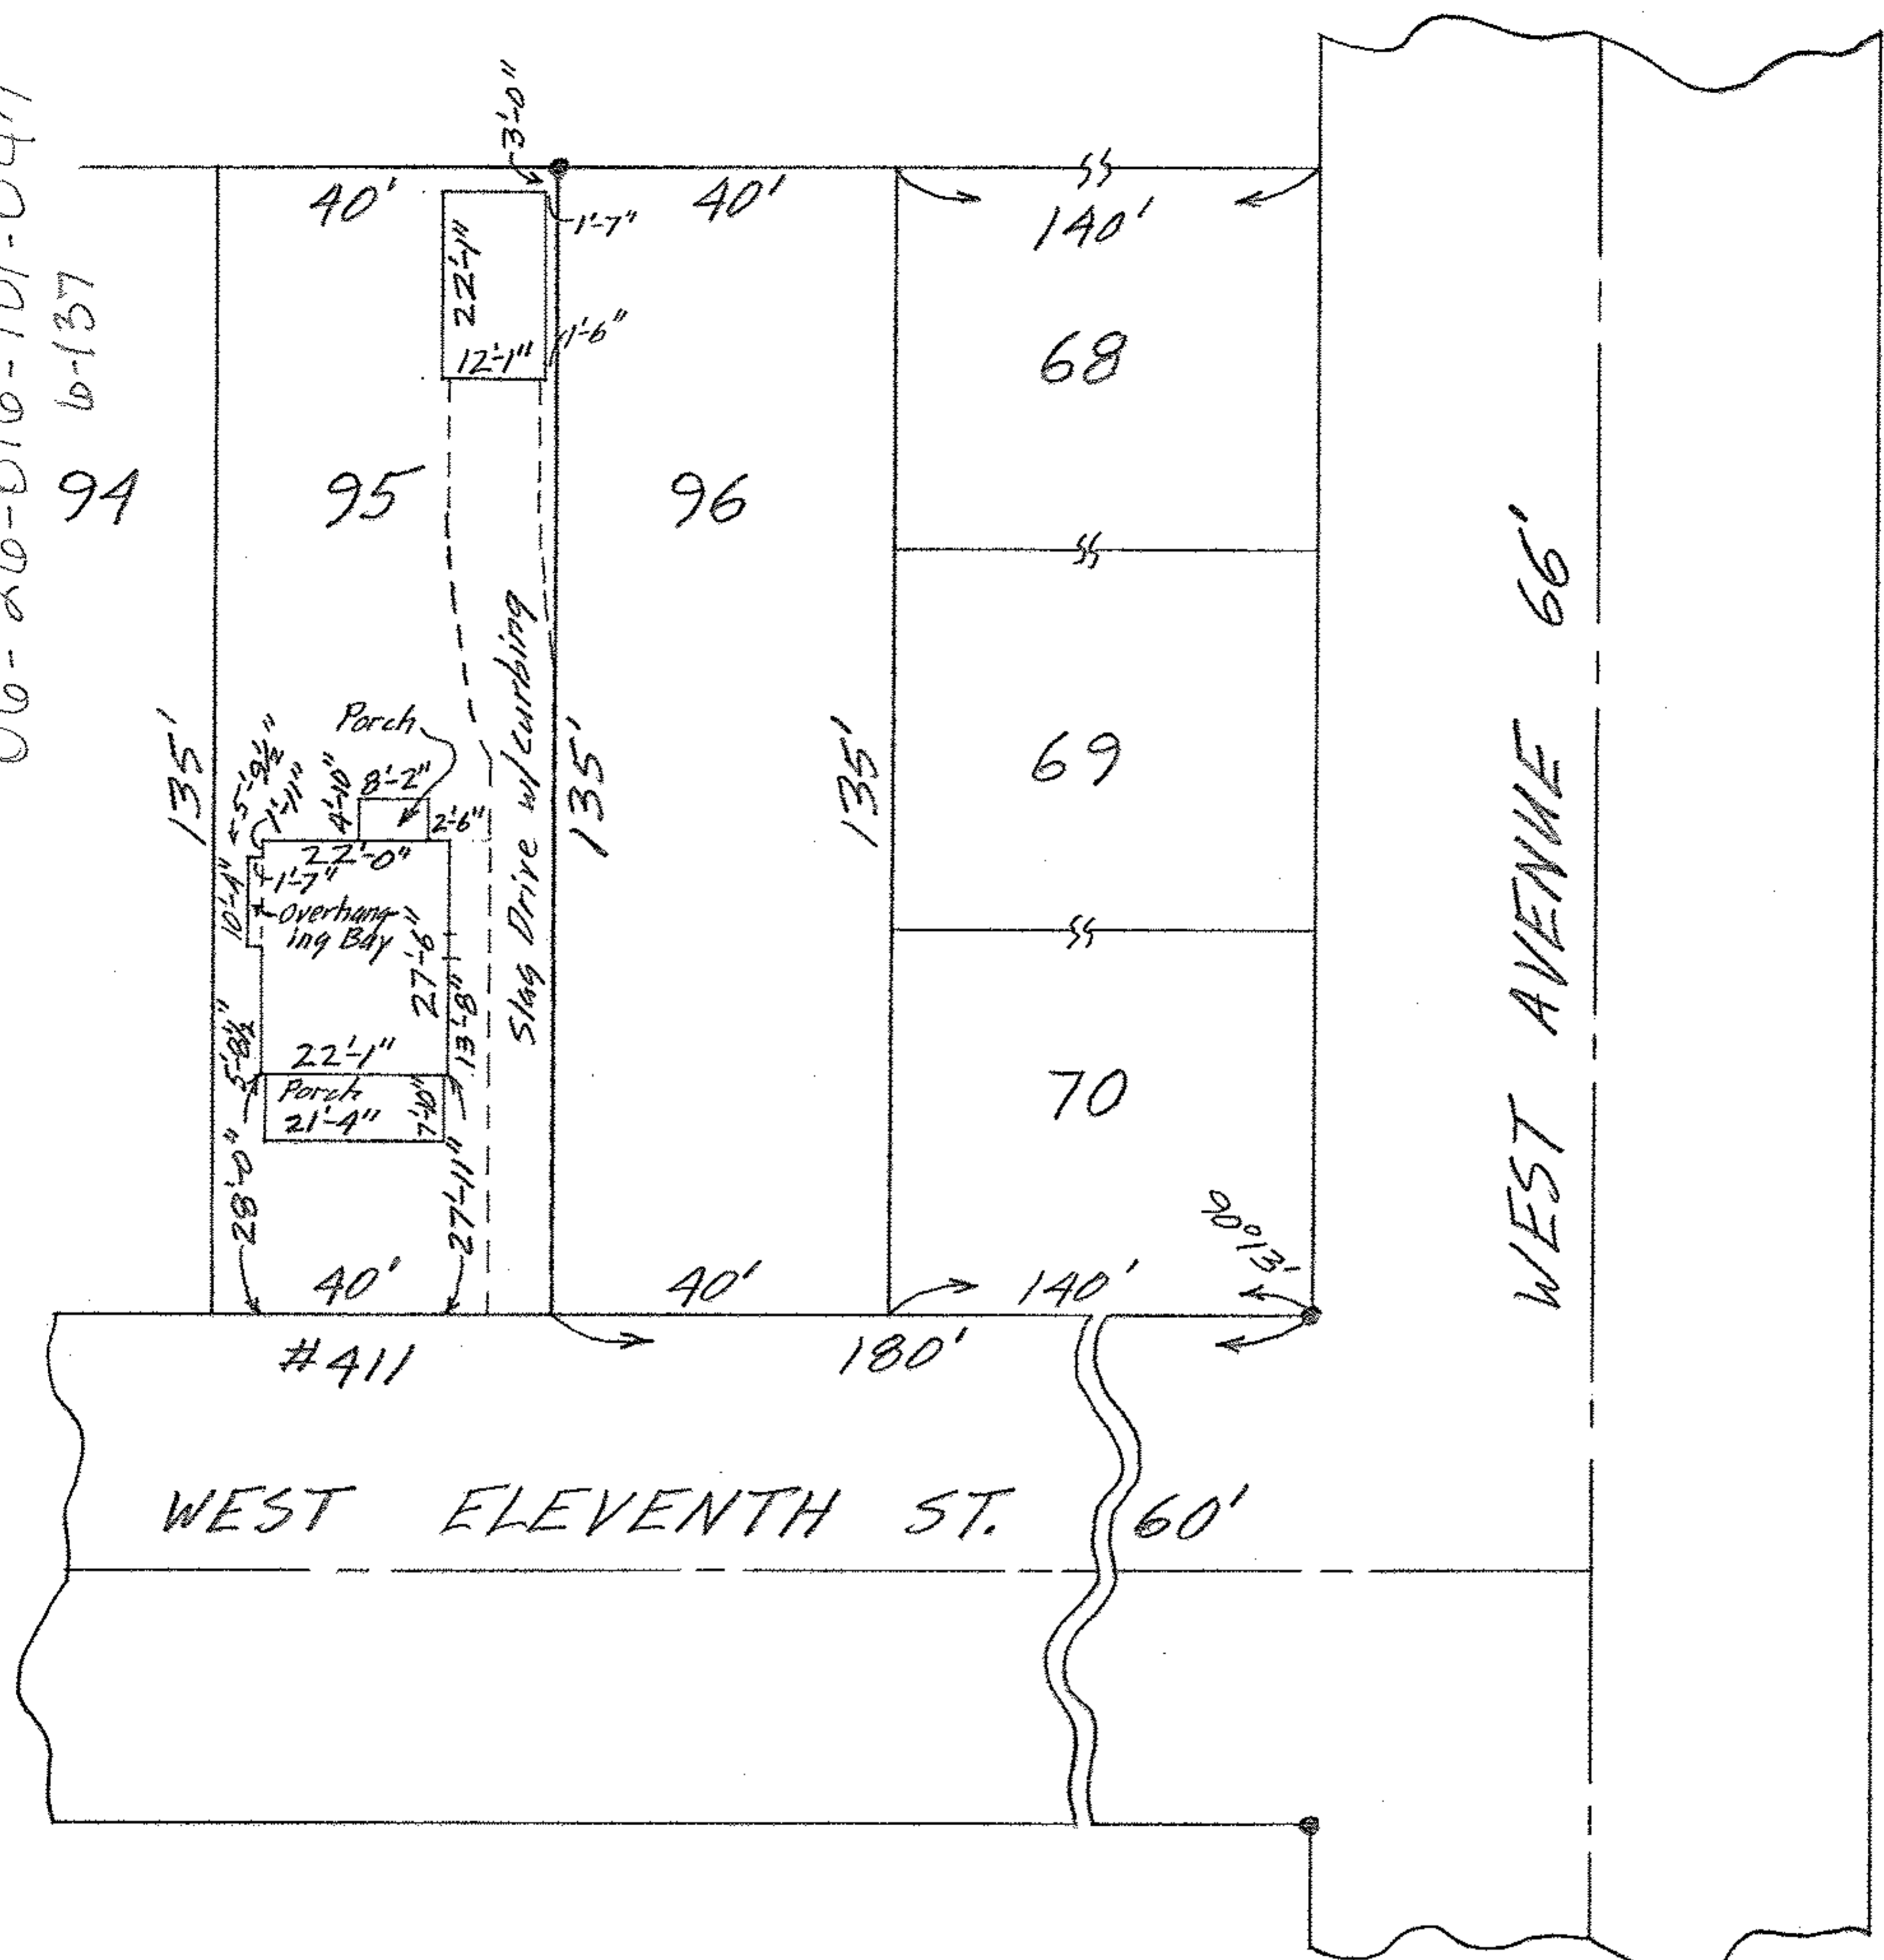

MAP OF SUB-LOT NO. 95 OF THE ELY
 REALTY CO.'S WEST AVENUE ALL'T. NO. 2
 VOL. 9 PG. 24 PLAT RECORDS

O. L. 16 BETWEEN THE BRANCHES ELYRIA TWP.
 ELYRIA CITY LORAIN COUNTY OHIO

SCALE: 1" = 30' APRIL 20-1963 2:15 PM.

Mary E. Penfound REG. SURVEYOR

BERKS TITLE INSURANCE CO. Order No. 1151
 John C. Edwards, Agent