


02-01-003-203-
02-01-003-N
SCAN#
46080

NOTES: ○ indicates iron pin found.
● indicates iron pin set unless otherwise designated.

Gary E. Penfound Reg. Surveyor No. 4457

NORTH RIDGE ROAD 66'

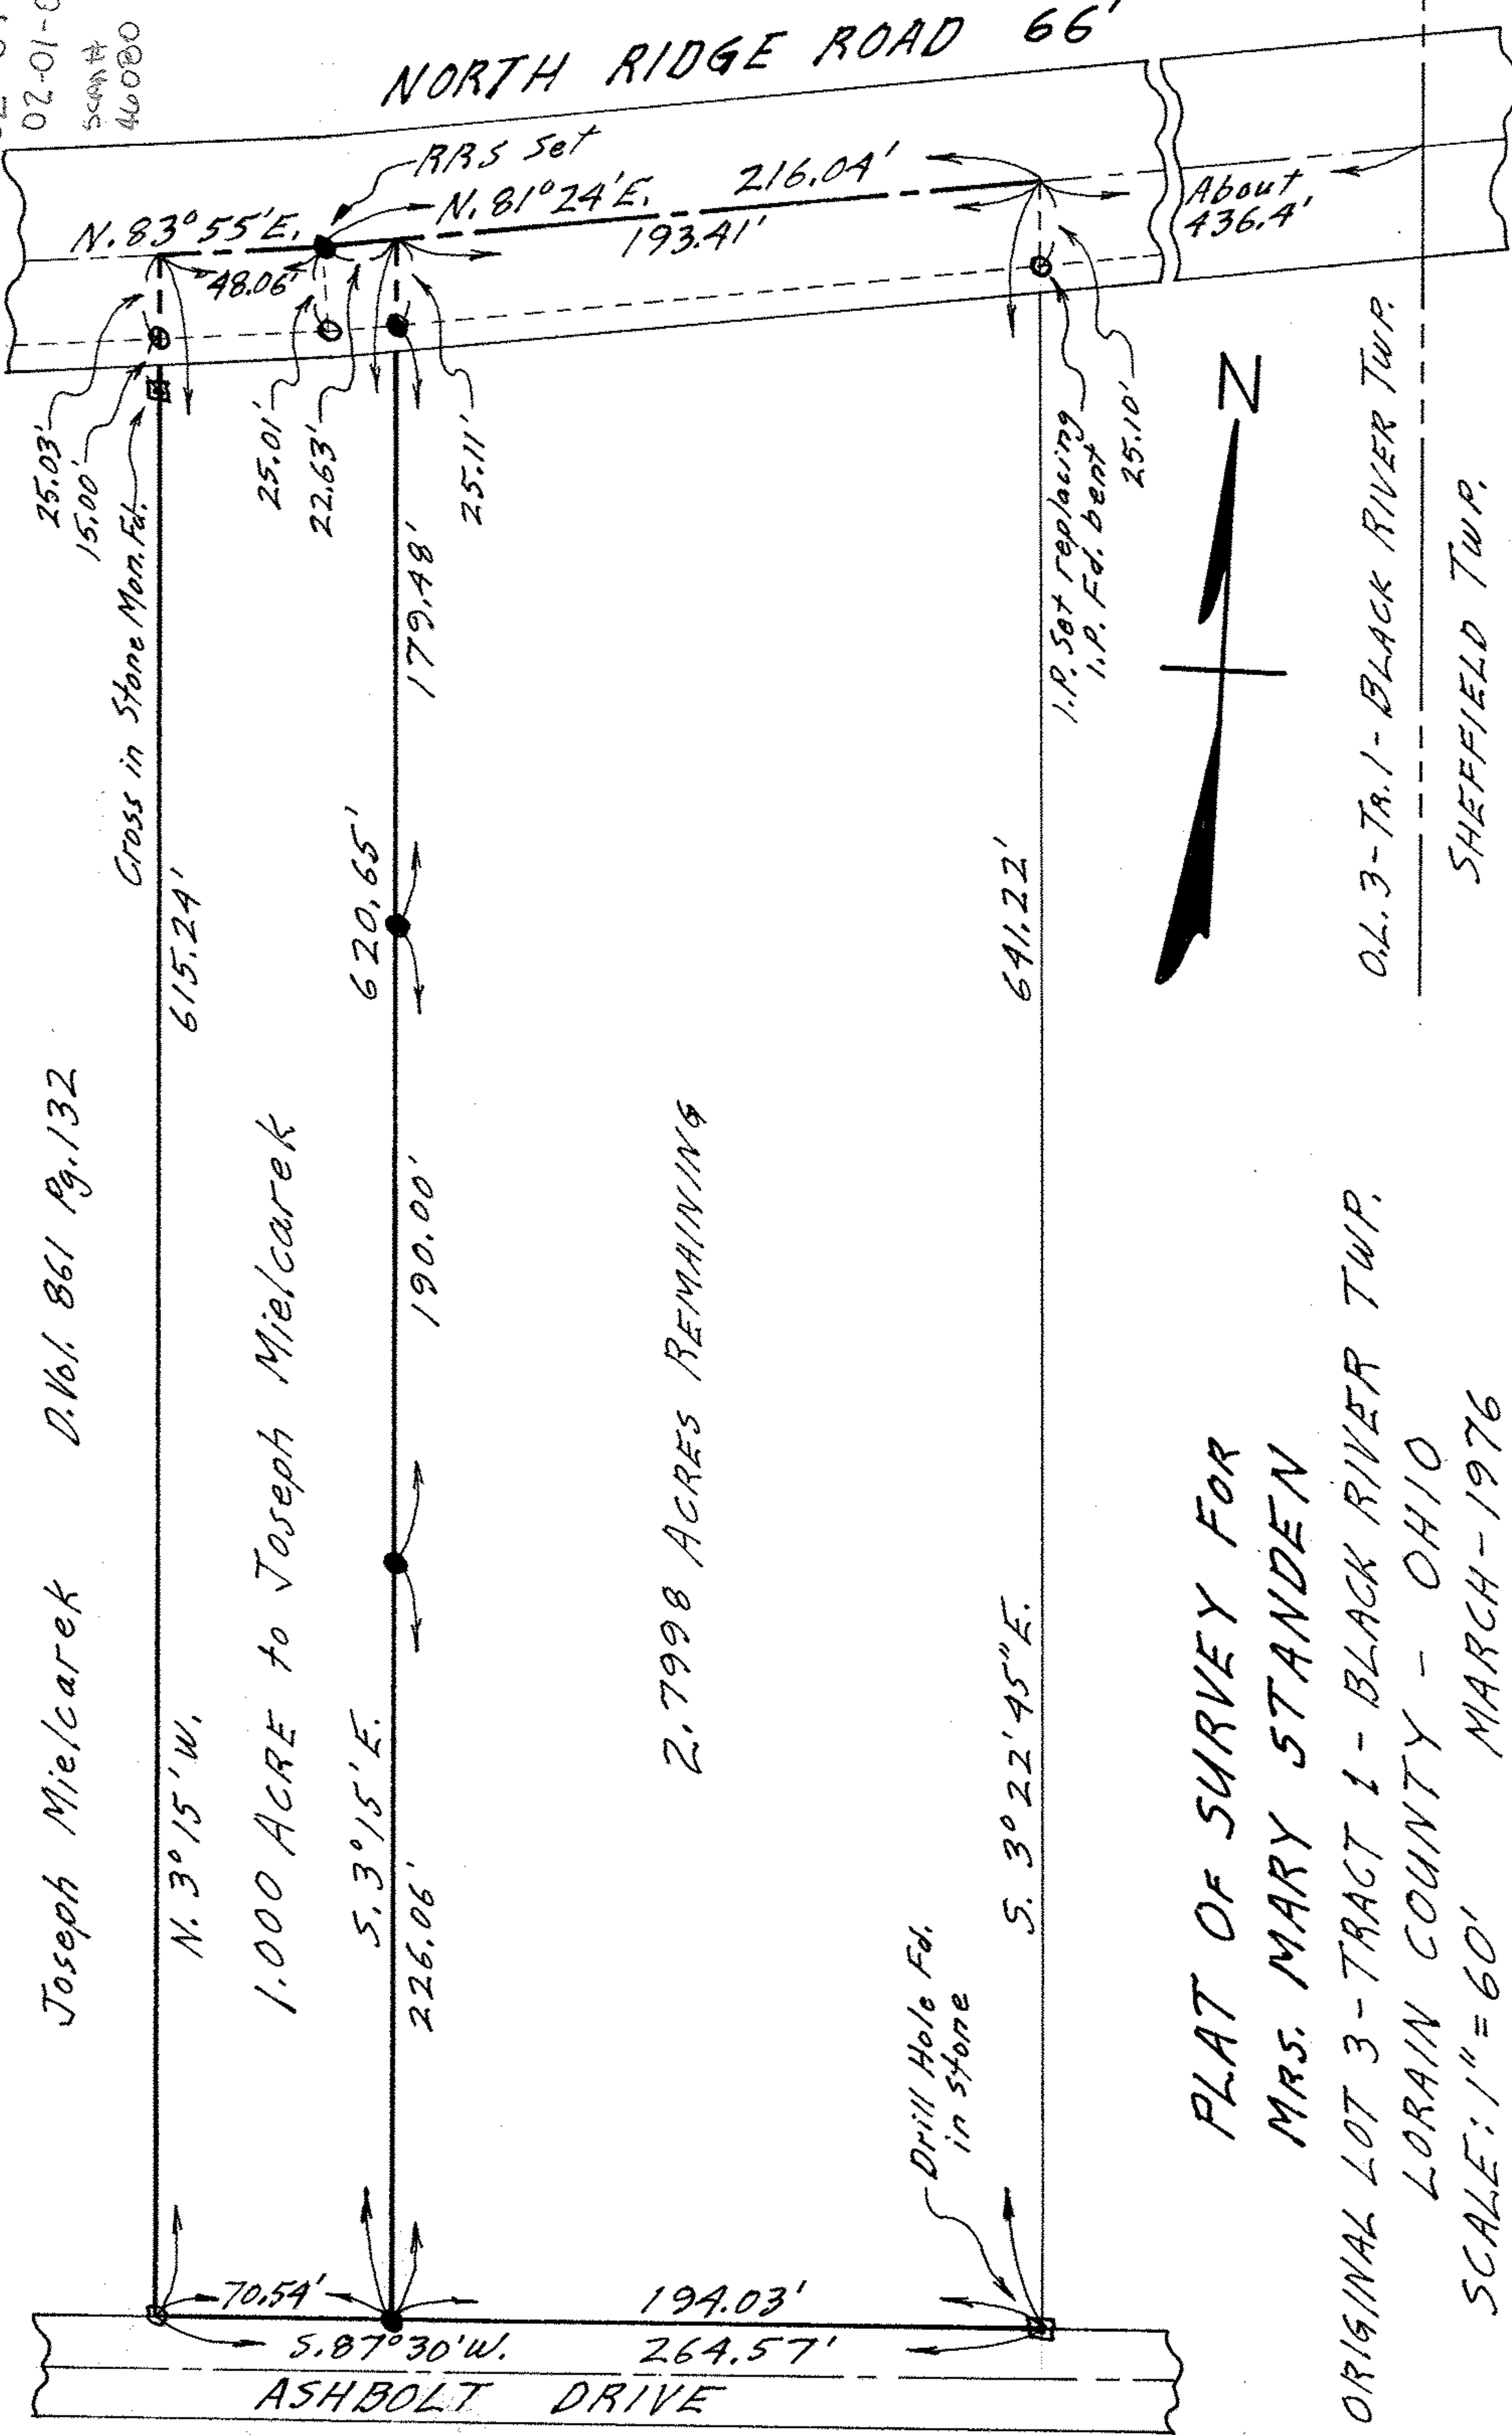

Joseph Mielcarek D. Vol. 861 Pg. 132

1.000 ACRE to Joseph Mielcarek

2.7998 ACRES REMAINING

PLAT OF SURVEY FOR
MRS. MARY STANDEN

ORIGINAL LOT 3 - TRACT 1 - BLACK RIVER TWP.
LORAIN COUNTY - OHIO
SCALE: 1" = 60'
MARCH - 1976

O.L. 3-TR. 1 - BLACK RIVER TWP.

SHEFFIELD TWP.