

07-00-001-000-152 → 154







01/21/03 08:42:06 AM, KRK


CERTIFICATE OF CORRECTION FOR RIDGEFIELD HOMES SUBDIVISION NO. 7 AS RECORDED IN VOLUME 73, PAGES 13-16 L.C.M.R.

THE LINE LEGEND ON SHEET 2 OF 4 OF THE ABOVE REFERENCED PLAT IS SHOWN AS:

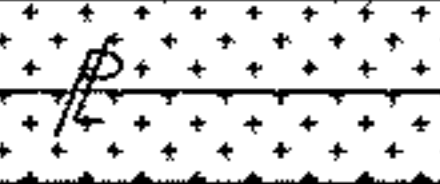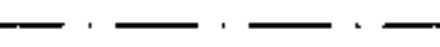THE SANITARY SEWER EASEMENT SHOWN ON SHEET 3 OF 4 OF THE ABOVE REFERENCED PLAT SHALL BE CORRECTED AS SHOWN HEREON IN GRAPHIC SYMBOL (|||||/|||||).




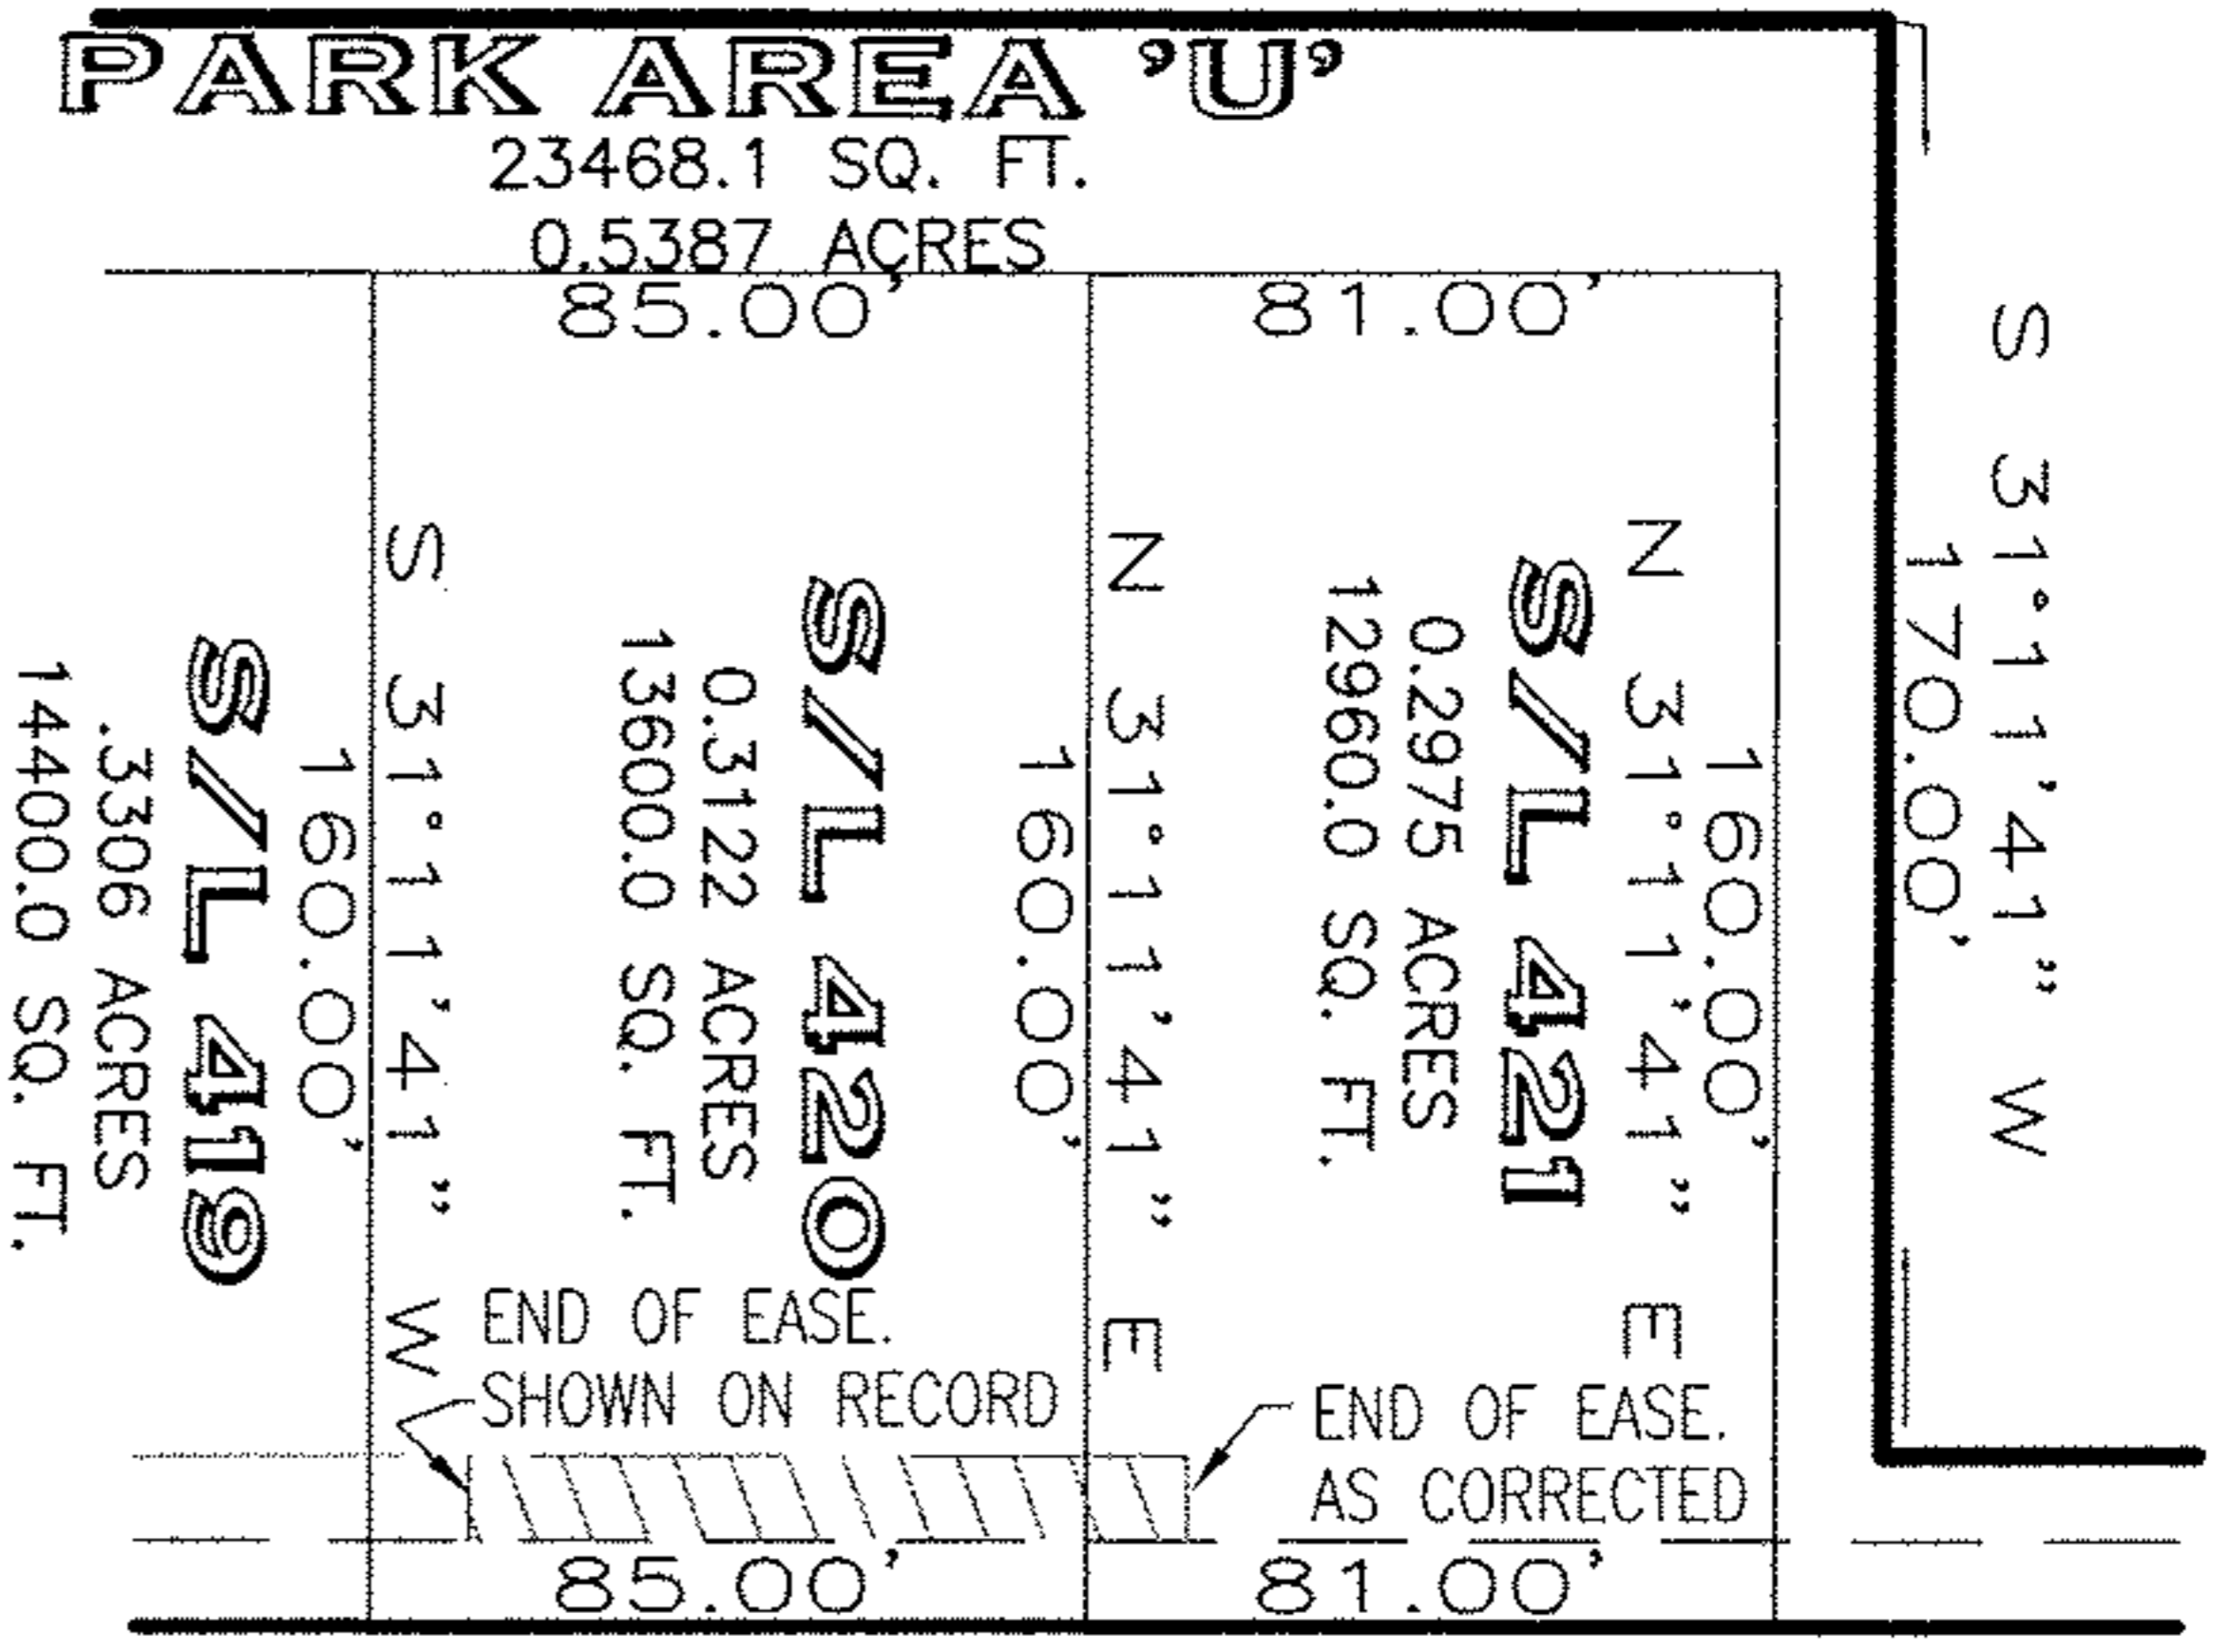


LINE LEGEND

	10'	= 20' STORM SEWER EASEMENT (TYPICAL)
		= UNDERGROUND UTILITY EASEMENT
		= SANITARY SEWER EASEMENT
		= IRON PIN SET
		= IRON PIN FOUND
		= I.P. MON. TO BE SET AT TIME OF CONSTRUCTION

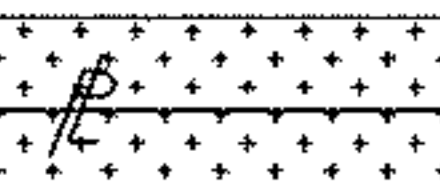

THE LINE LEGEND ON SHEET 2 OF 4 OF THE ABOVE REFERENCED PLAT SHALL BE REVISED TO:

LINE LEGEND

	6'	= 12' STORM SEWER EASEMENT (TYPICAL)
		= UNDERGROUND UTILITY EASEMENT
		= SANITARY SEWER EASEMENT
		= IRON PIN SET
		= IRON PIN FOUND
		= I.P. MON. TO BE SET AT TIME OF CONSTRUCTION



GATESTONE ROAD 60'

MACKAY

Engineering & Surveying Company
7017 Pearl Road, Cleveland, Ohio 44130
(440) 886-4500 (440) 886-4590 Fax

Richard R Mackay
RICHARD R. MACKAY, P.S. 4195
21 JAN. 2003
DATE

