


**MAP of SURVEY**

PREPARED FOR TOM SIGSWORTH

PART of ORIGINAL RIDGEVILLE TWP LOT 14  
 CITY of NORTH RIDGEVILLE, LORAIN COUNTY, OHIO

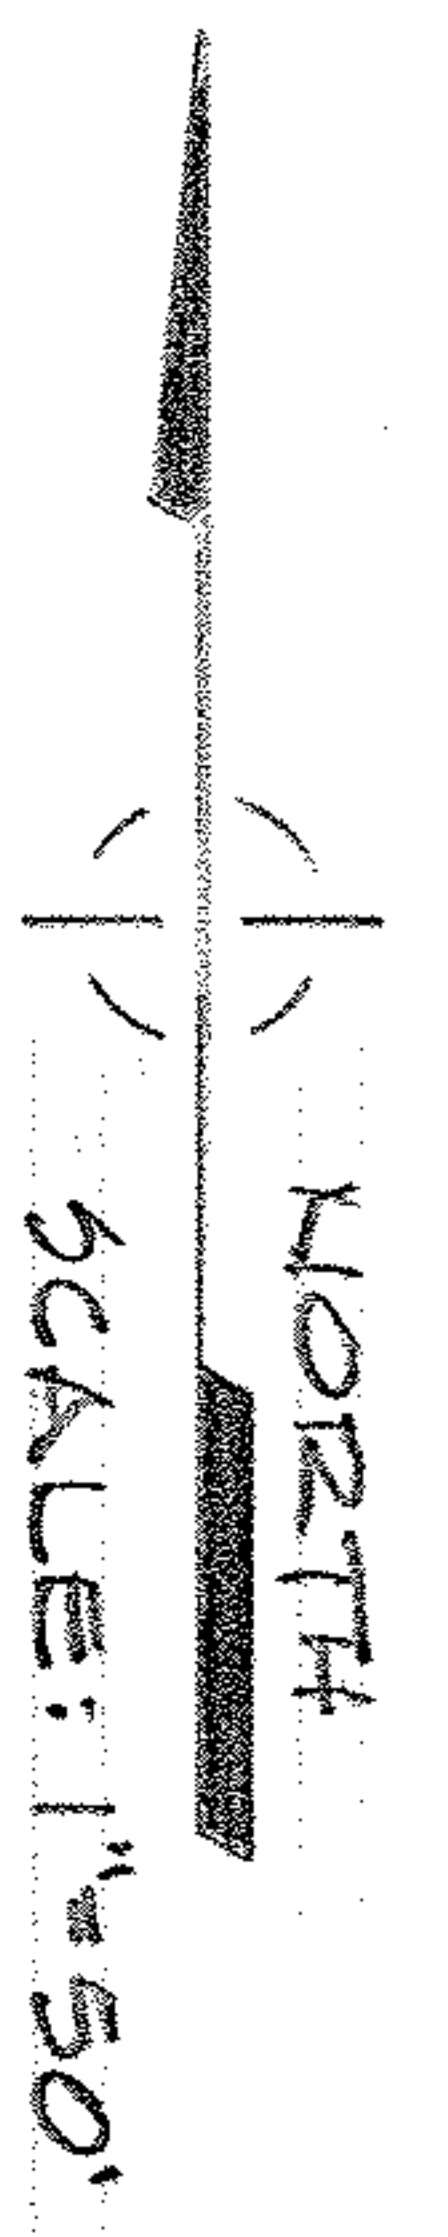

MCGLINCHY and ASSOCIATES INC.  
 PROFESSIONAL ENGINEER & SURVEYORS  
 110 1/2 MIDDLE AVE. ELYRIA, OHIO  
 SEPTEMBER, 1980 #806445