



07-00-017-105-017-018
Z 07-00-017-C
SCAN # 46205

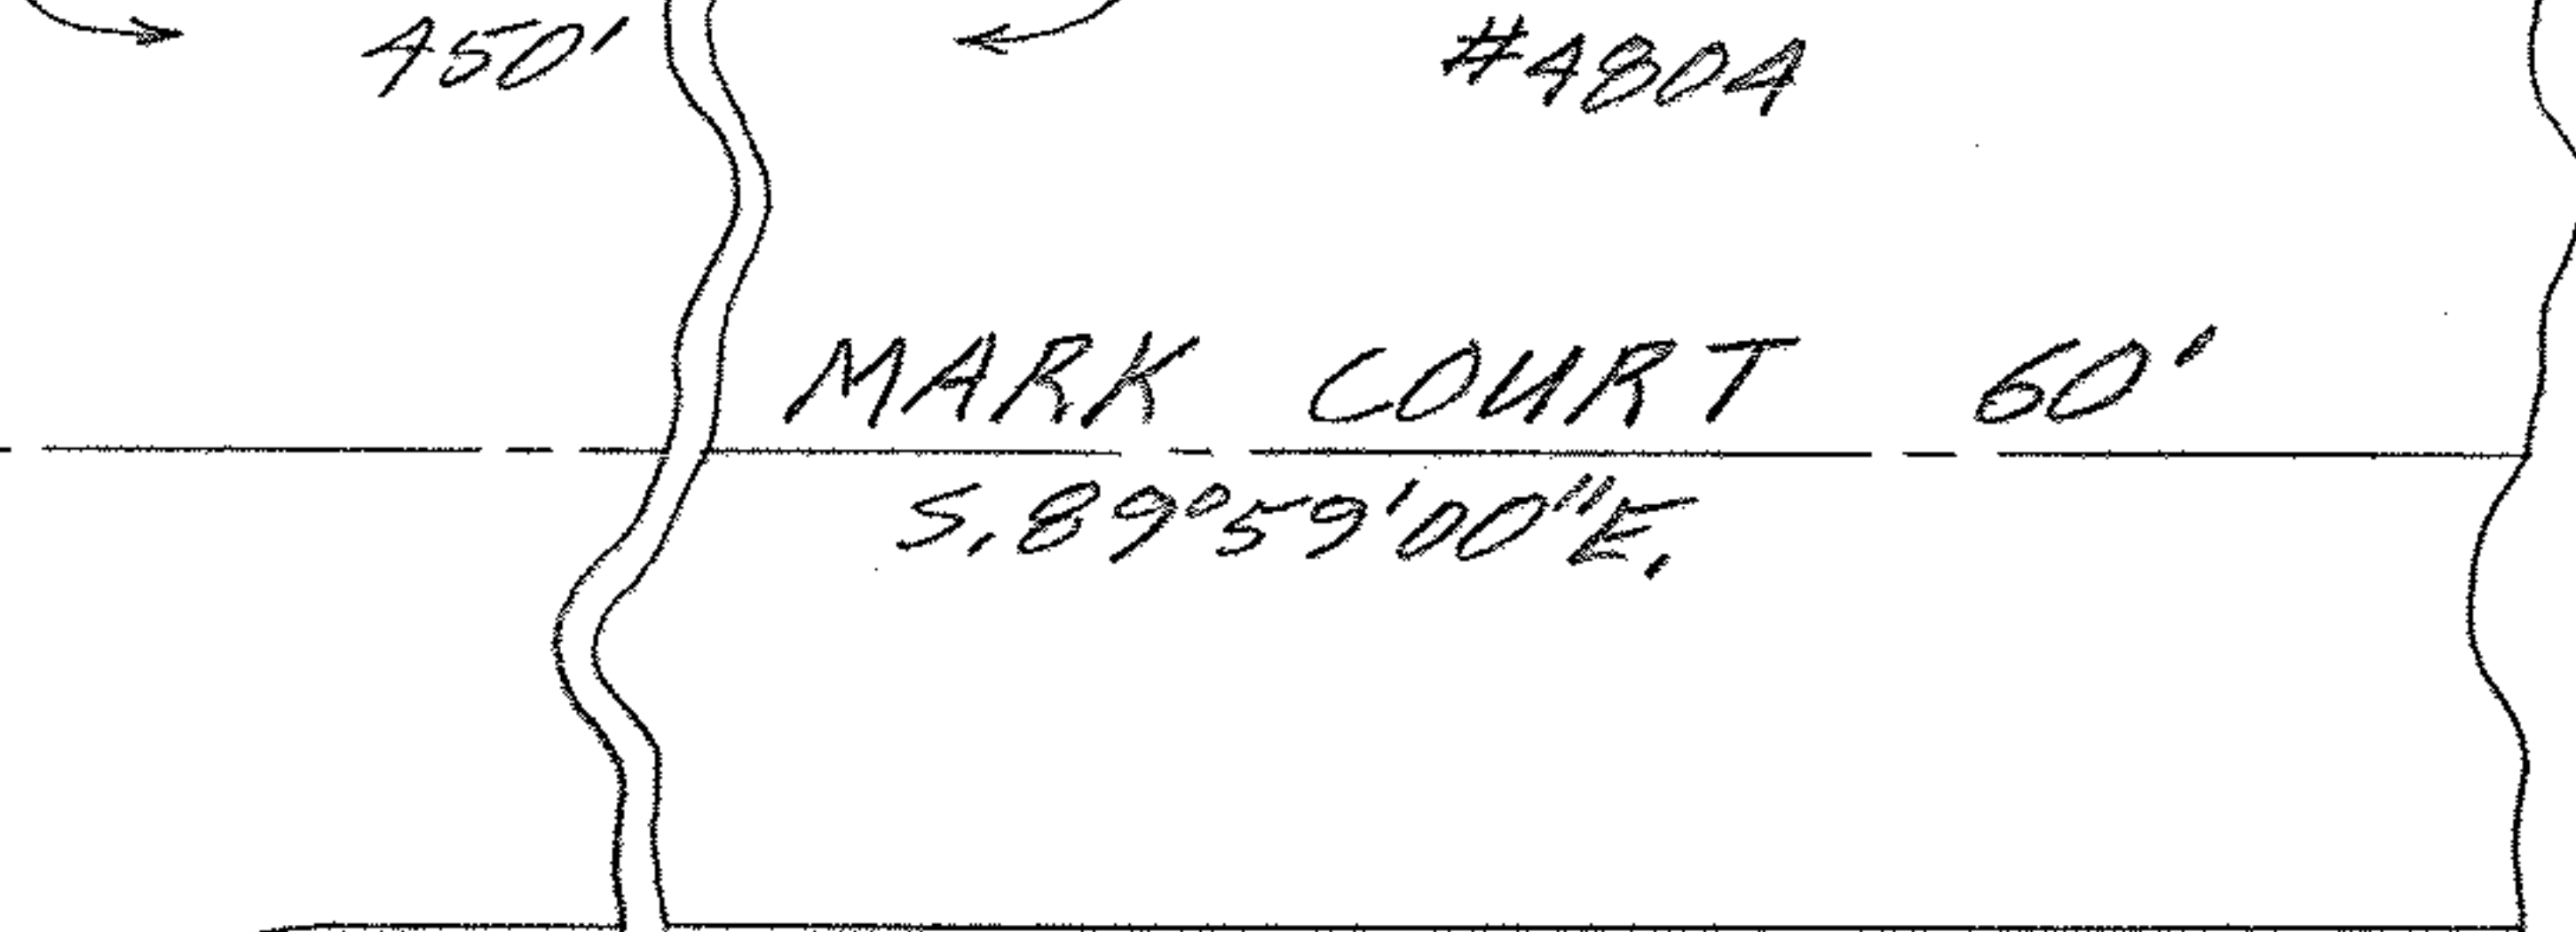

PAULA BOULEVARD 60'
N. 0° 01' 00" E.

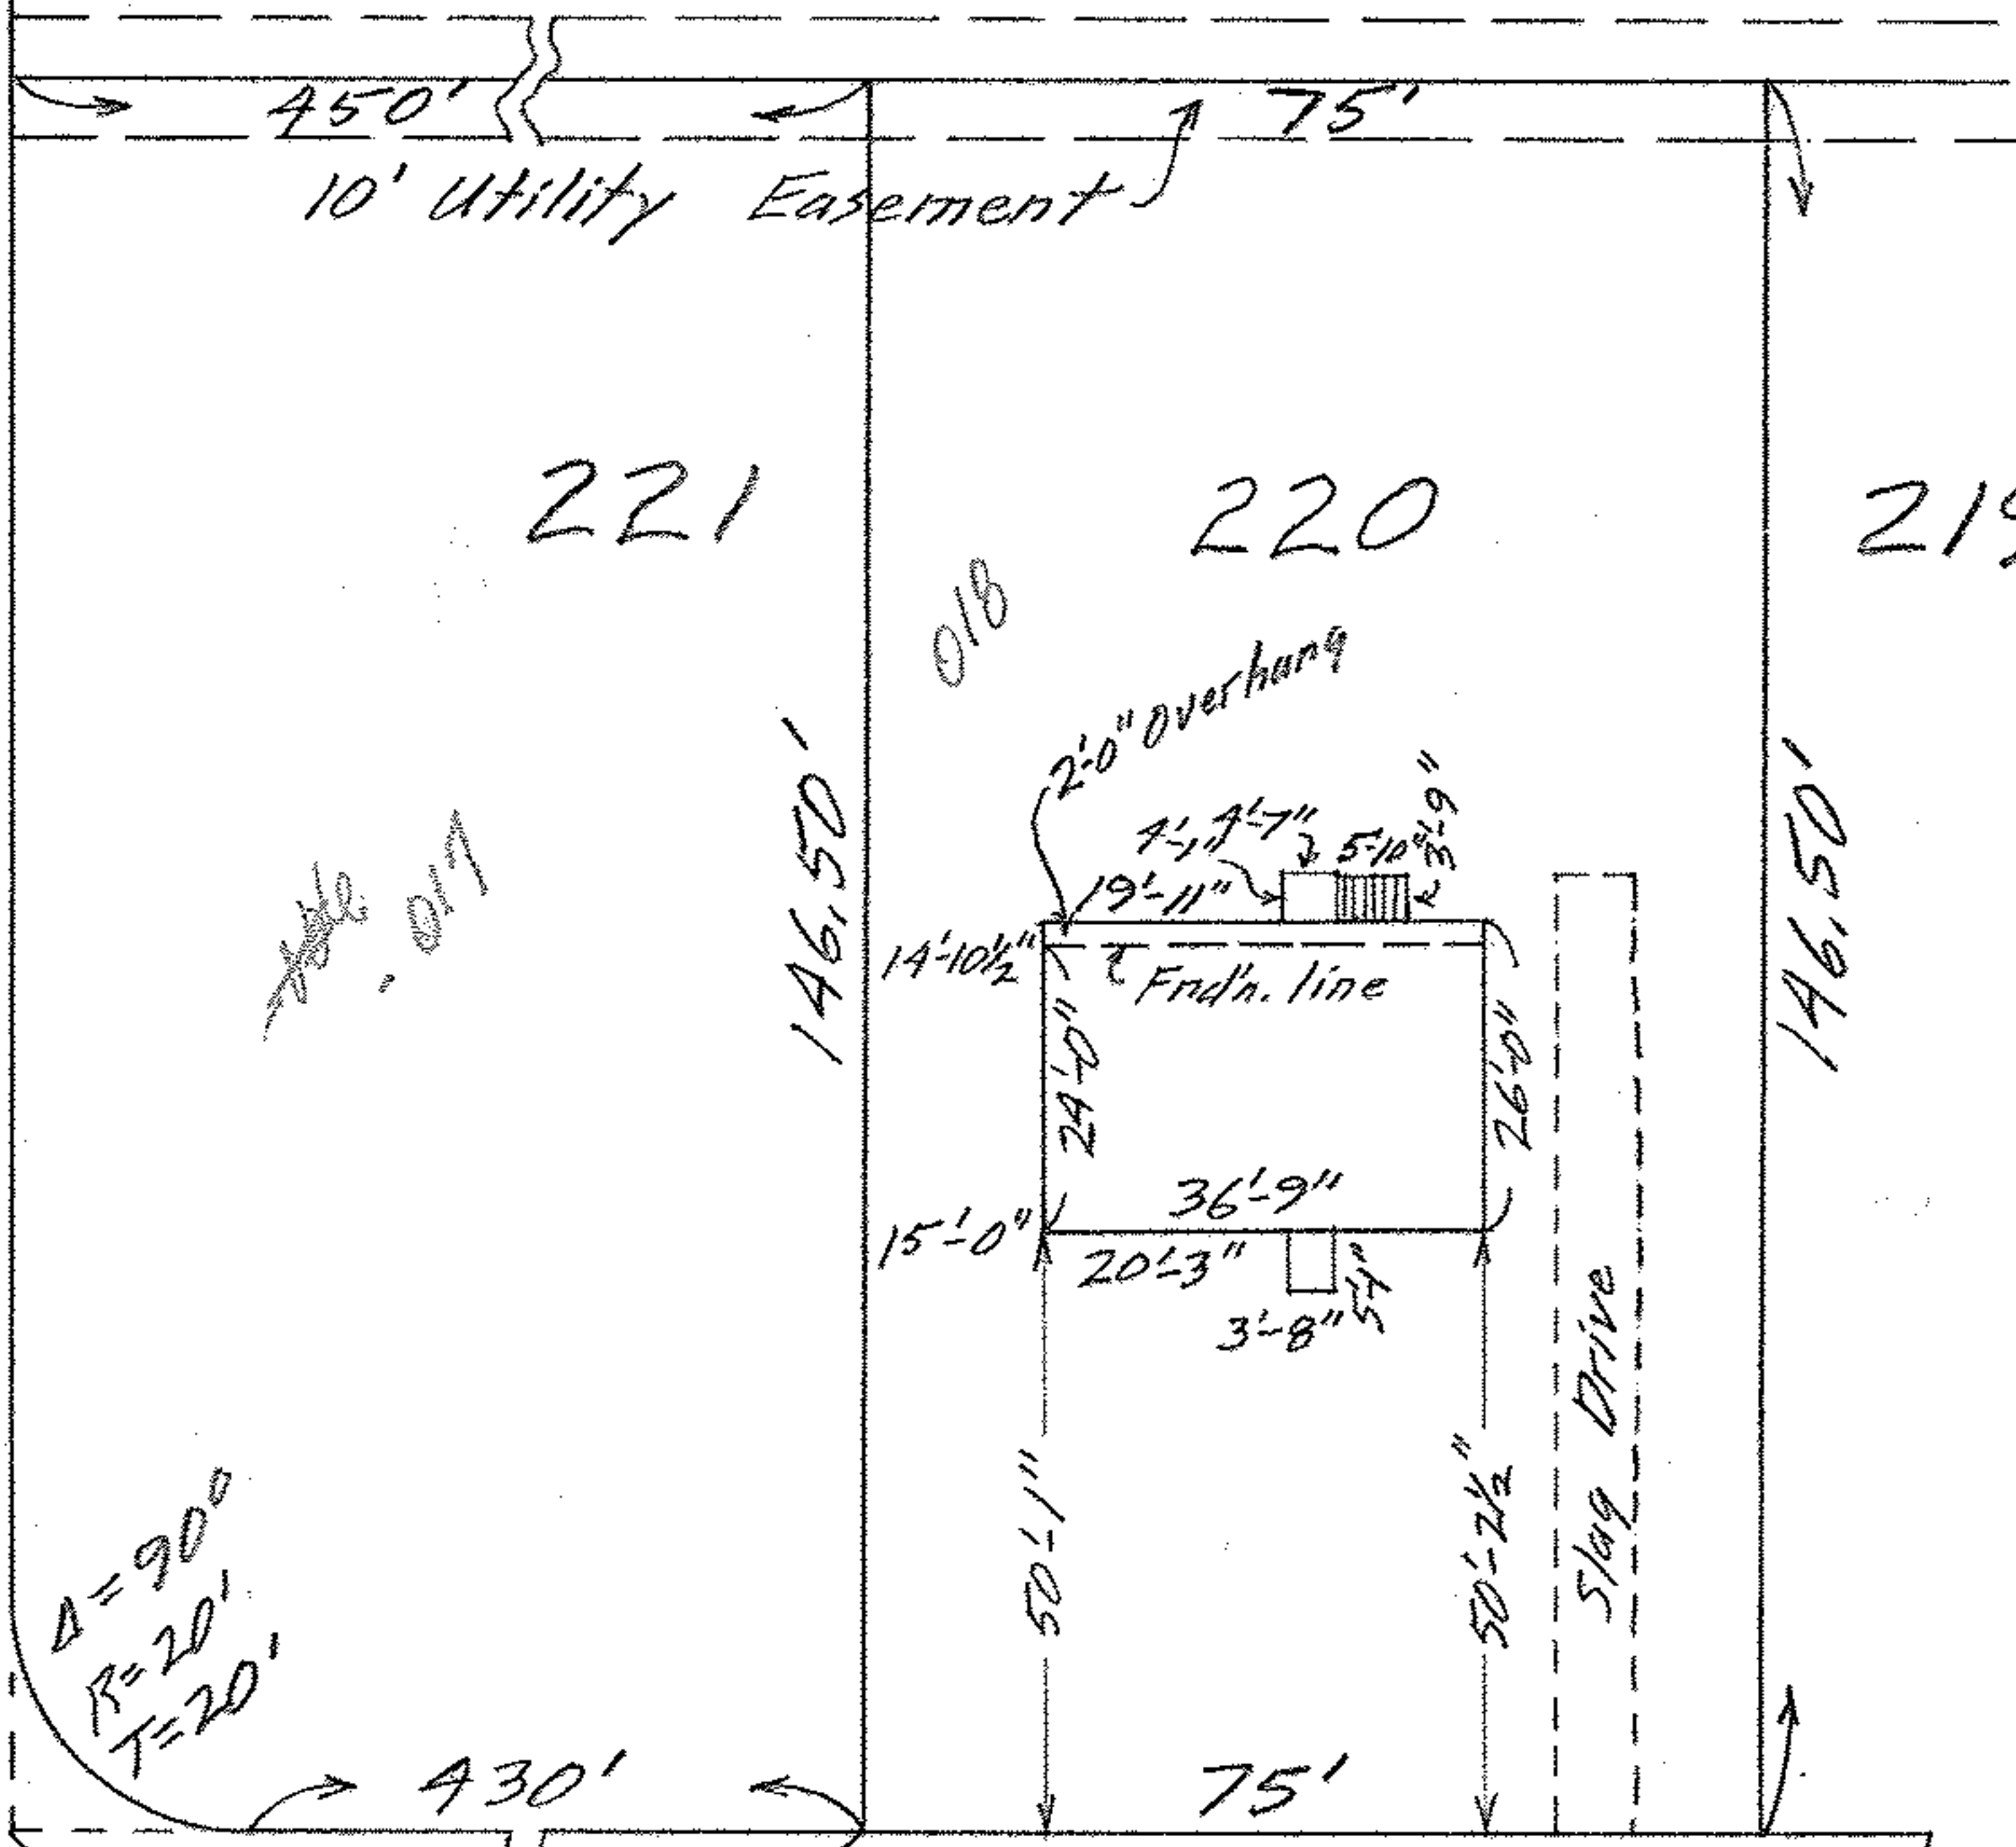

MAP OF SUB-LOT NO. 220
RIDGEVILLE PARK SUB'N. VOL. 20 Pg. 20
ORIG. LOT 17 RIDGEVILLE TWP.
NORTH RIDGEVILLE CITY
LORAIN COUNTY OHIO

SCALE: 1" = 30' JULY 23-1963 4:45 P.M.

Gary E. Perfound REG. SURVEYOR

Clarence D. & Anna Mae Fugate W W

07-00-017-105-017-018