


07-00-017-115-059, 010
 07-00-017-B
 Scan # 46209

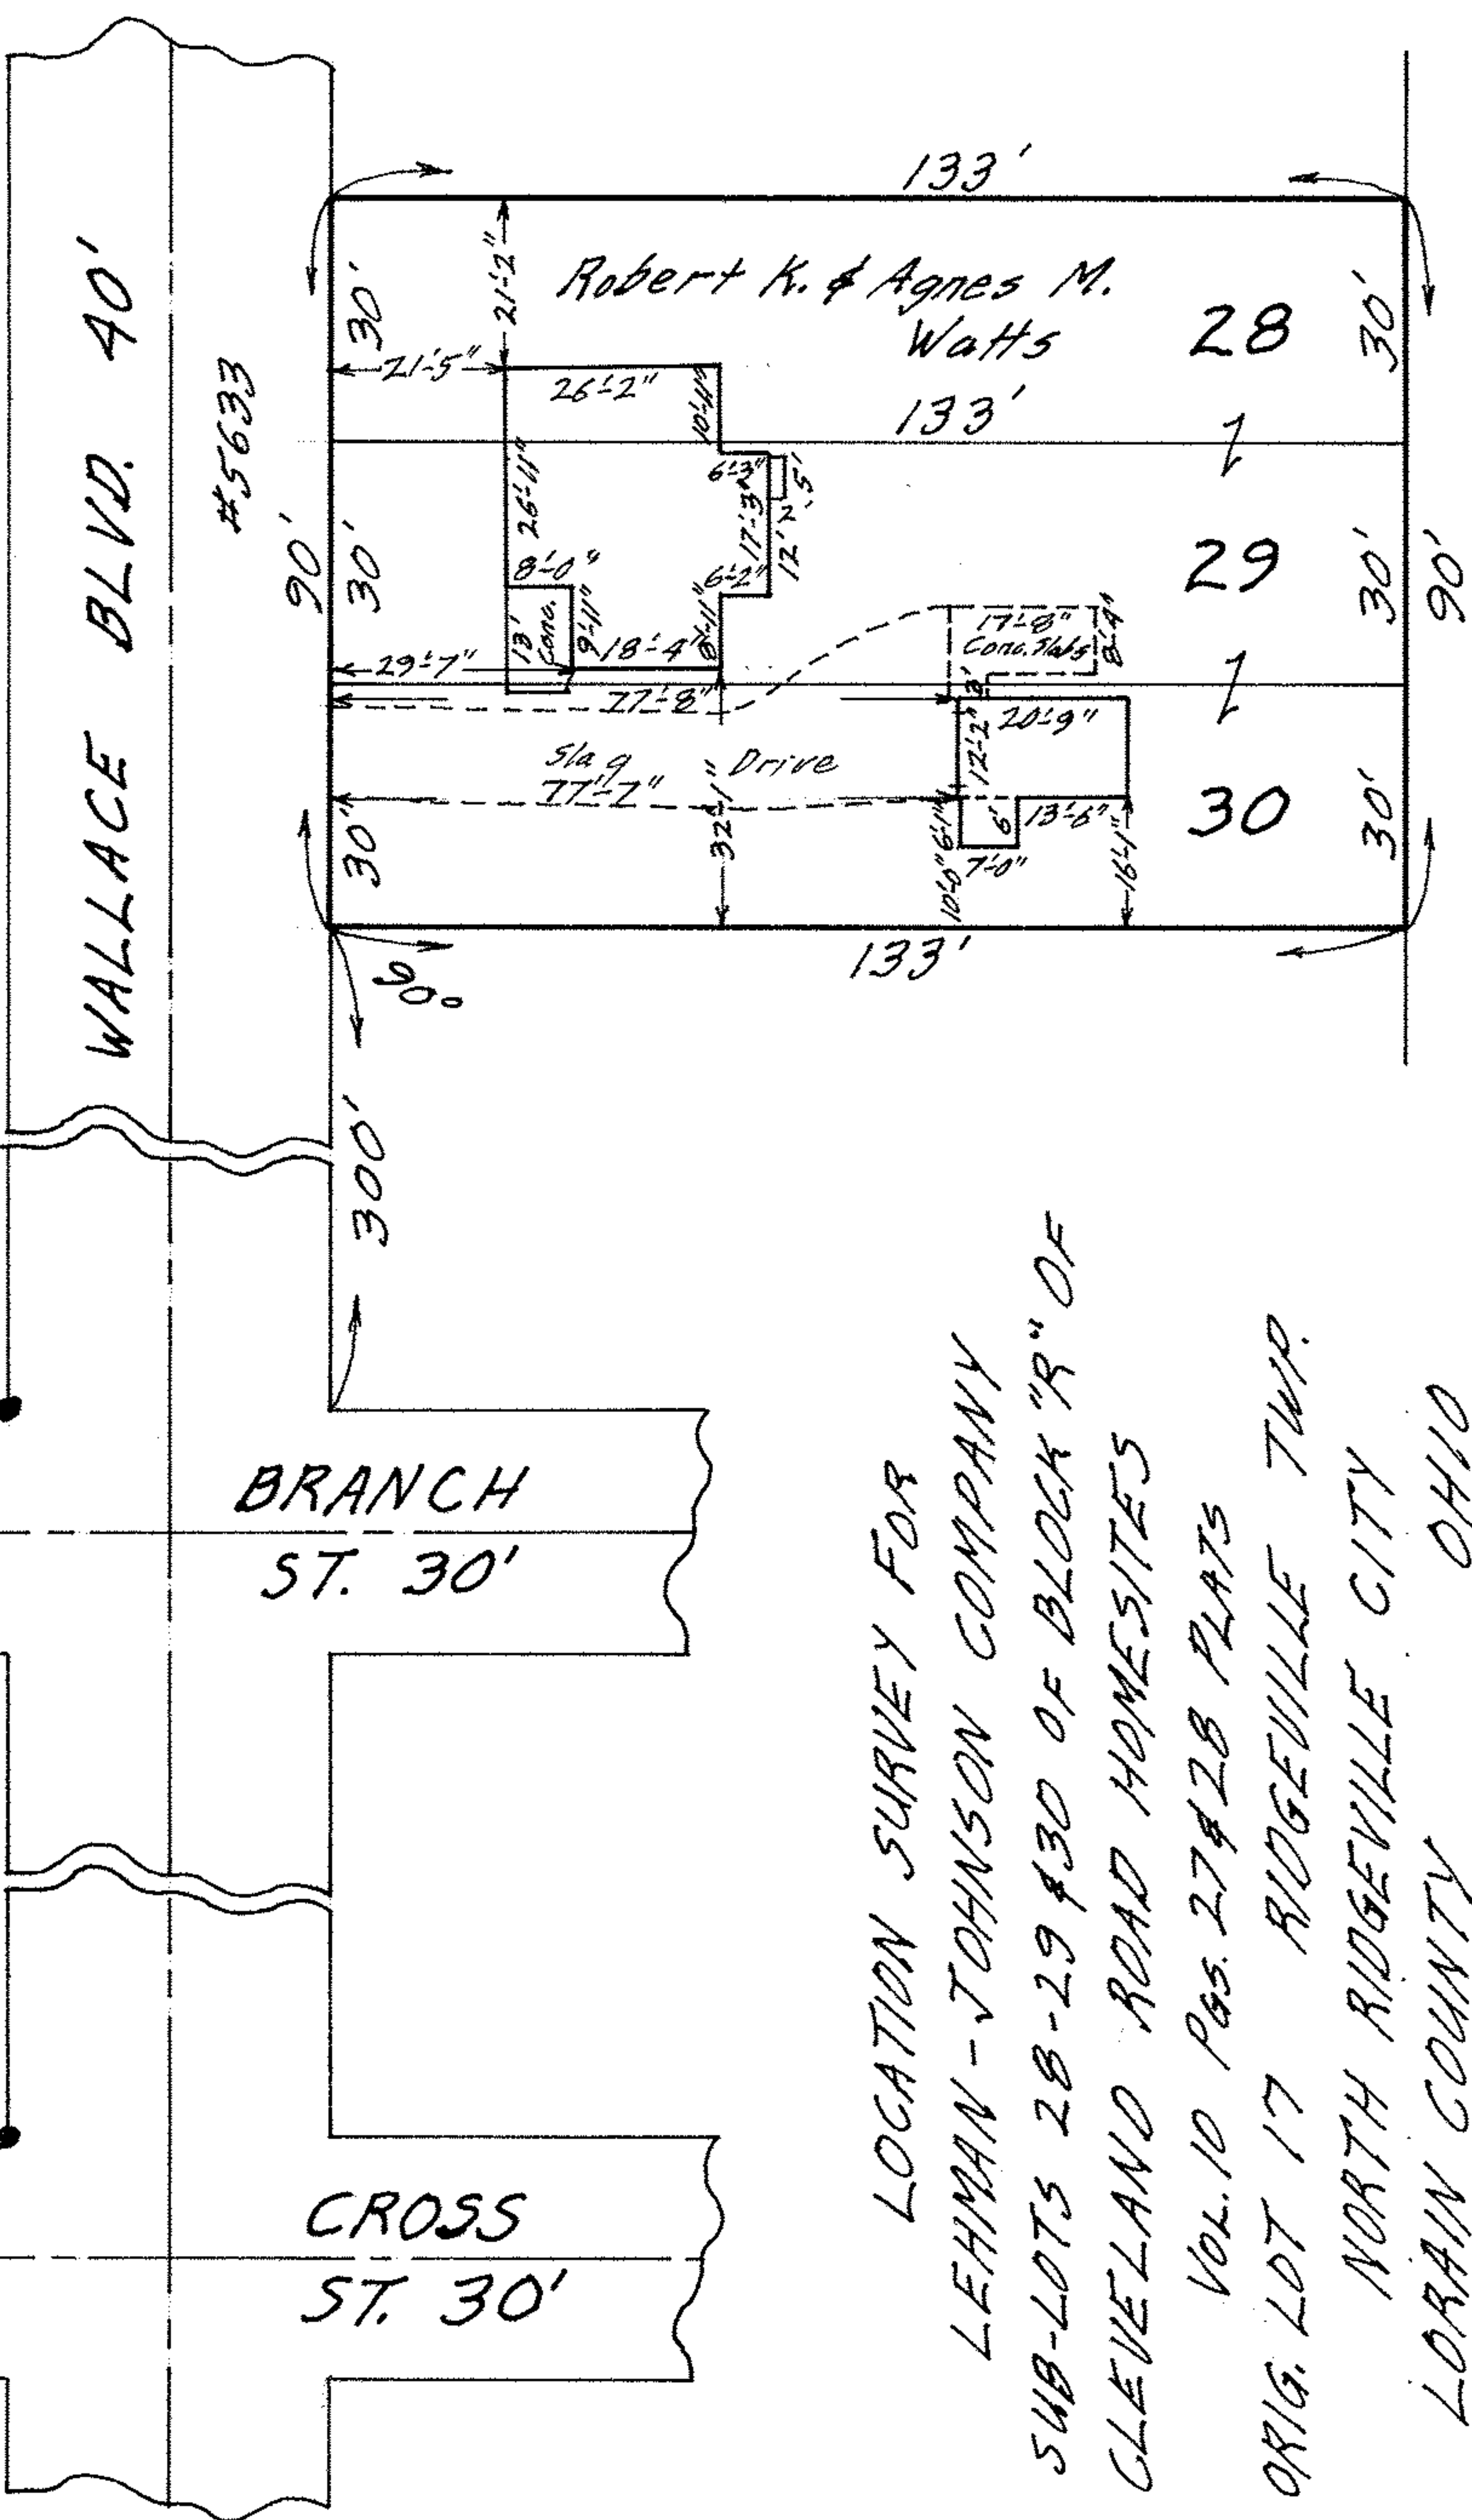

LOCATION SURVEY FOR
 LEHMAN - JOHNSON COMPANY
 SUB-LOTS 28-29 & 30 OF BLOCK "R" OF
 CLEVELAND ROAD HOMESITES
 VOL. 10 PGS. 27 & 28 PLATS
 ORIG. LOT 17 RIDGEVILLE TWP.
 NORTH RIDGEVILLE CITY
 LORAIN COUNTY OHIO
 SCALE: 1" = 30' MAR. 9 - 1969 1:30 P.M.
 Gary E. Penfound REG. SURVEYOR