


07.00.025.104. 222  
 028.  
 07-00-025-B  
 SCAN# 46236



HEDGEROW PARK DR.-60'

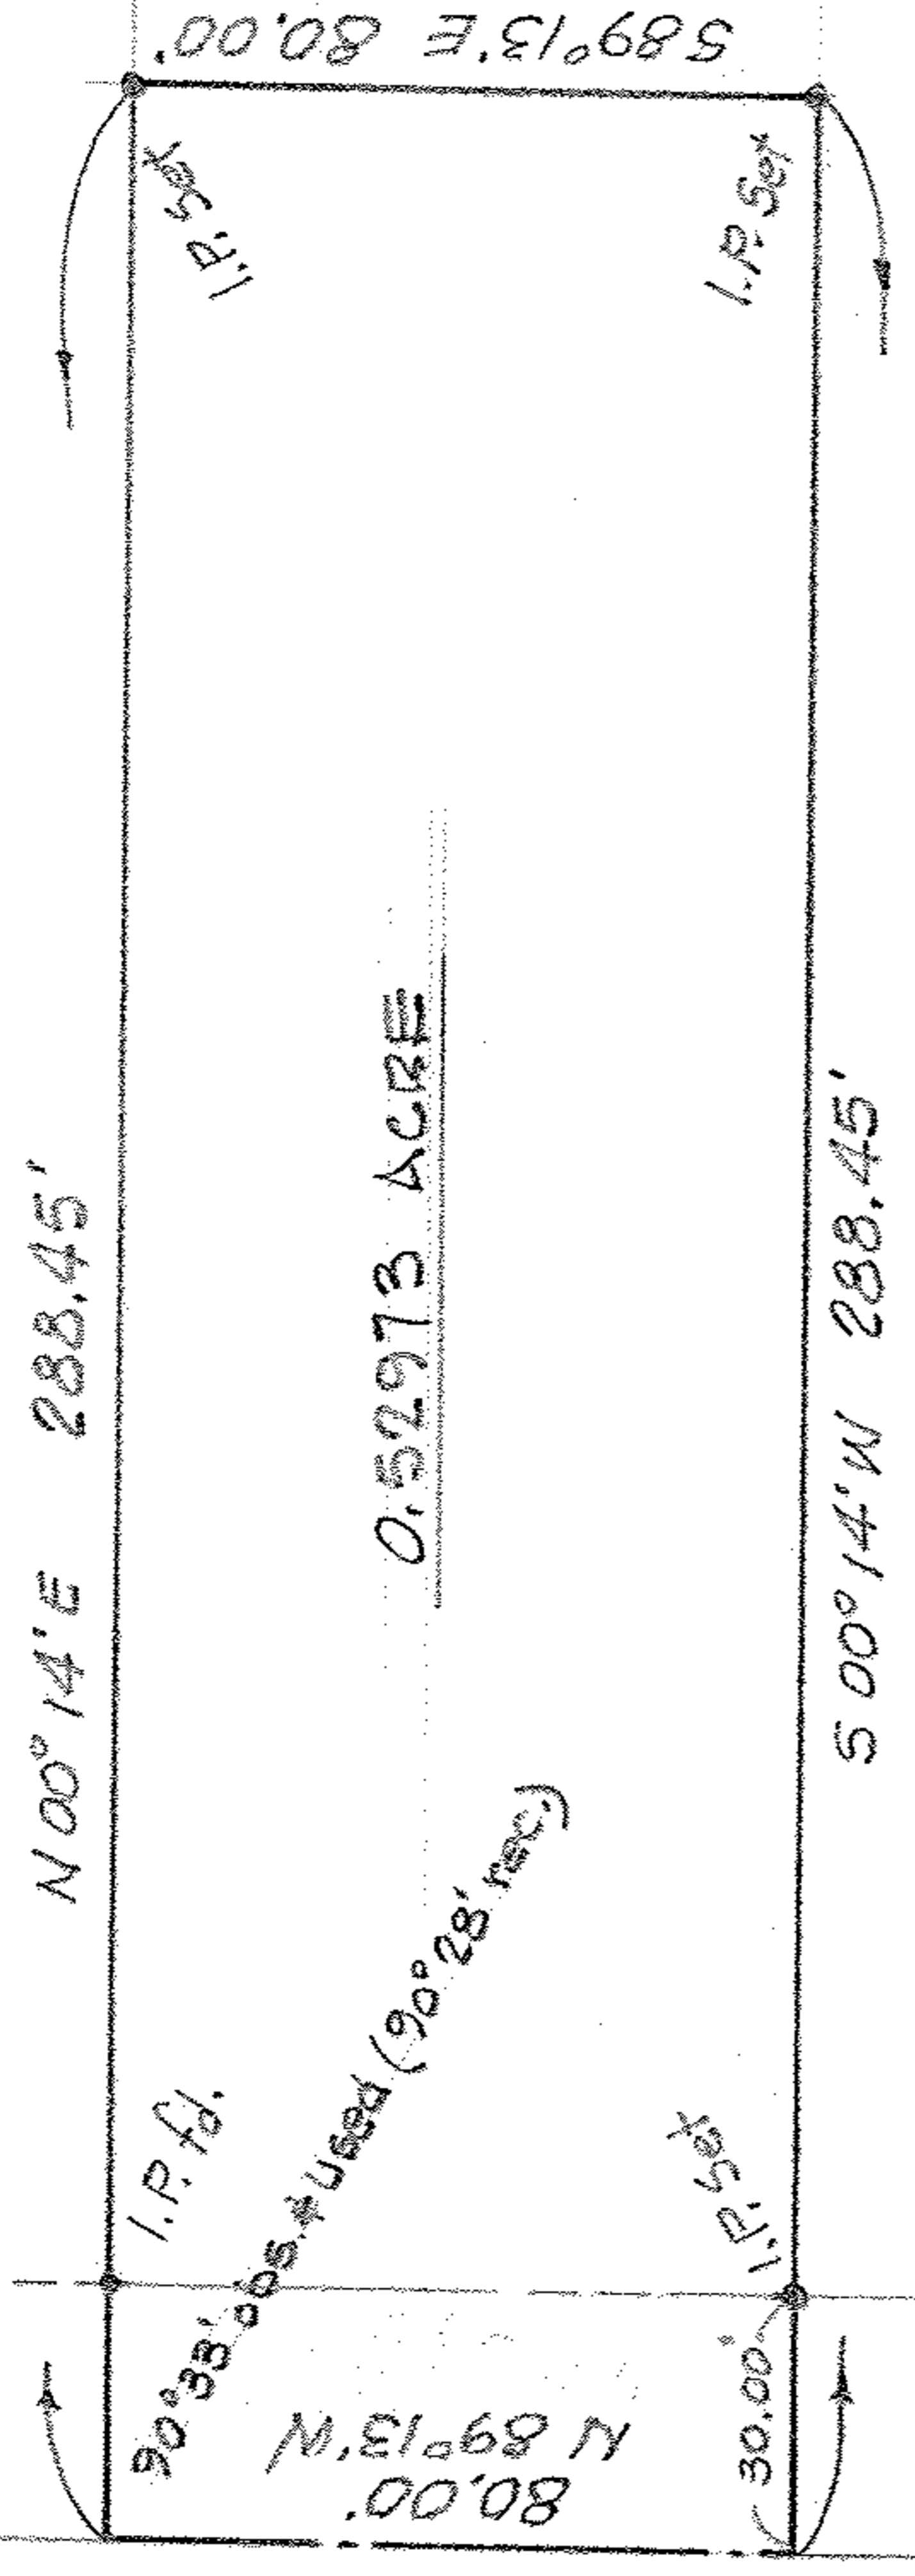

MAP of SURVEY

PREPARED FOR NOLAN SAMPLES  
 SUBLOT # 45, HEDGEROW PARK ALLOTMENT  
 PLAT VOLUME 16, PAGE 2  
 PART of ORIGINAL RIDGEVILLE TWP LOT 25  
 CITY of NORTH RIDGEVILLE, LOBBAIN CO., OHIO

McGILINCHY and ASSOCIATES INC.  
 PROFESSIONAL ENGINEER & SURVEYORS  
 ELVIRA OHIO  
 MAY, 1979 #795241