


PLAT OF SURVEY FOR
JIM ROGALA

ORIGINAL LOT 45 - RIDGEVILLE TOWNSHIP
NORTH RIDGEVILLE CITY - LORAIN COUNTY - OHIO

GARY E. PEMFOUND Reg. Surveyor No. 4457

SCALE: 1" = 60' JUNE - 1978

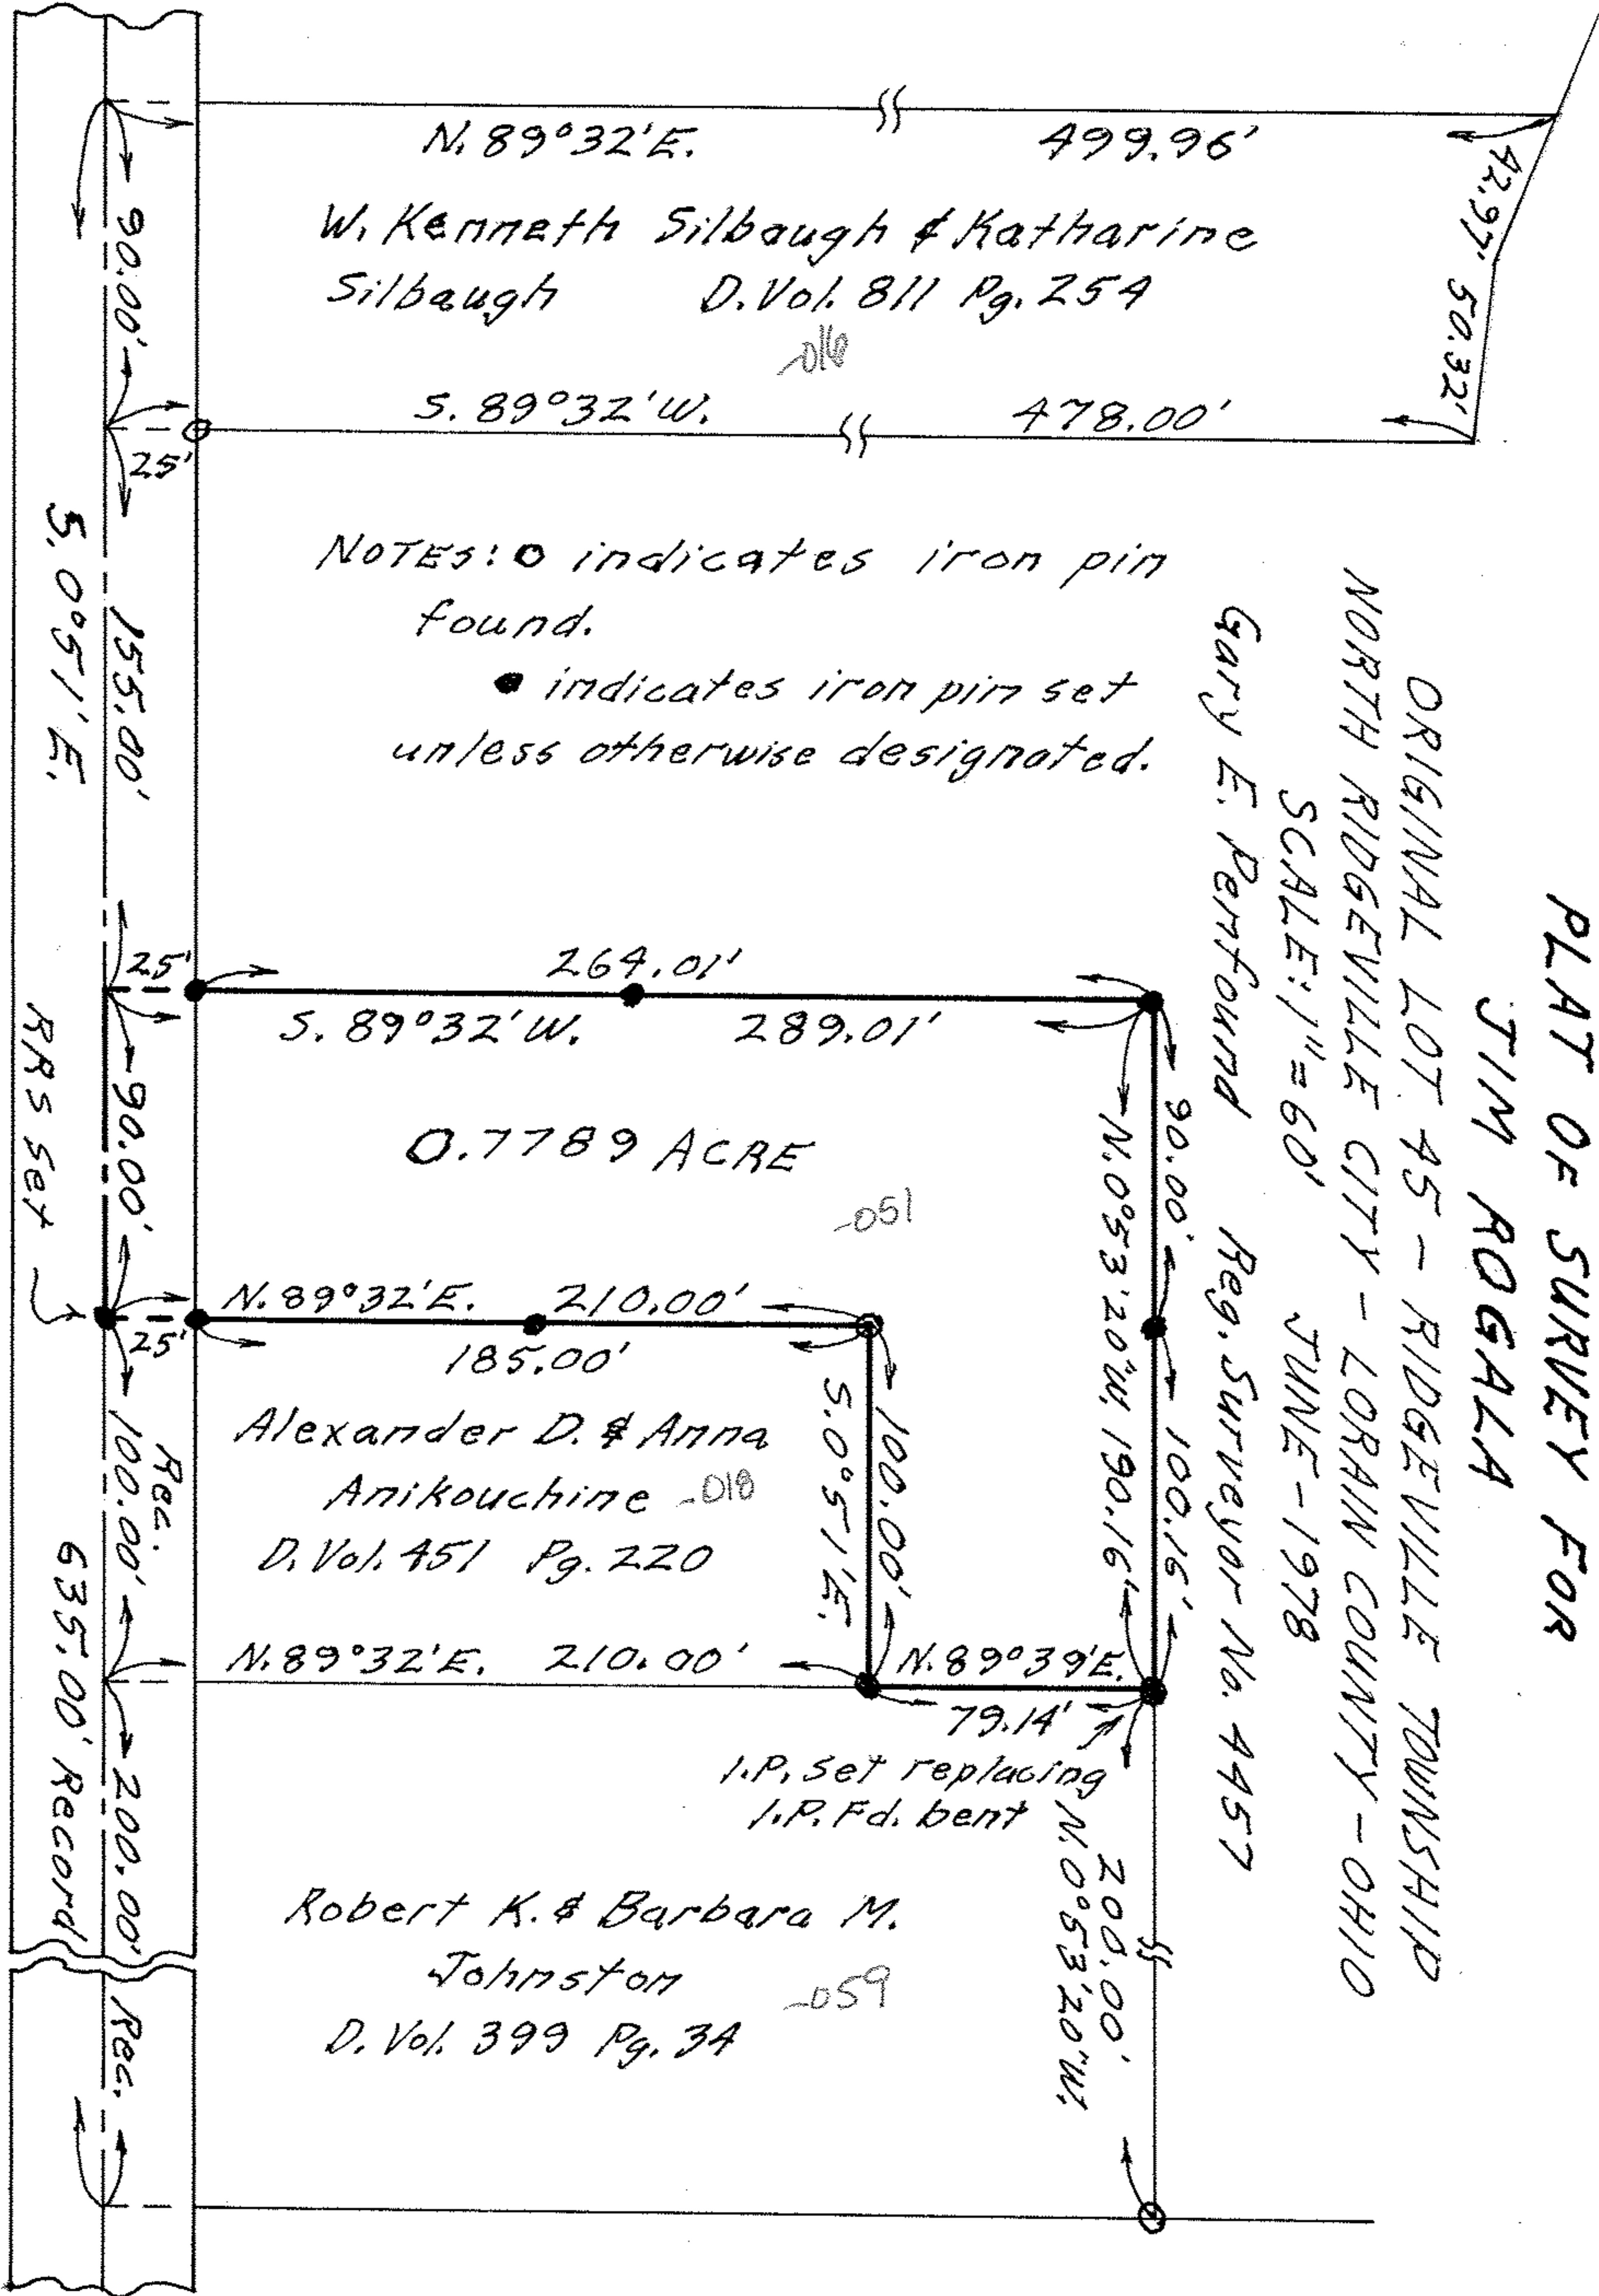

NOTES: ○ indicates iron pin found.
● indicates iron pin set unless otherwise designated.

Alexander D. & Anna Anikouchine
D. Vol. 451 Pg. 220

Robert K. & Barbara M. Johnston
D. Vol. 399 Pg. 3A

N
650' 150' 810' 910' 570' 00' 110'
5 CAN. # 46307
07-00-045-D

CASE ROAD
RRS set