



BEARINGS ARE TO AN ASSUMED MERIDIAN AND ARE USED TO DENOTE ANGLES ONLY.



SCALE IN FEET  
SCALE: 1"=100'

- - 5/8" CAPPED REBAR SET
- ⊙ - IRON PIN/PIPE FOUND
- Ⓜ - MONUMENT BOX FOUND

- R - RECORD
- C - CALCULATED

**APPROVED**  
**LORAIN CO.**  
**MAP DEPT.**


DATE 8-6-99

PAGE 07-00 047

BY D. Holland

NO. AFTER 99 00175

PREPARED BY  
**KS ASSOCIATES, INC.**  
ENGINEERS SURVEYORS

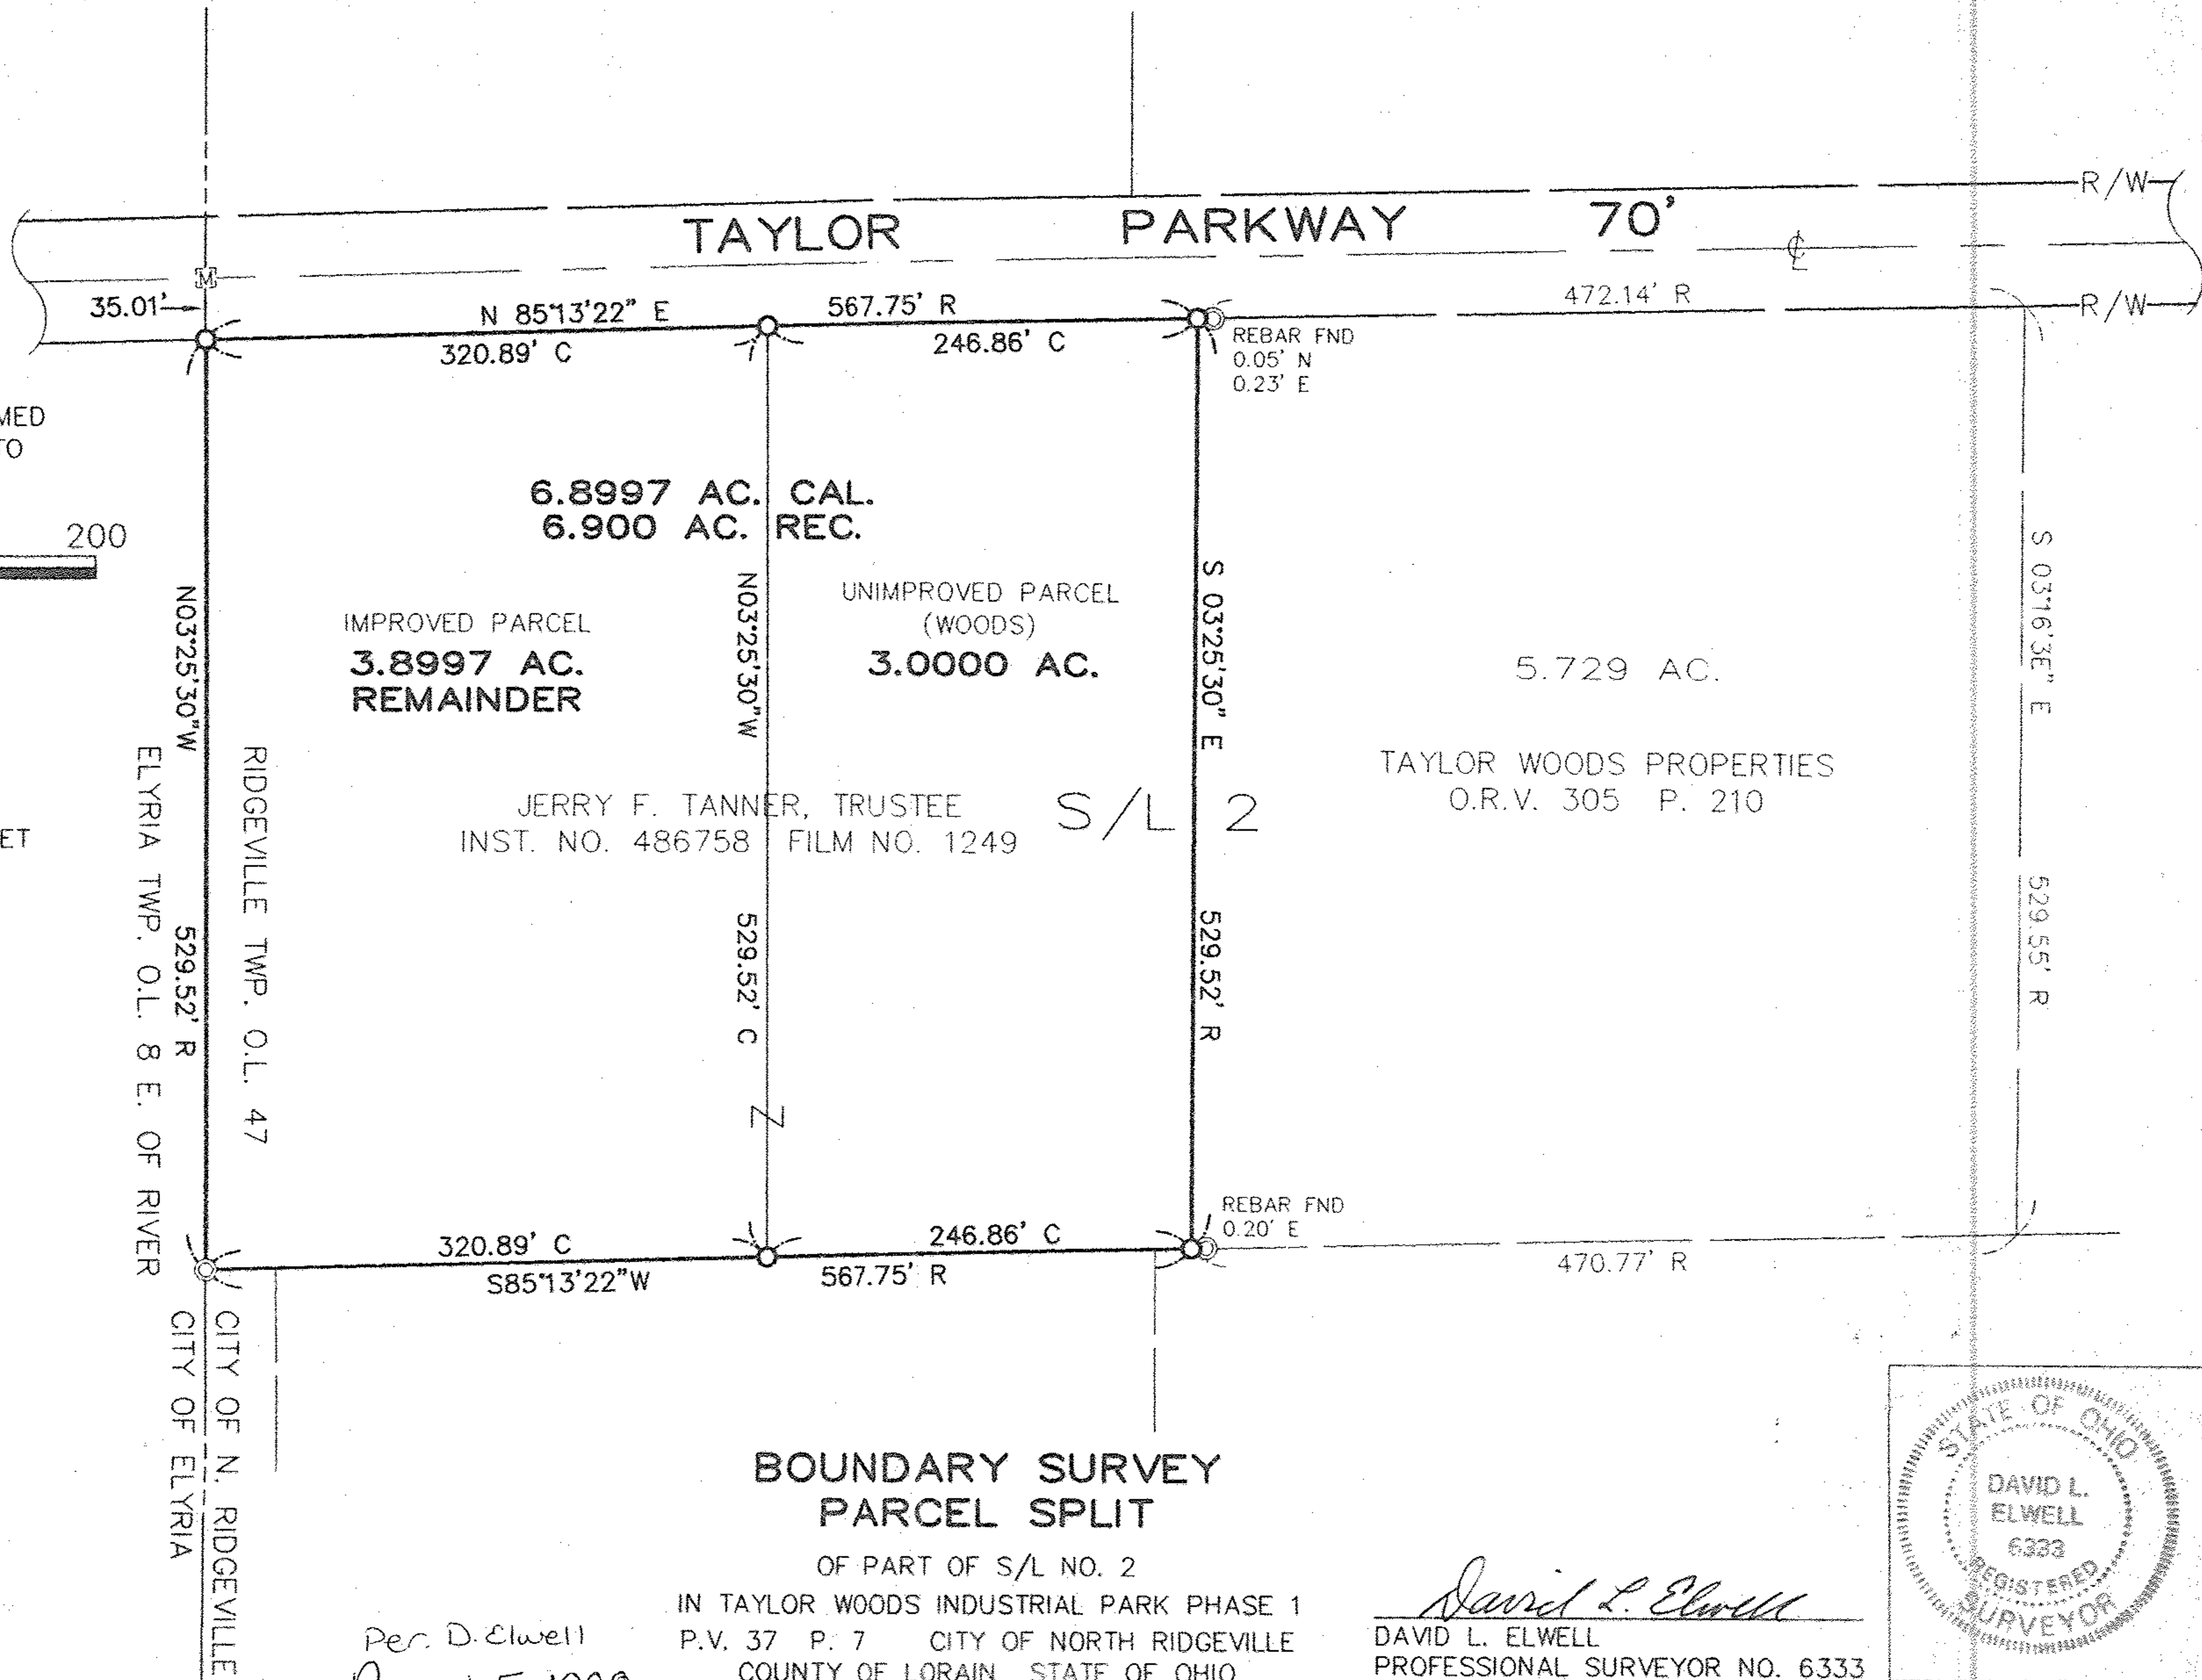

6.8997 AC. CAL.  
6.900 AC. REC.  
IMPROVED PARCEL  
3.8997 AC.  
REMAINDER

UNIMPROVED PARCEL  
(WOODS)  
3.0000 AC.

TAYLOR WOODS PROPERTIES  
O.R.V. 305 P. 210

JERRY F. TANNER, TRUSTEE  
INST. NO. 486758 FILM NO. 1249

S/L 2

**BOUNDARY SURVEY  
PARCEL SPLIT**

OF PART OF S/L NO. 2  
IN TAYLOR WOODS INDUSTRIAL PARK PHASE 1  
P.V. 37 P. 7 CITY OF NORTH RIDGEVILLE  
COUNTY OF LORAIN STATE OF OHIO

Per. D. Elwell  
August 5 1998

*David L. Elwell*  
DAVID L. ELWELL  
PROFESSIONAL SURVEYOR NO. 6333

