


PLAT OF SURVEY FOR JACK CUSICK

ORIGINAL LOT 12 - TRACT NO. 12
HENRIETTA TOWNSHIP
LORAIN COUNTY OHIO
SCALE: 1" = 60' APRIL-MAY 1973

08-12-012-000-025
SCAN#46339 8-E
Gary E. Penfound
Reg. Surveyor No. 4457

NOTES: ○ indicates iron pin found.
● indicates iron pin set unless otherwise designated.

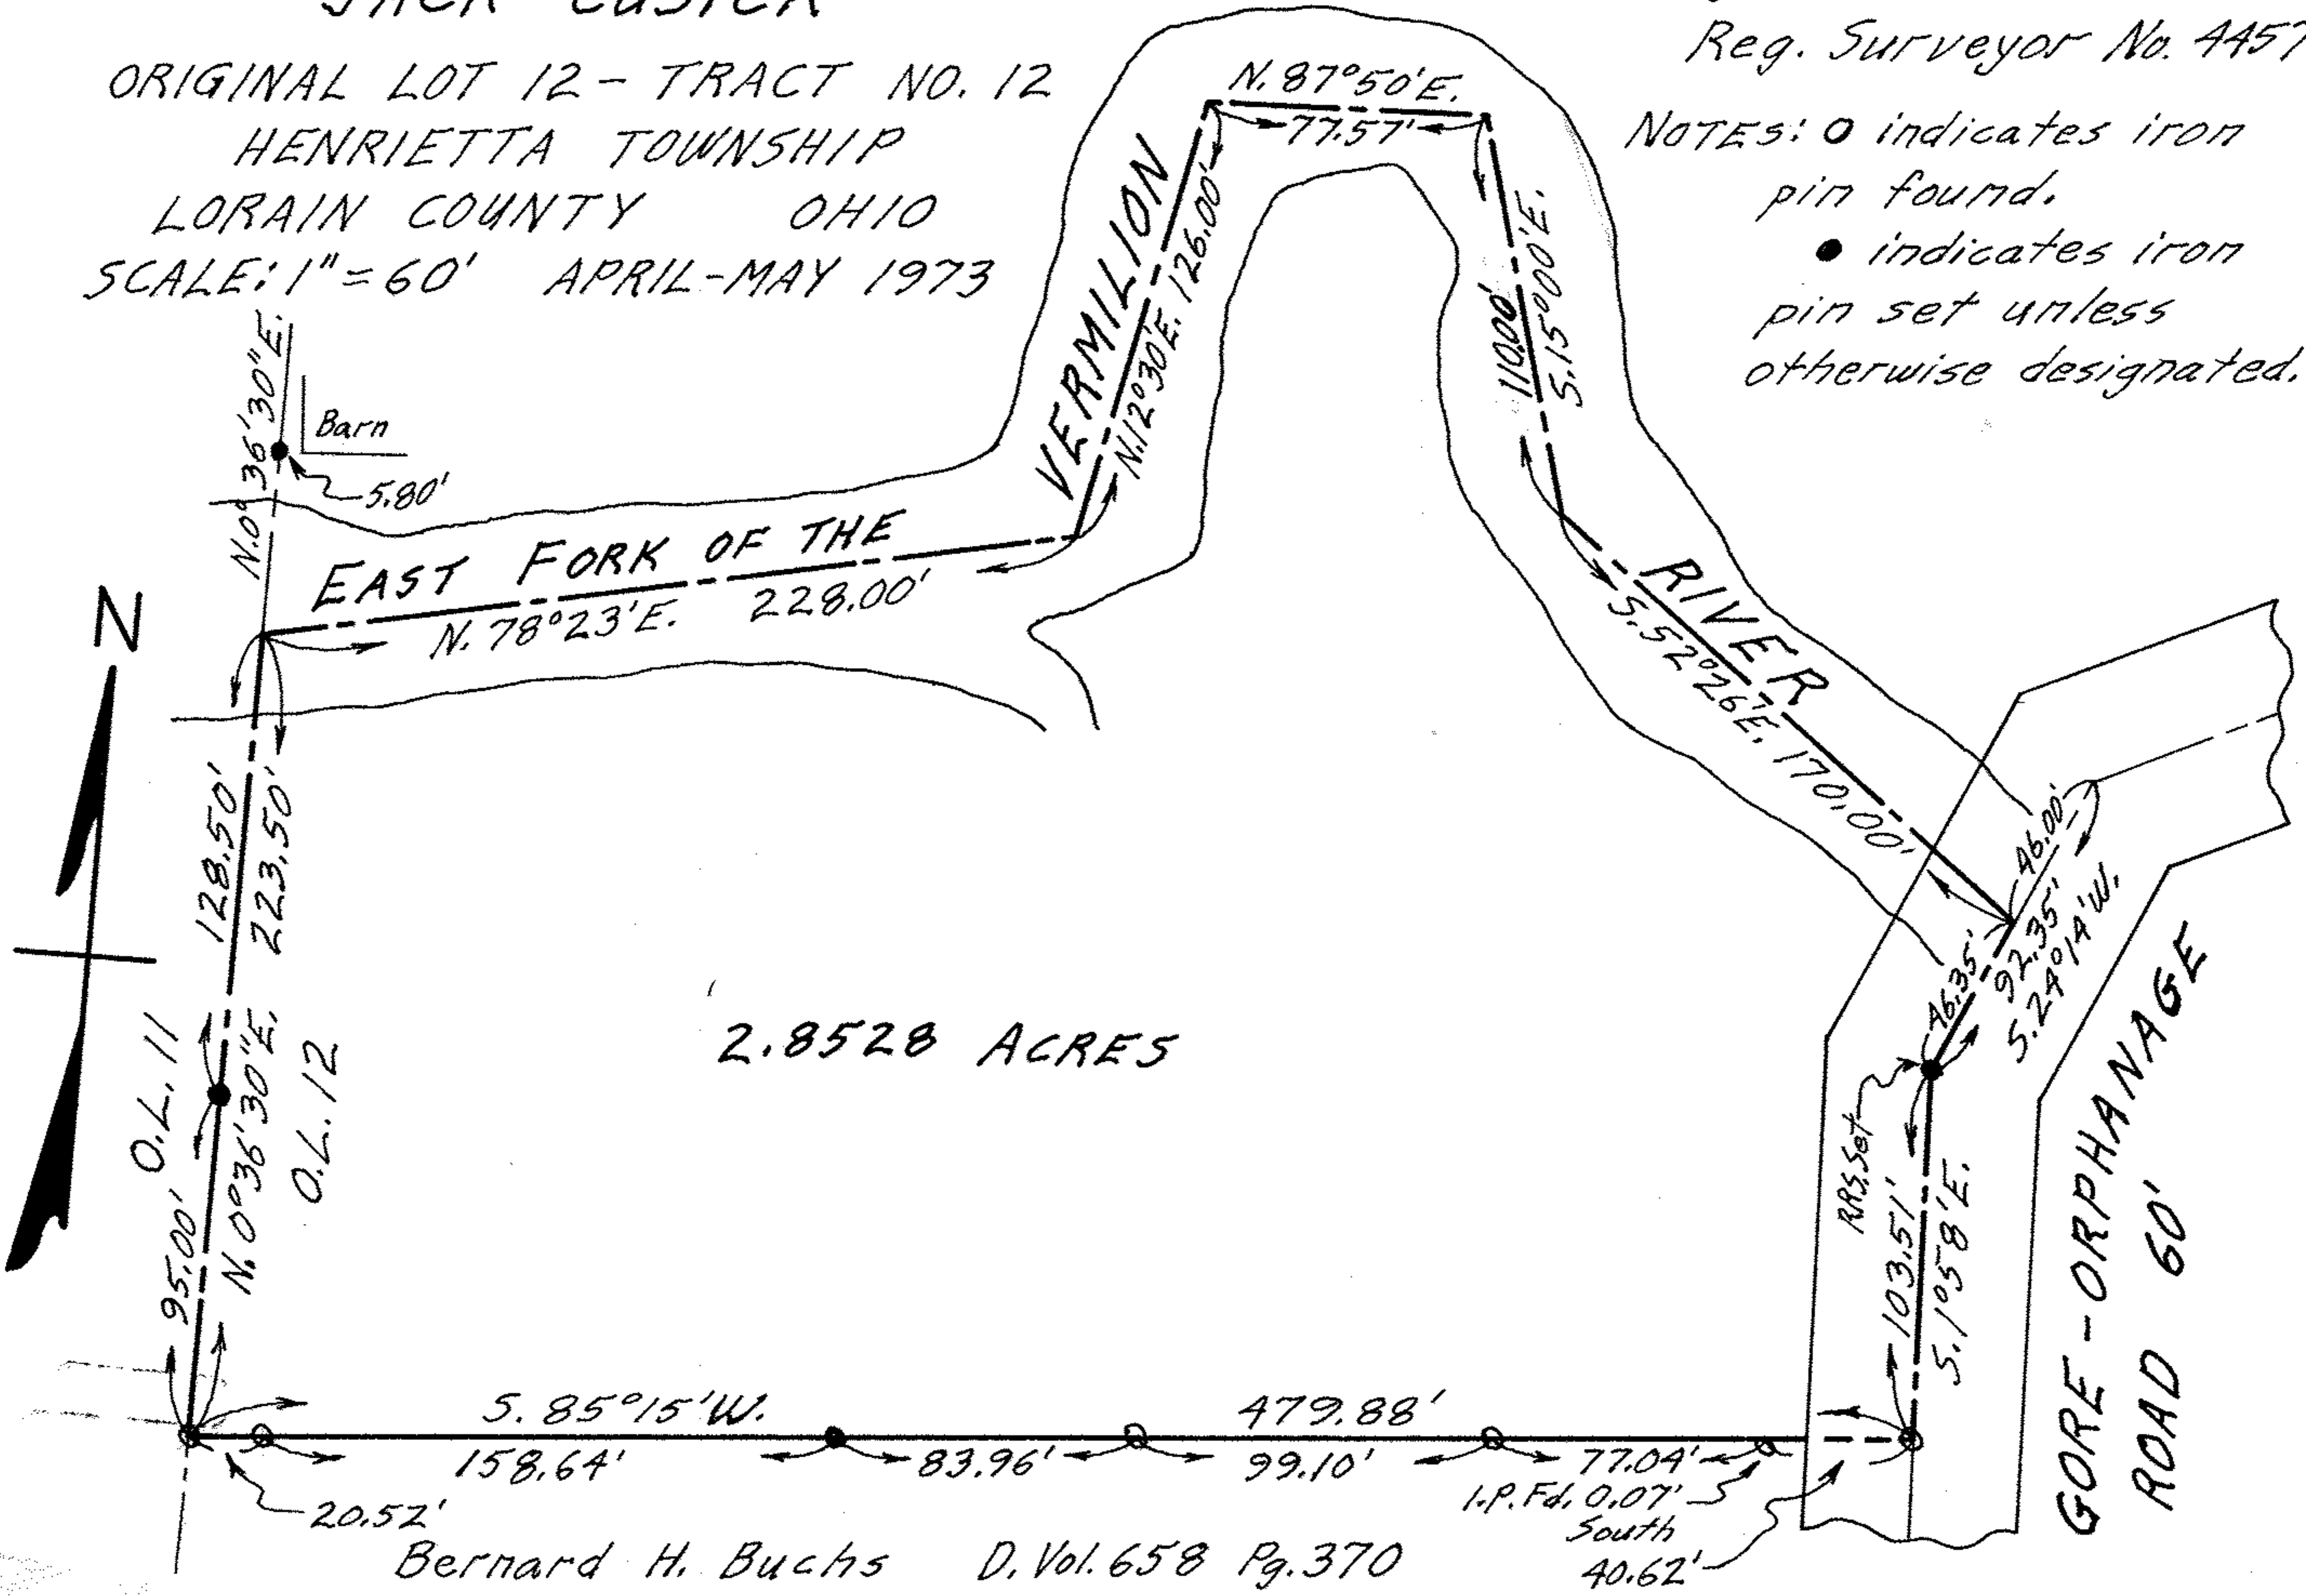

Bernard H. Buchs D. Vol. 658 Pg. 370