


NOTES: ○ indicates Railroad Spike set on this or prior Surveys.  
● indicates Iron Pin set unless otherwise designated.

8-H  
SCAN# 46345

### OBERLIN - NORWALK ROAD STATE ROUTE 10

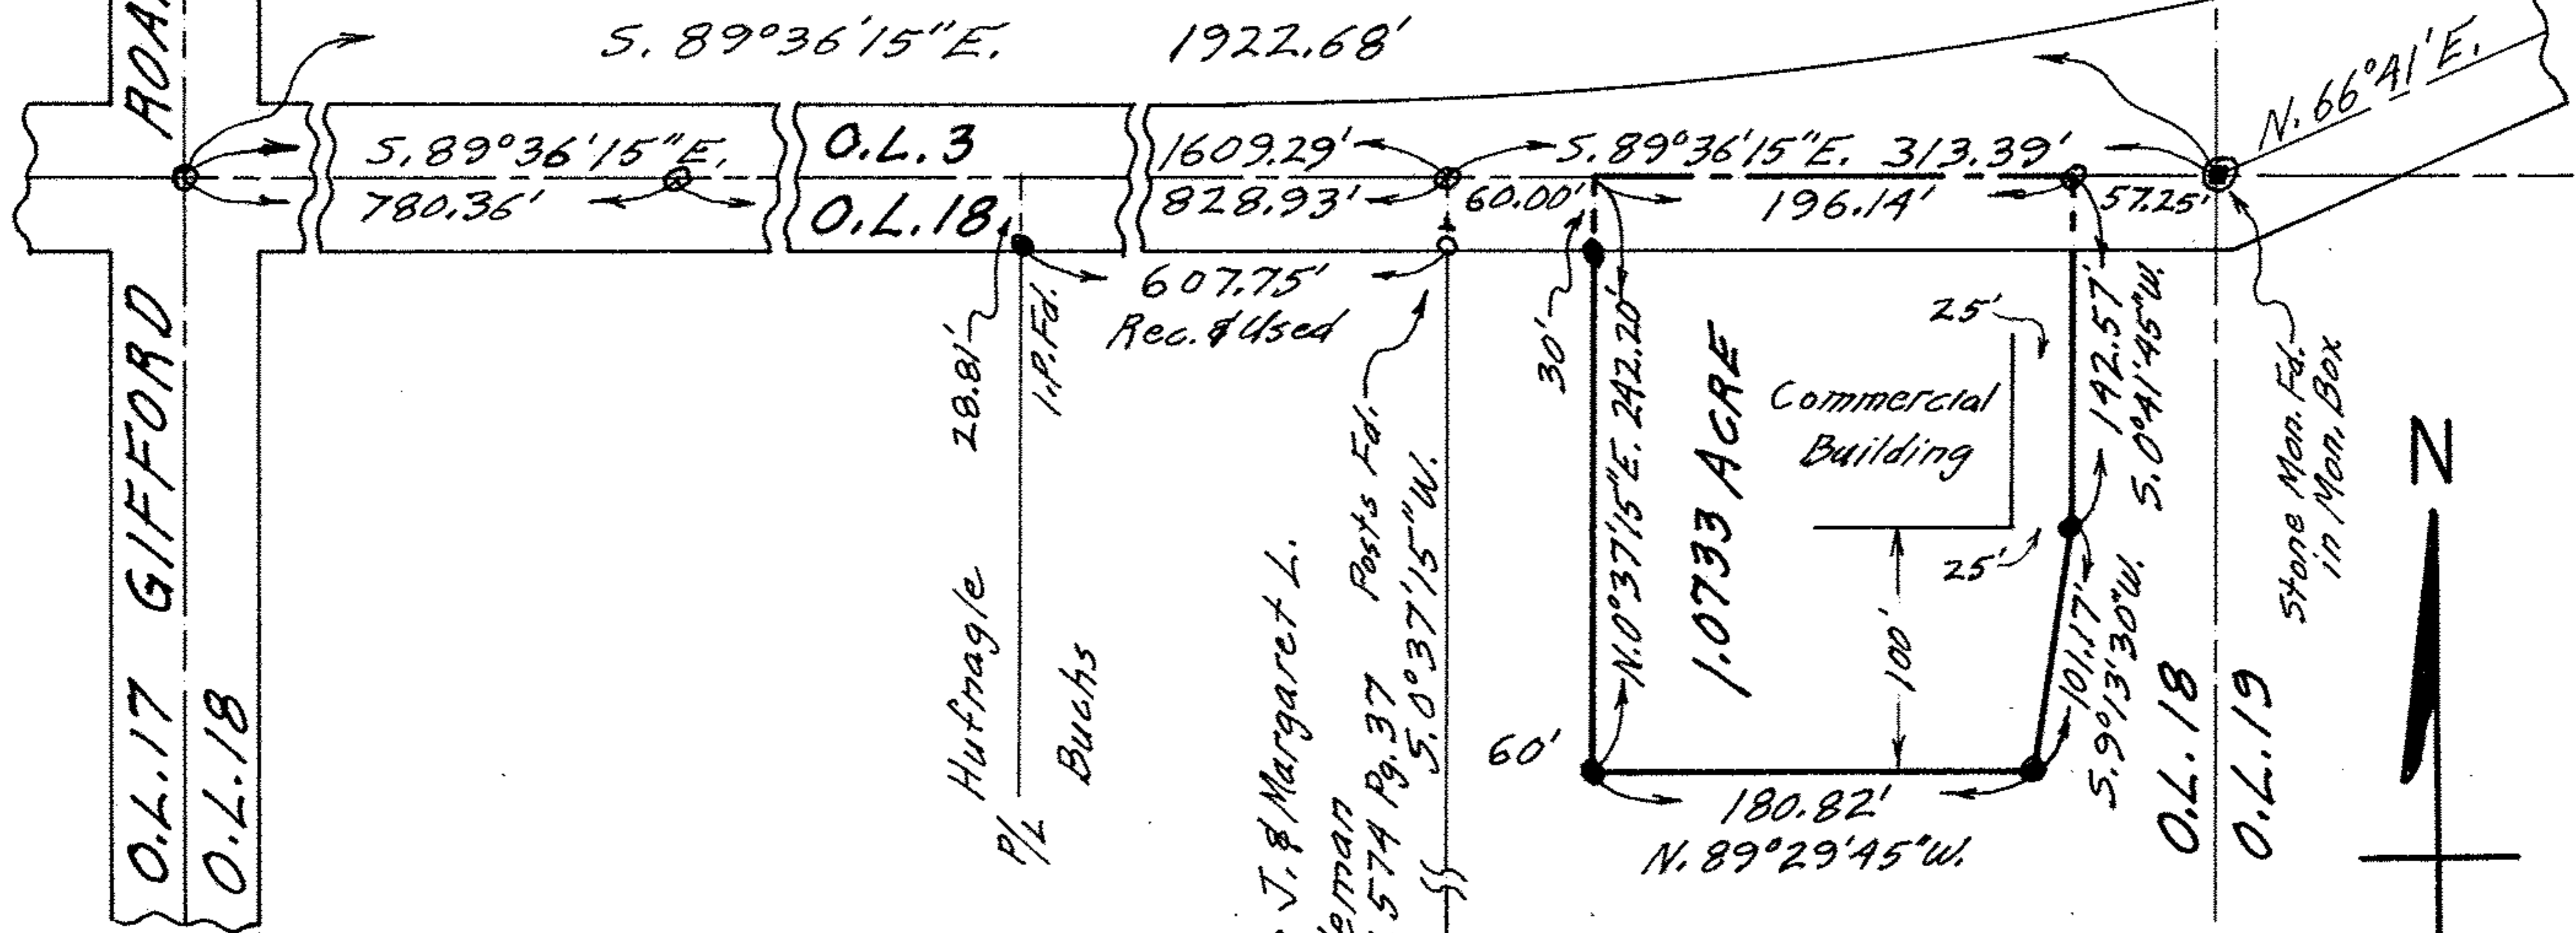

### PLAT OF SURVEY FOR ALLEN C. BUCHS

ORIGINAL LOT 18 - TRACT NO. 12  
HENRIETTA TOWNSHIP  
LORAIN COUNTY OHIO  
SCALE: 1" = 100' MAY 1974

Clyde J. & Margaret L. Lindeman  
D. Vol. 574 Pg. 37  
I.P. Fd. 5.0°37'15"W.

Gary E. Penfound  
Reg. Surveyor No. 4457