
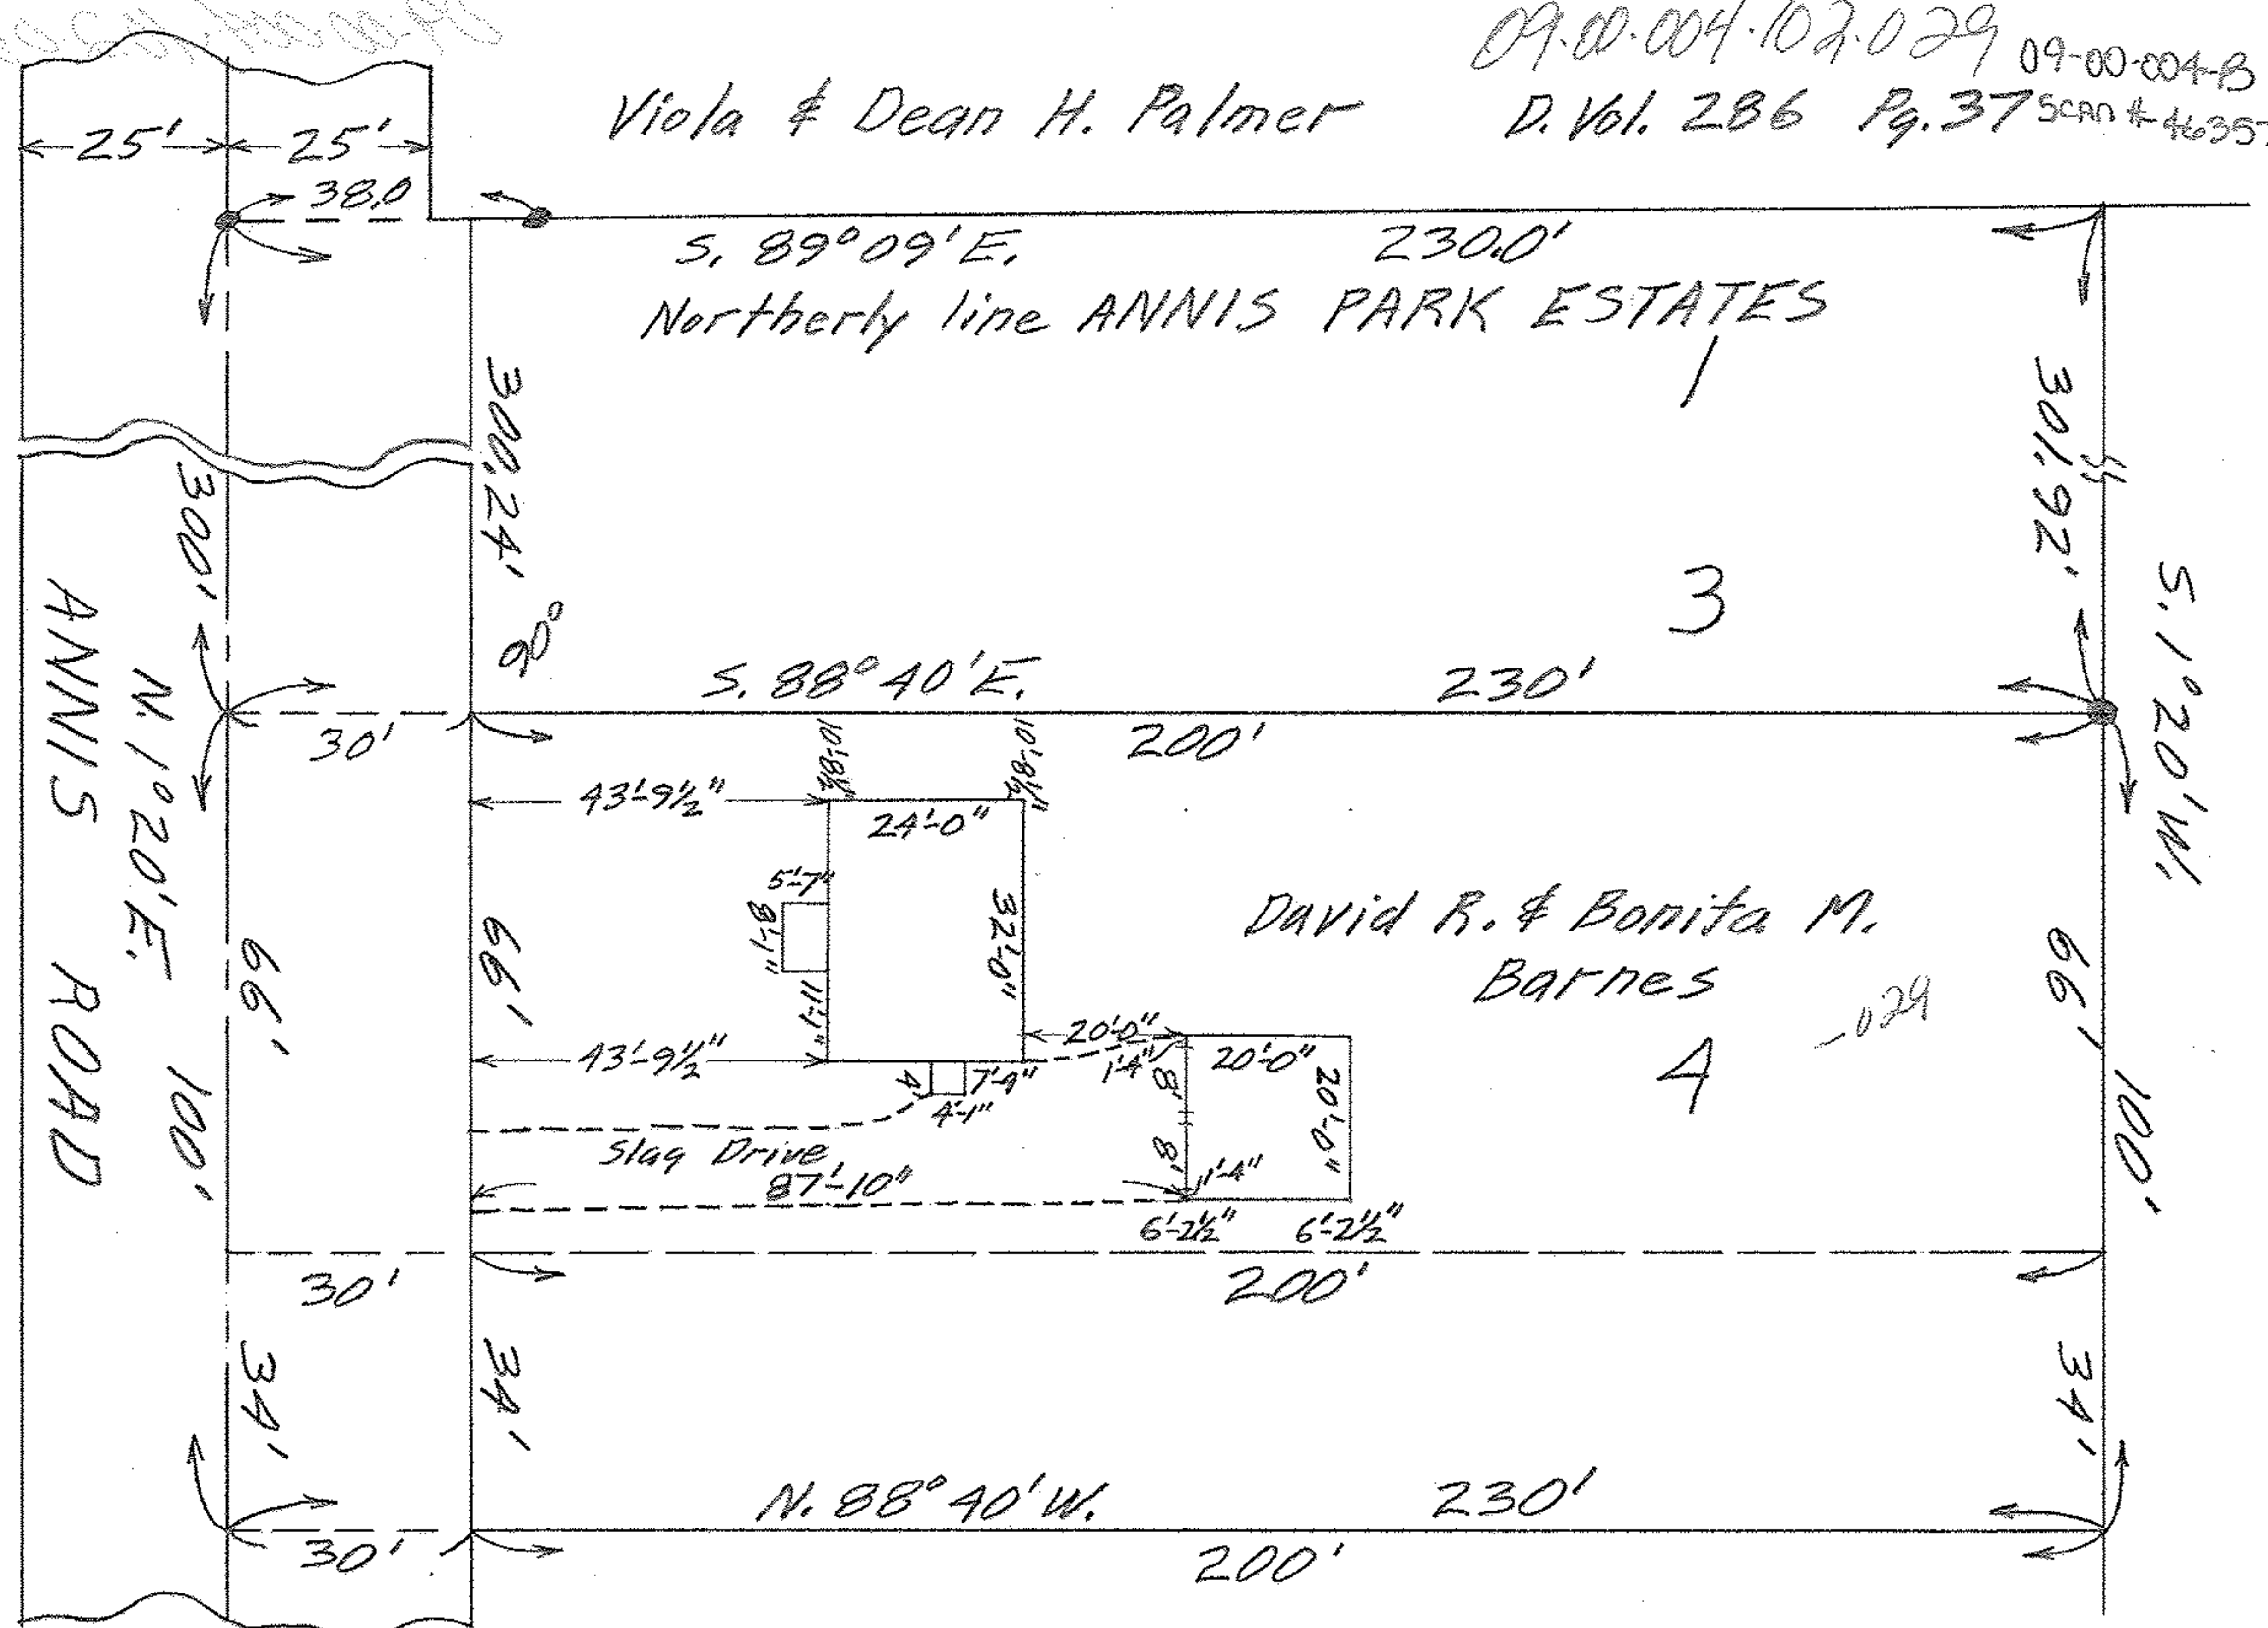


Viola & Dean H. Palmer

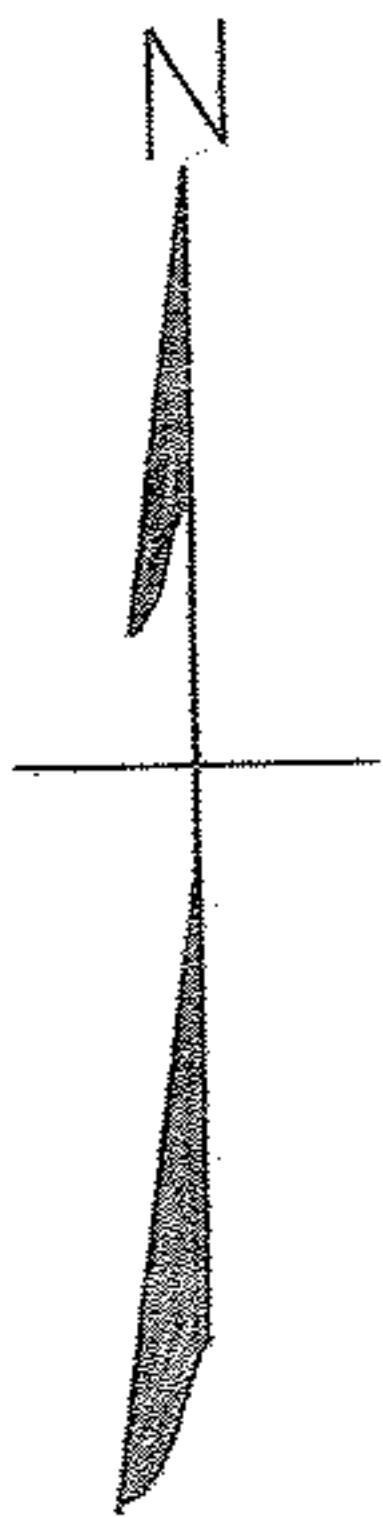

MAP OF NORTHERLY 66 FEET OF SUB-LOT NO. 4
ANNIS PARK ESTATES VOL. 21 PG. 35 PLATS
O.L. 4 RUSSIA TWP. SOUTH AMHERST VILLAGE
LORAIN COUNTY OHIO

SCALE: 1"=30' JULY 8-1963 4:00 P.M.
Gary E. Penfound REG. SURVEYOR W W