


09-00-014-101-016

09-00-014-101-016

09-00-014-A
SCAN # 46361

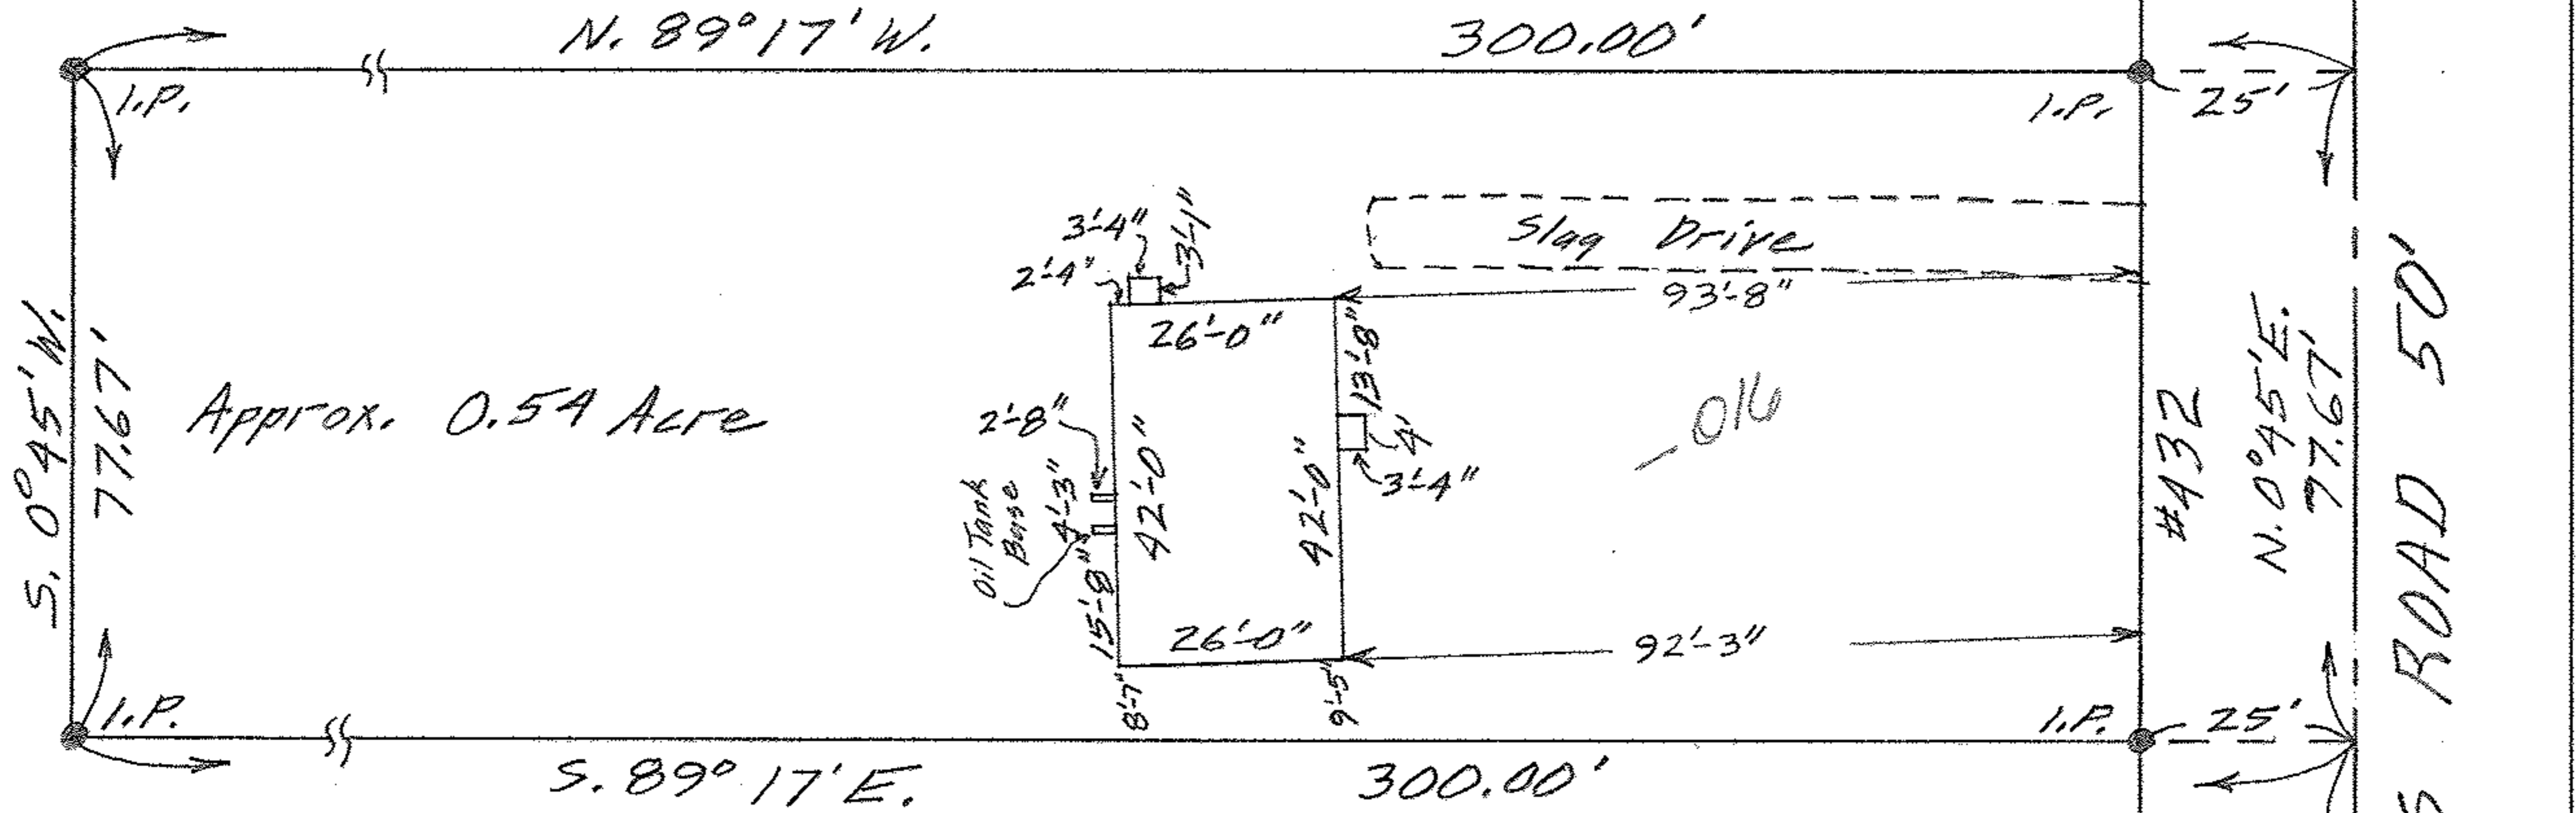

MAP OF PART OF ORIG. LOT NO. 1A
 RUSSIA TWP. - SOUTH AMHERST VILL.
 LORAIN COUNTY OHIO
 SCALE: 1" = 30' SEPT. 15-1964 5:15 P.M.
 Gary E. Penfound REG. SURVEYOR

Junior Nichols & Pauline Nichols