
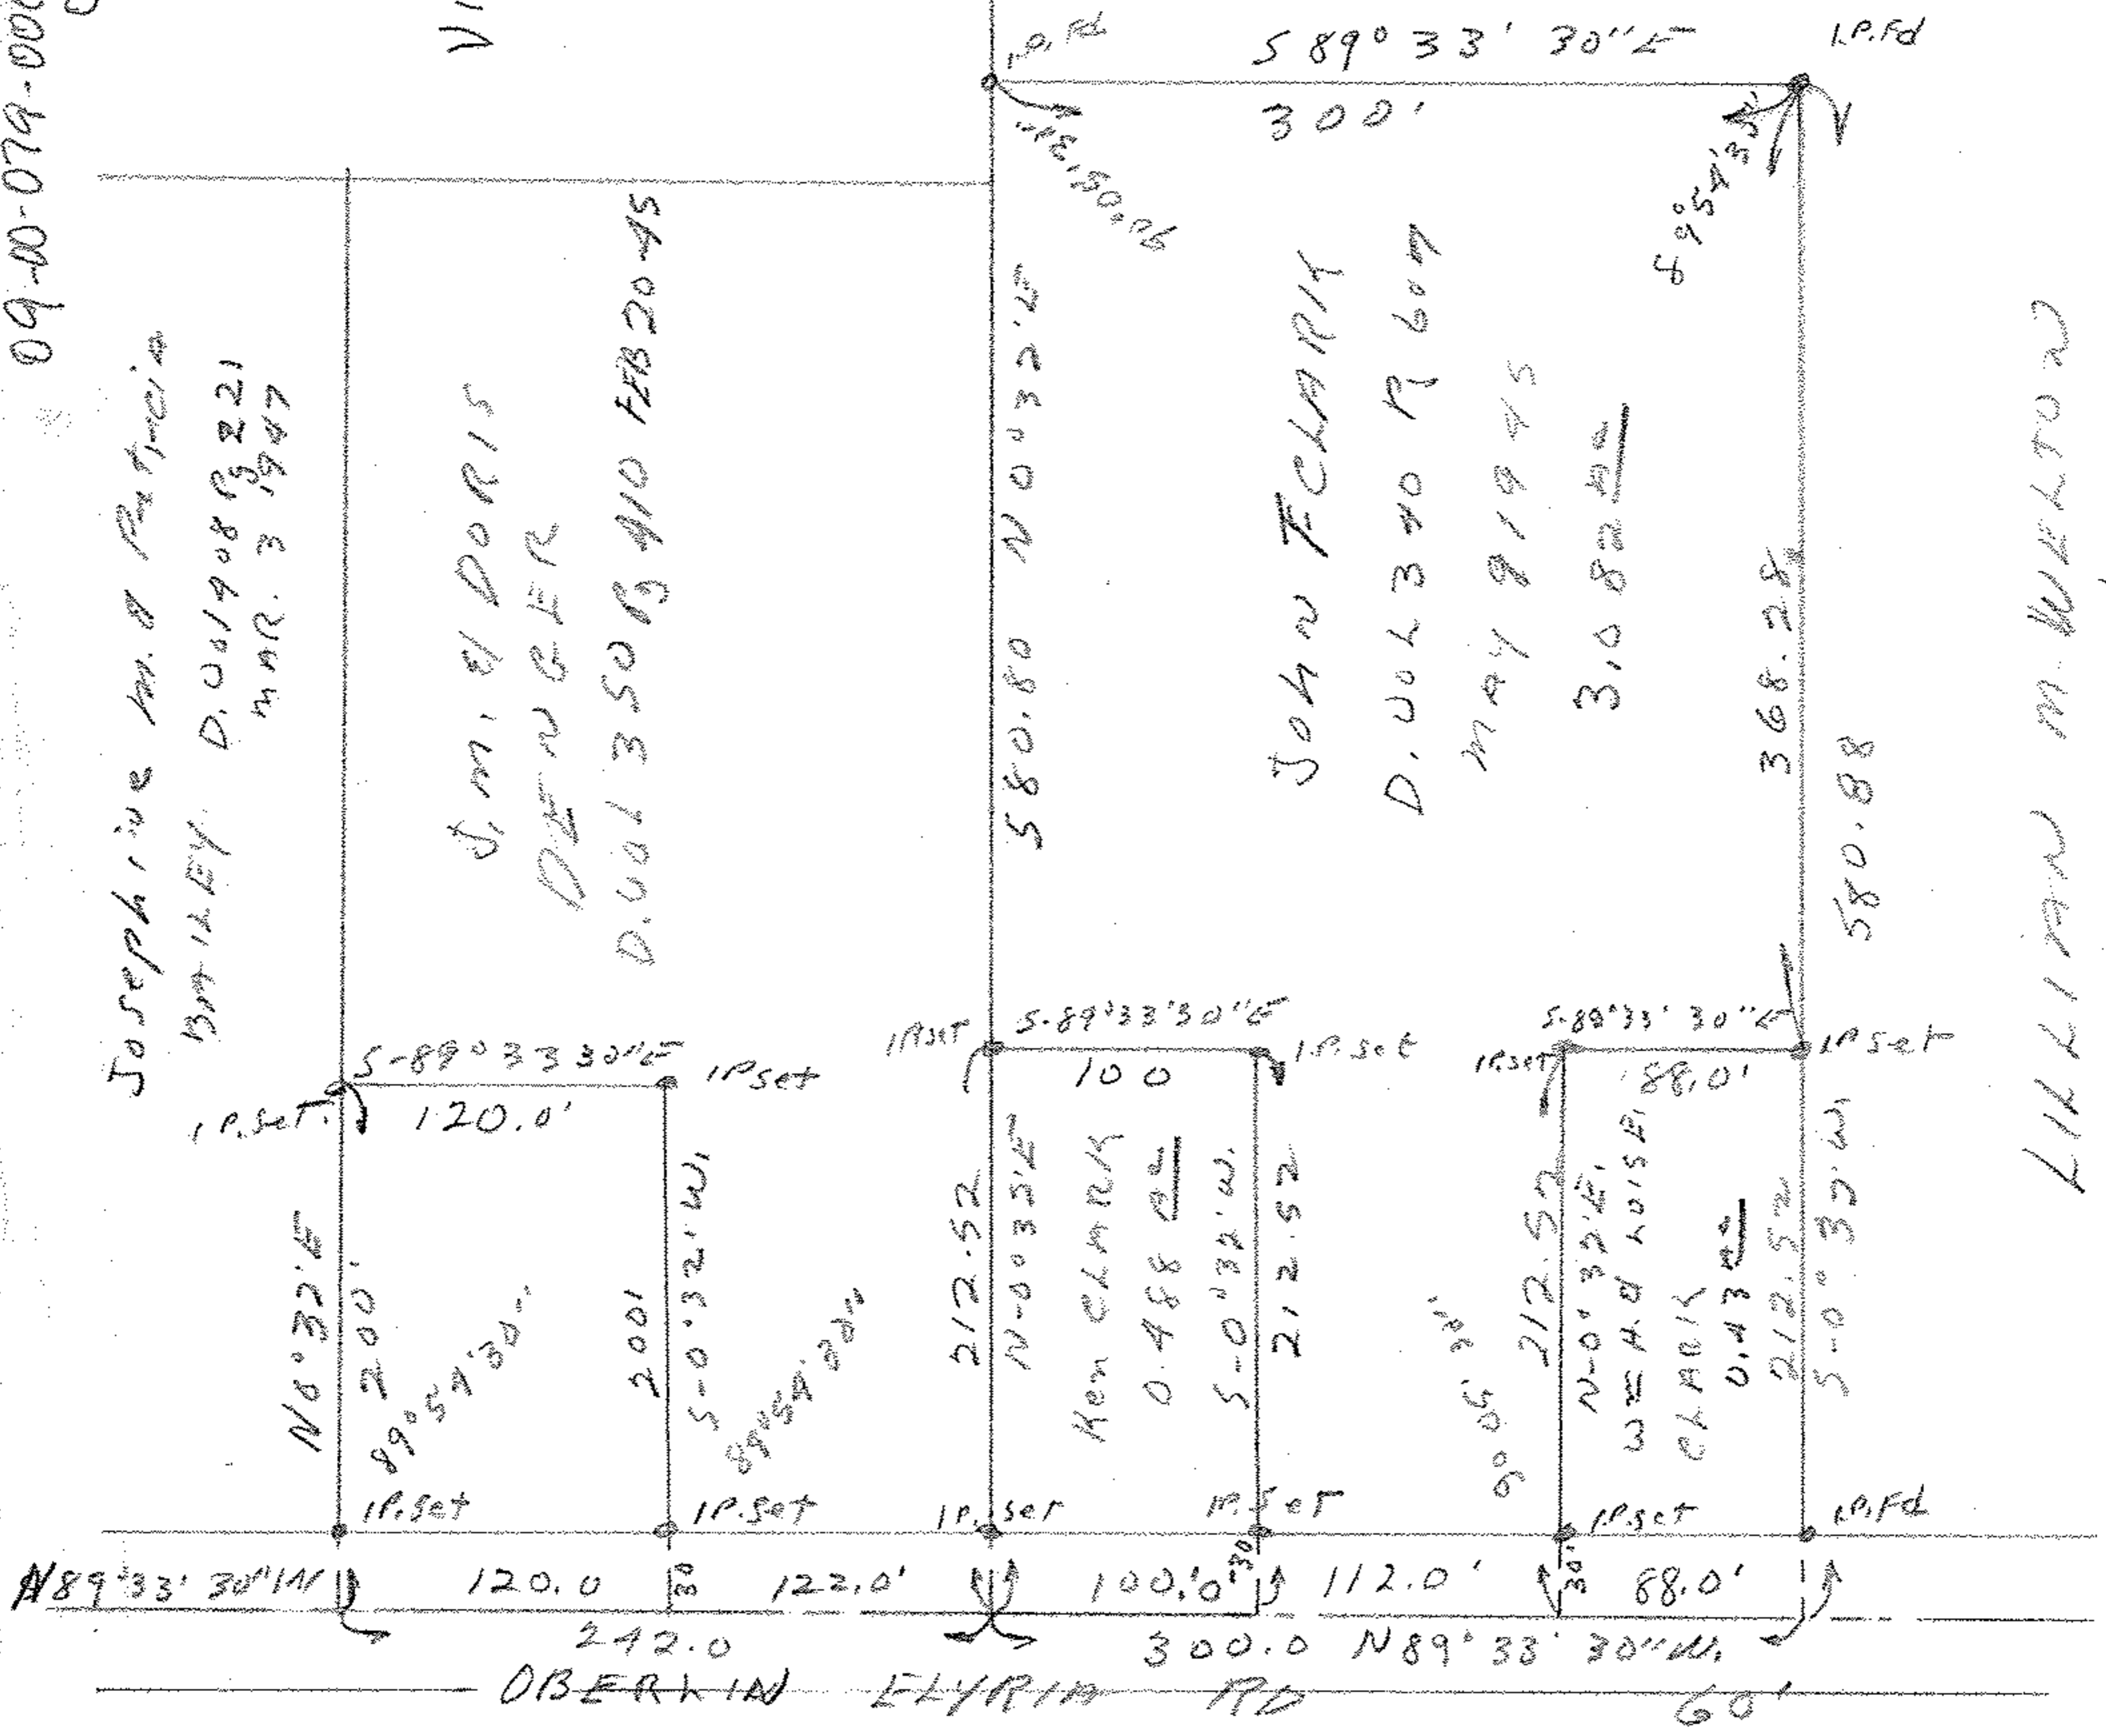


09-00-079-000-006 → 012
 09-00-079-A, B
 SCAM #46377

VILLAGE of OBERLIN

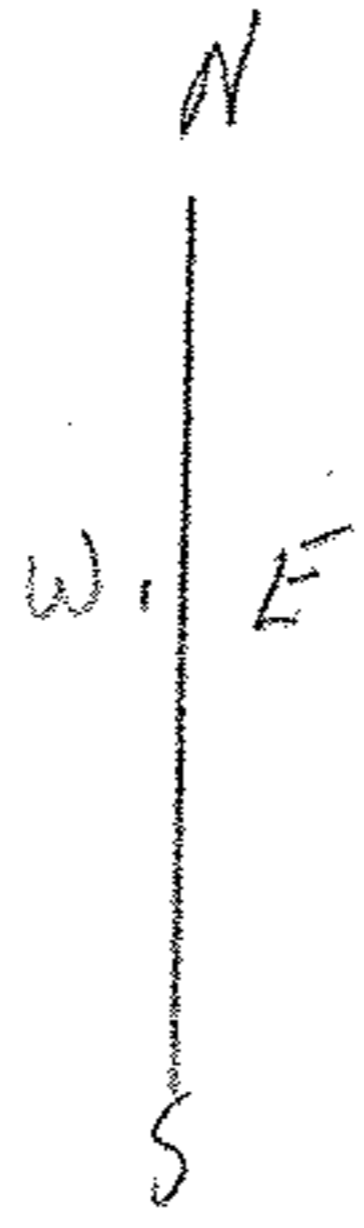

LILLIAN M. WELTON
 DUOR 303 PG 175

SURVEY FOR Wm & DORIS CHARIT
 UL 79 RUSSELL TWP
 SCALE 1" = 100' JAN 10 1948
 BY E. E. Rufford