


09-00-088-103-021

09-00-088B

SCAN # 46383

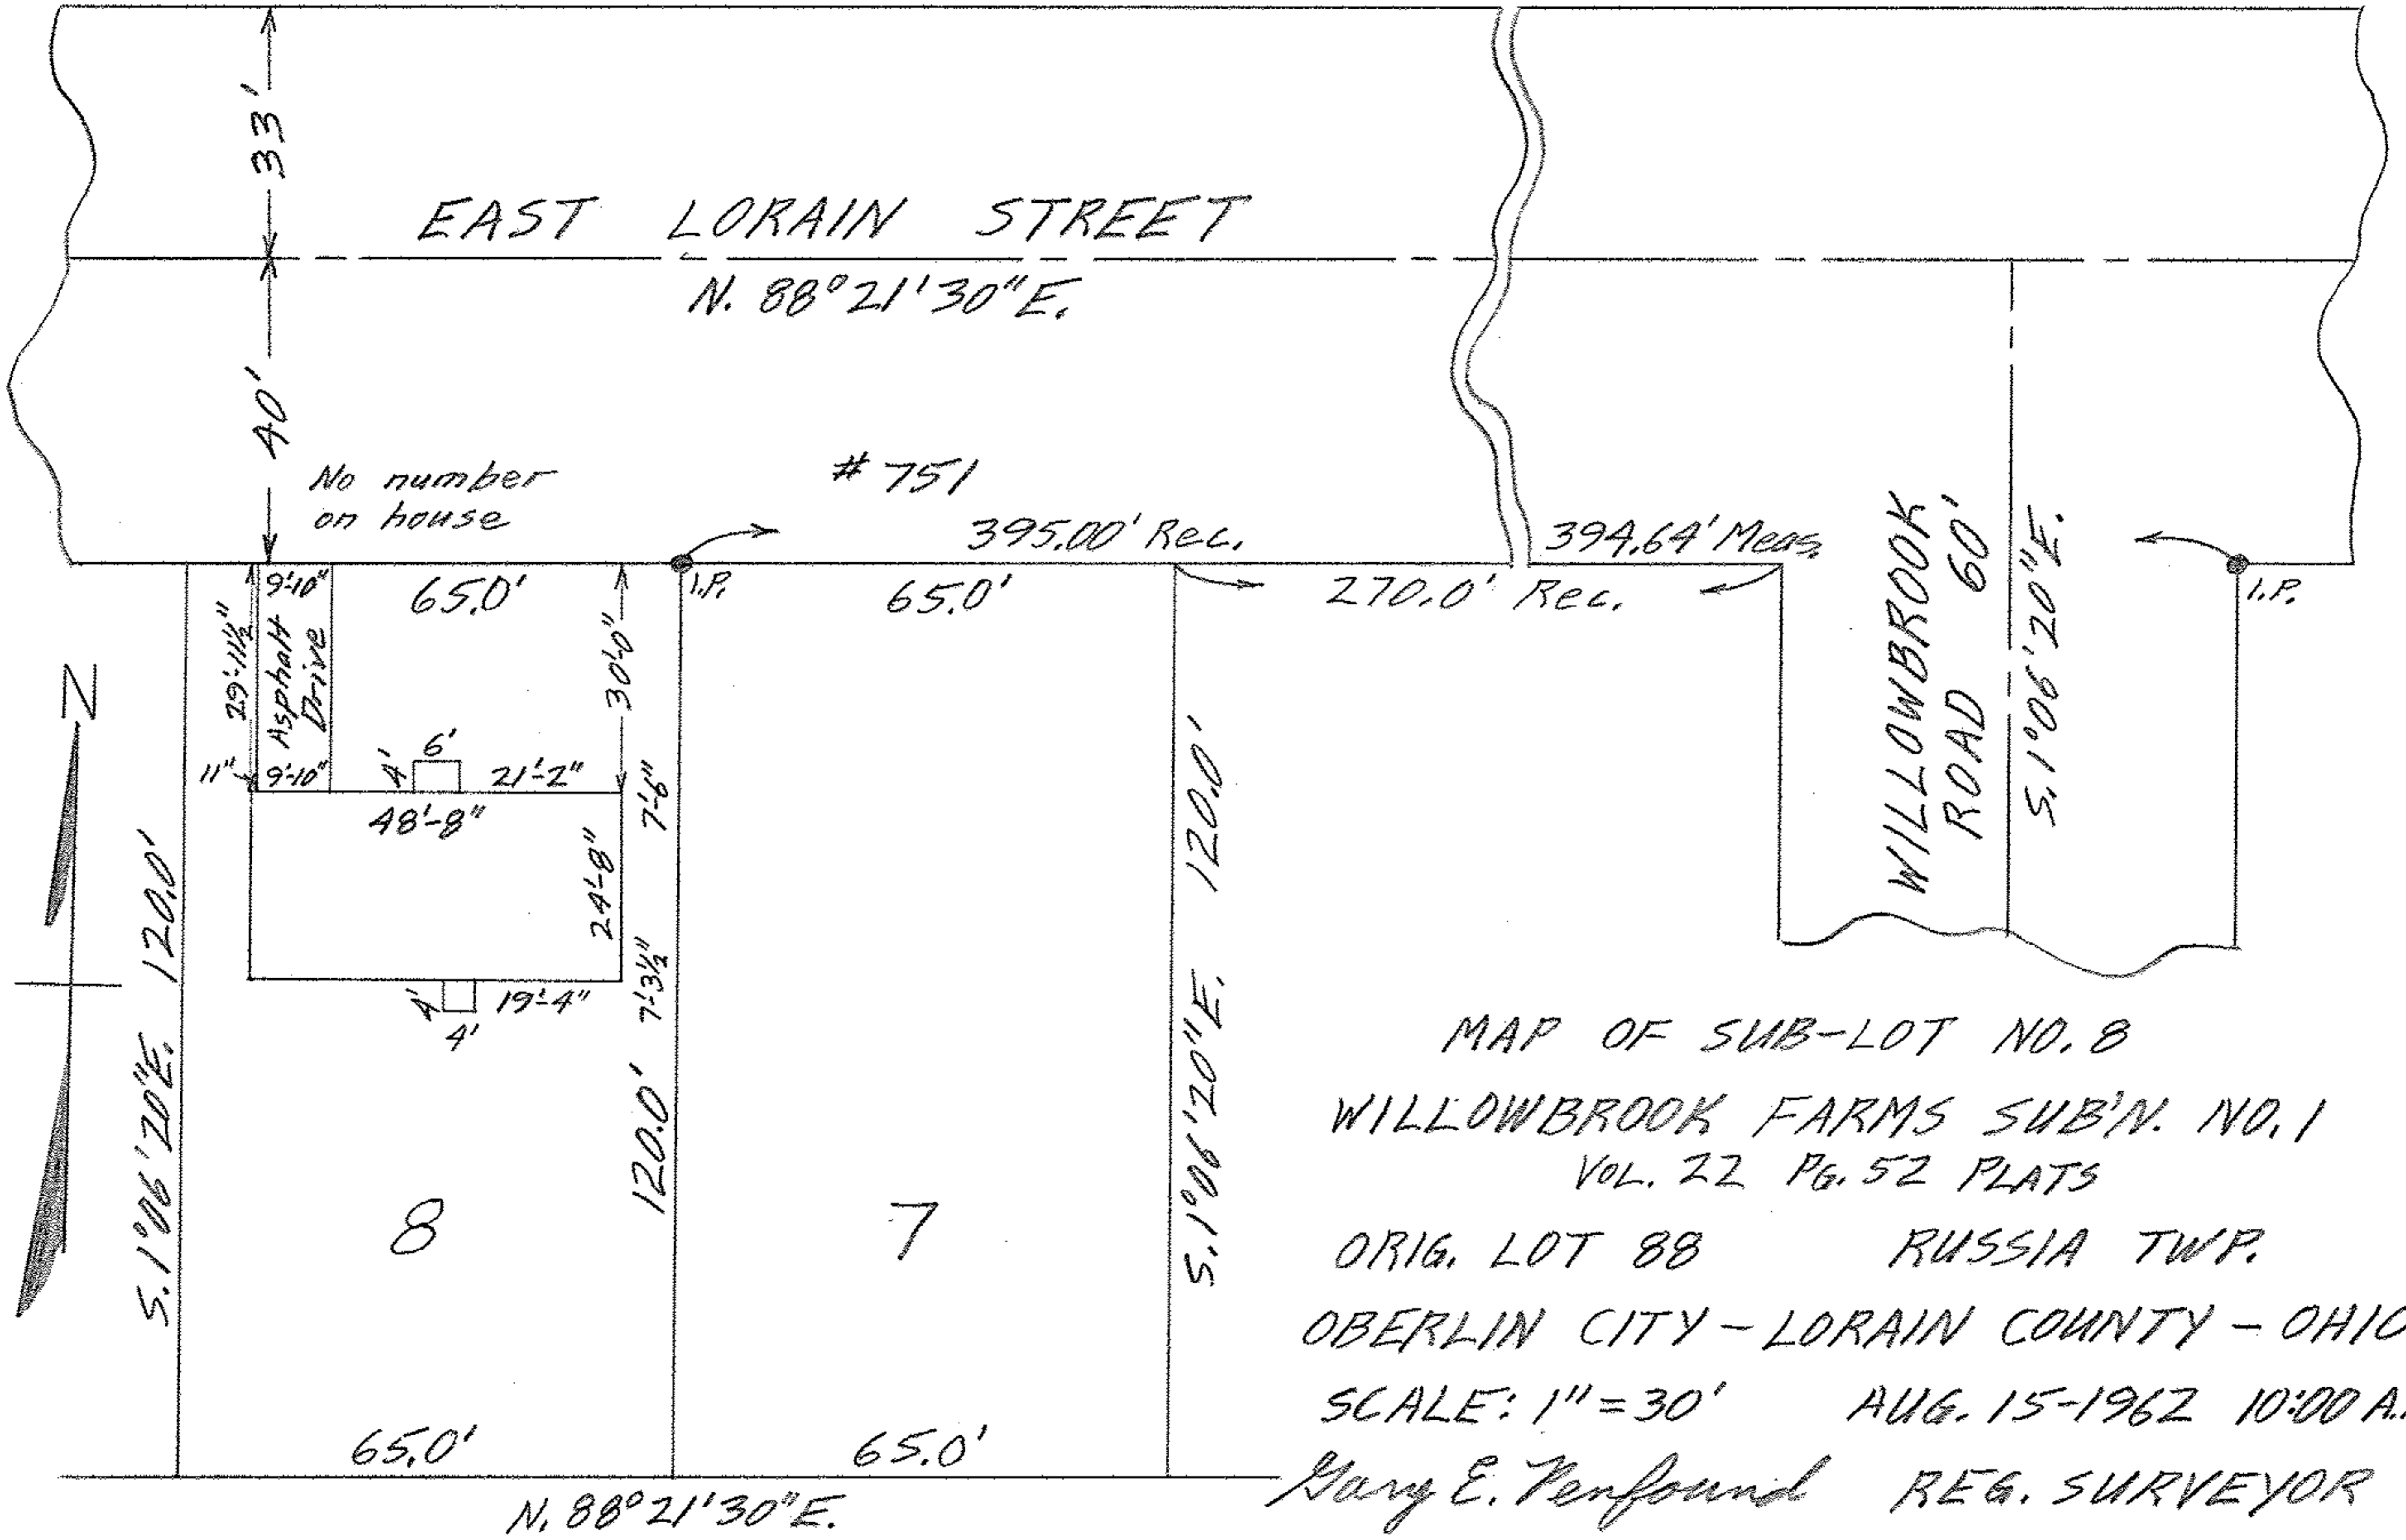

MAP OF SUB-LOT NO. 8

WILLOWBROOK FARMS SUB'N. NO. 1

VOL. 22 PG. 52 PLATS

ORIG. LOT 88

RUSSIA TWP.

OBERLIN CITY - LORAIN COUNTY - OHIO

SCALE: 1" = 30'

AUG. 15-1962 10:00 A.M.

Mary E. Penfound REG. SURVEYOR

Charles F. & Anne C. Bayorek