


09-00-088-103-001  
09-00-088-A Scan# 46384

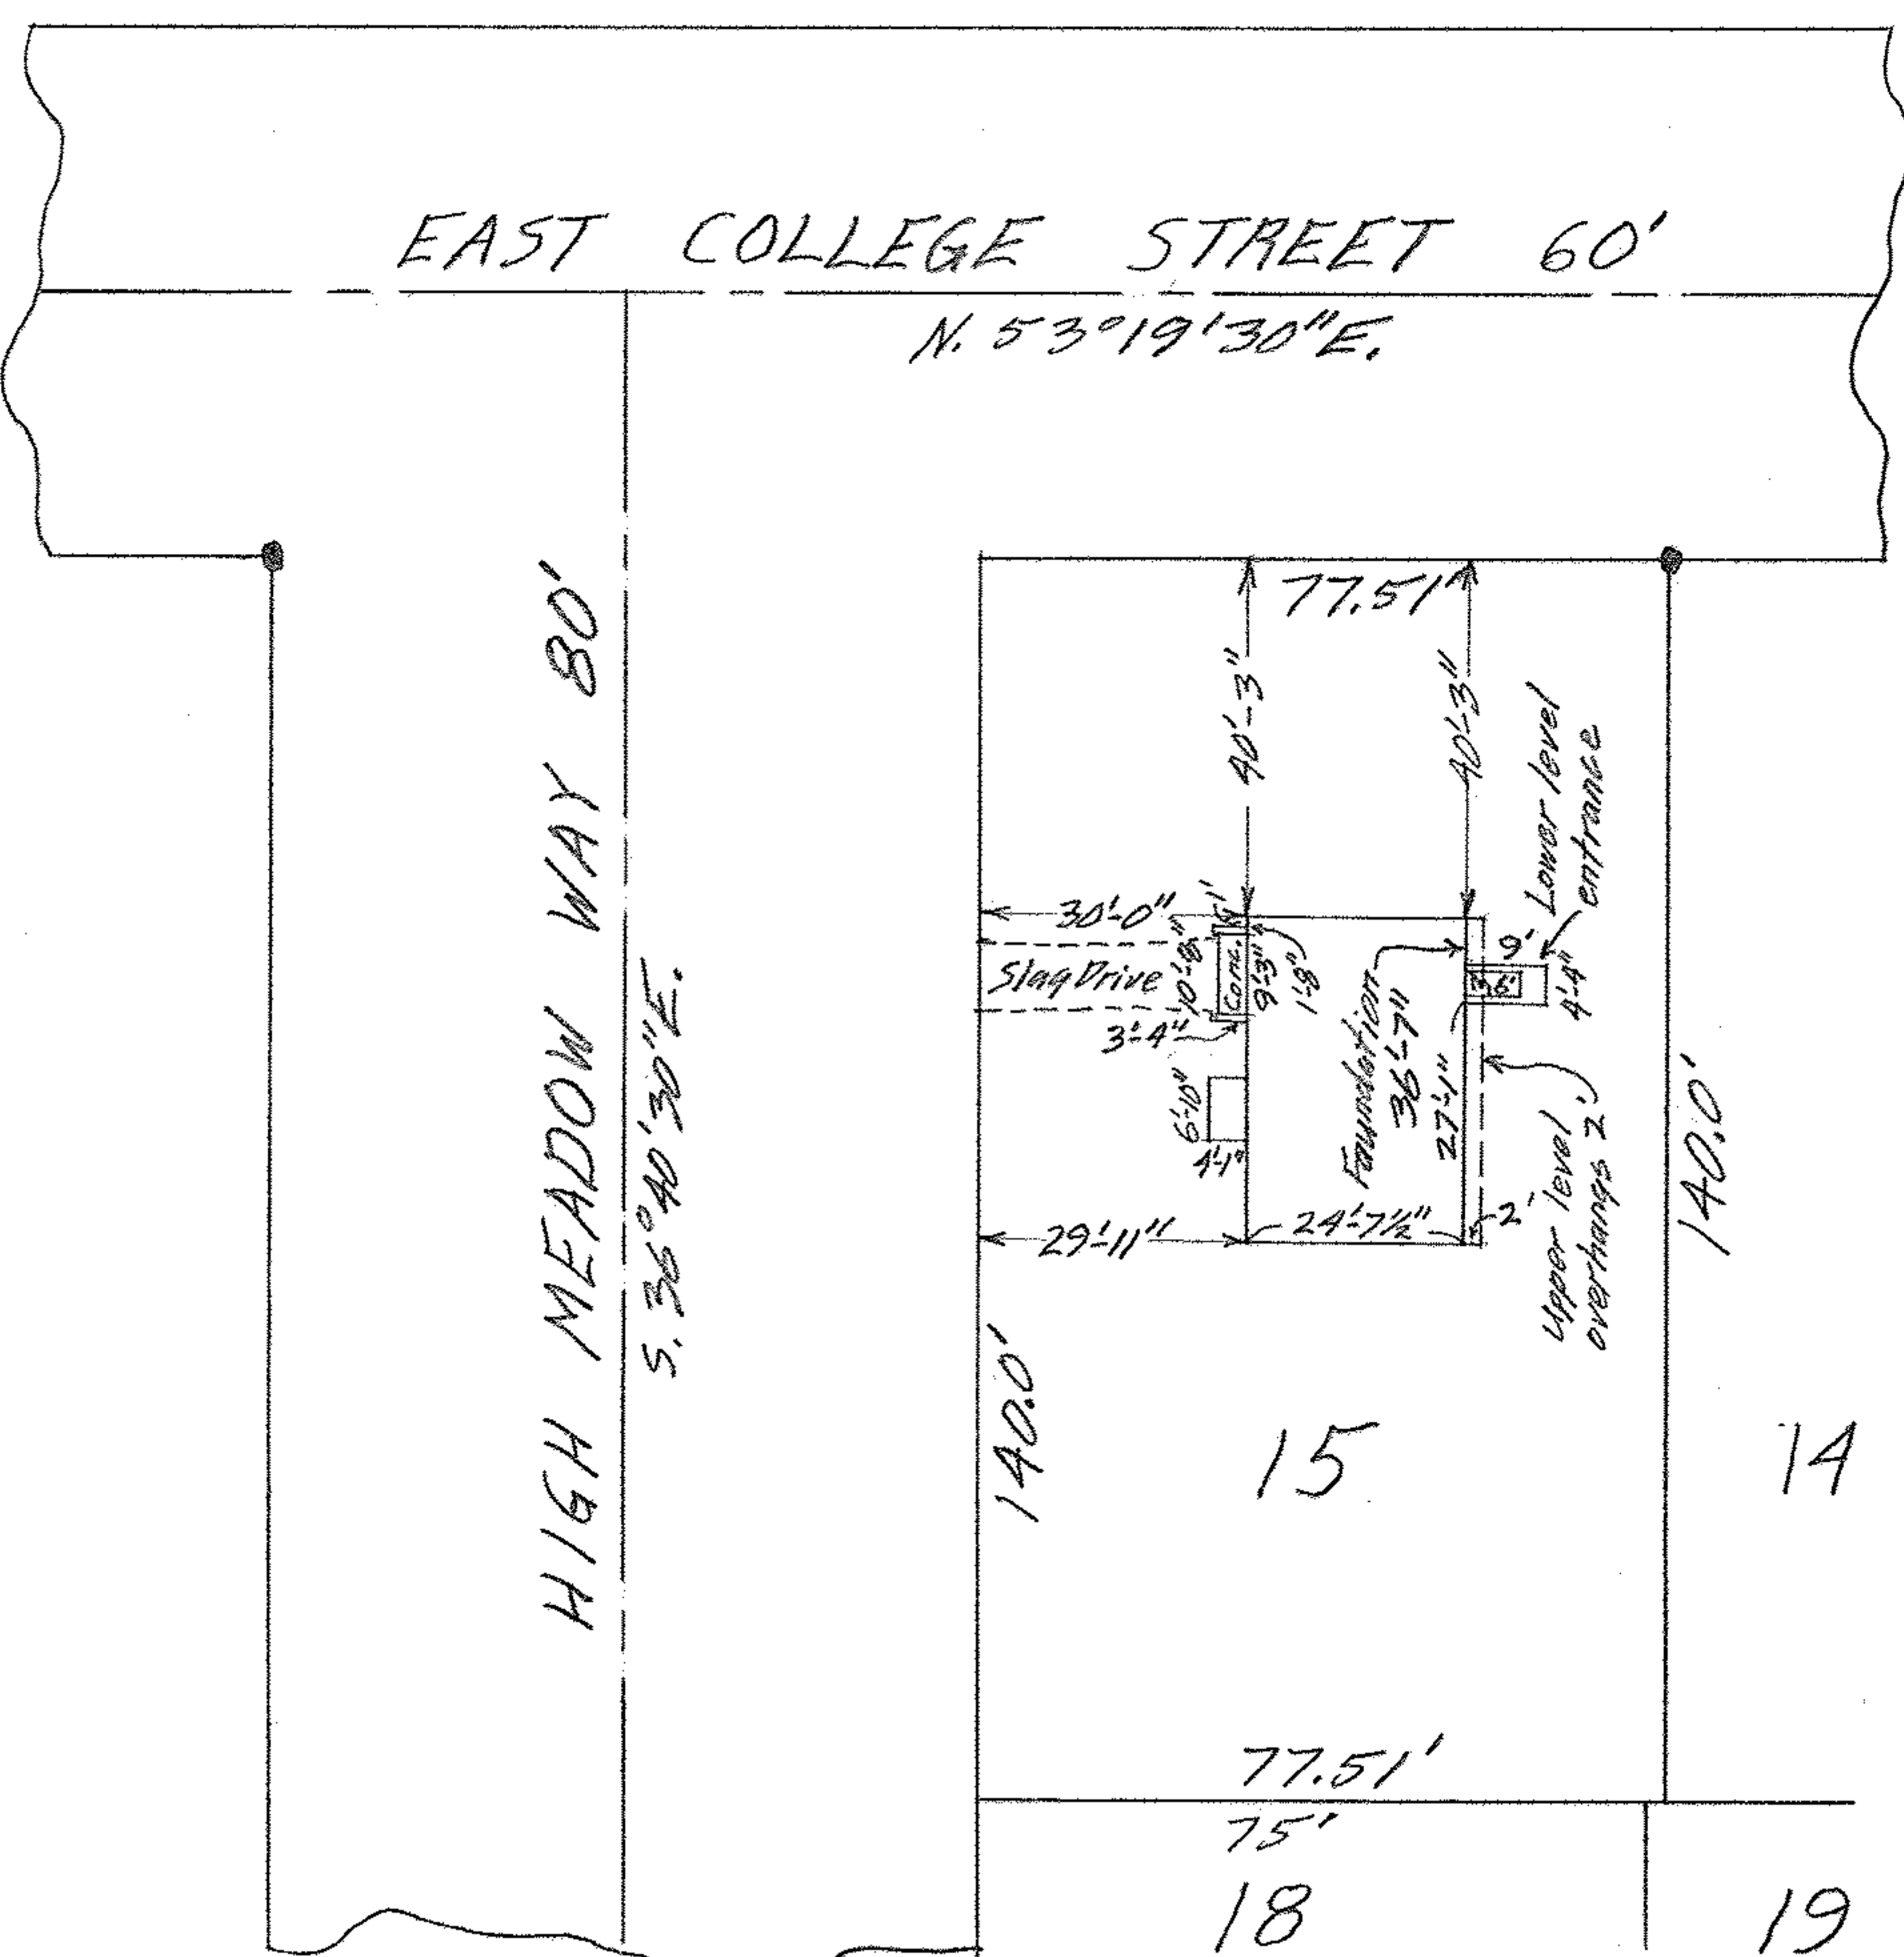

EAST COLLEGE STREET 60'  
N. 53°19'30"E.

HIGH MEADOW WAY 80'  
S. 36°40'30"E.

77.51'

40'-3"

30'-0"

Slag Drive

3'-4"

6'-10"

4'-1"

9'-3"

1'-8"

Foundation

36'-7"

27'-1"

9'

Lower level entrance

4'-4"

2'-0"

Upper level overhangs 2'

140.0'

15


14

77.51'

75'

18

19

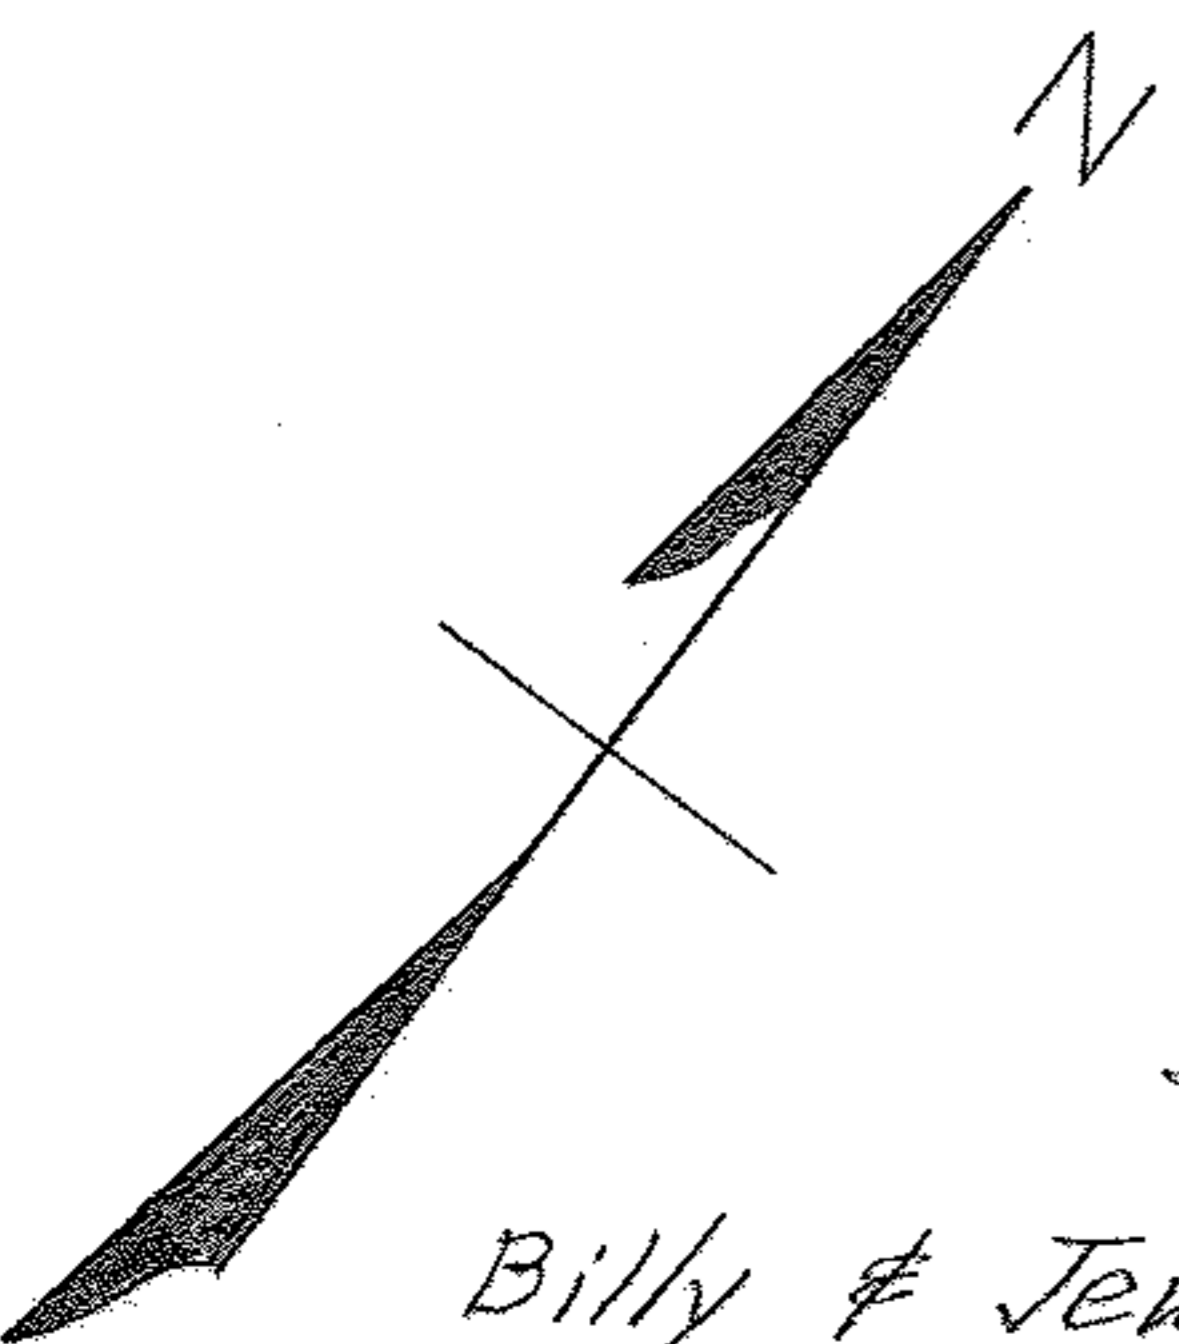

MAP OF SUB-LOT NO. 15  
 WILLOWBROOK FARMS SUBN. NO. 1 - Vol. 22 Pg. 52  
 O.L. 88 RUSSIA TWP. OBERLIN CITY  
 LORAIN COUNTY OHIO  
 SCALE: 1" = 30' FEB. 15 - 1963 11:00 A.M.  
 Gary E. Penfound REG. SURVEYOR

Billy & Jewel M. Rogers