

Joseph N. & Katherine Southworth

Ray E. Perfound REG. SURVEYOR

SCALE: 1" = 30' APRIL 9-1964 6:45 P.M.


LORAIN COUNTY OHIO

0.1.88 MASSIA TWP. OBERLIN CITY

Vol. 22 Pg. 53 PLAT RECORDS

WILLOWBROOK FARMS SUB'D. NO. 2

MAP OF SUB-LOT NO. 76

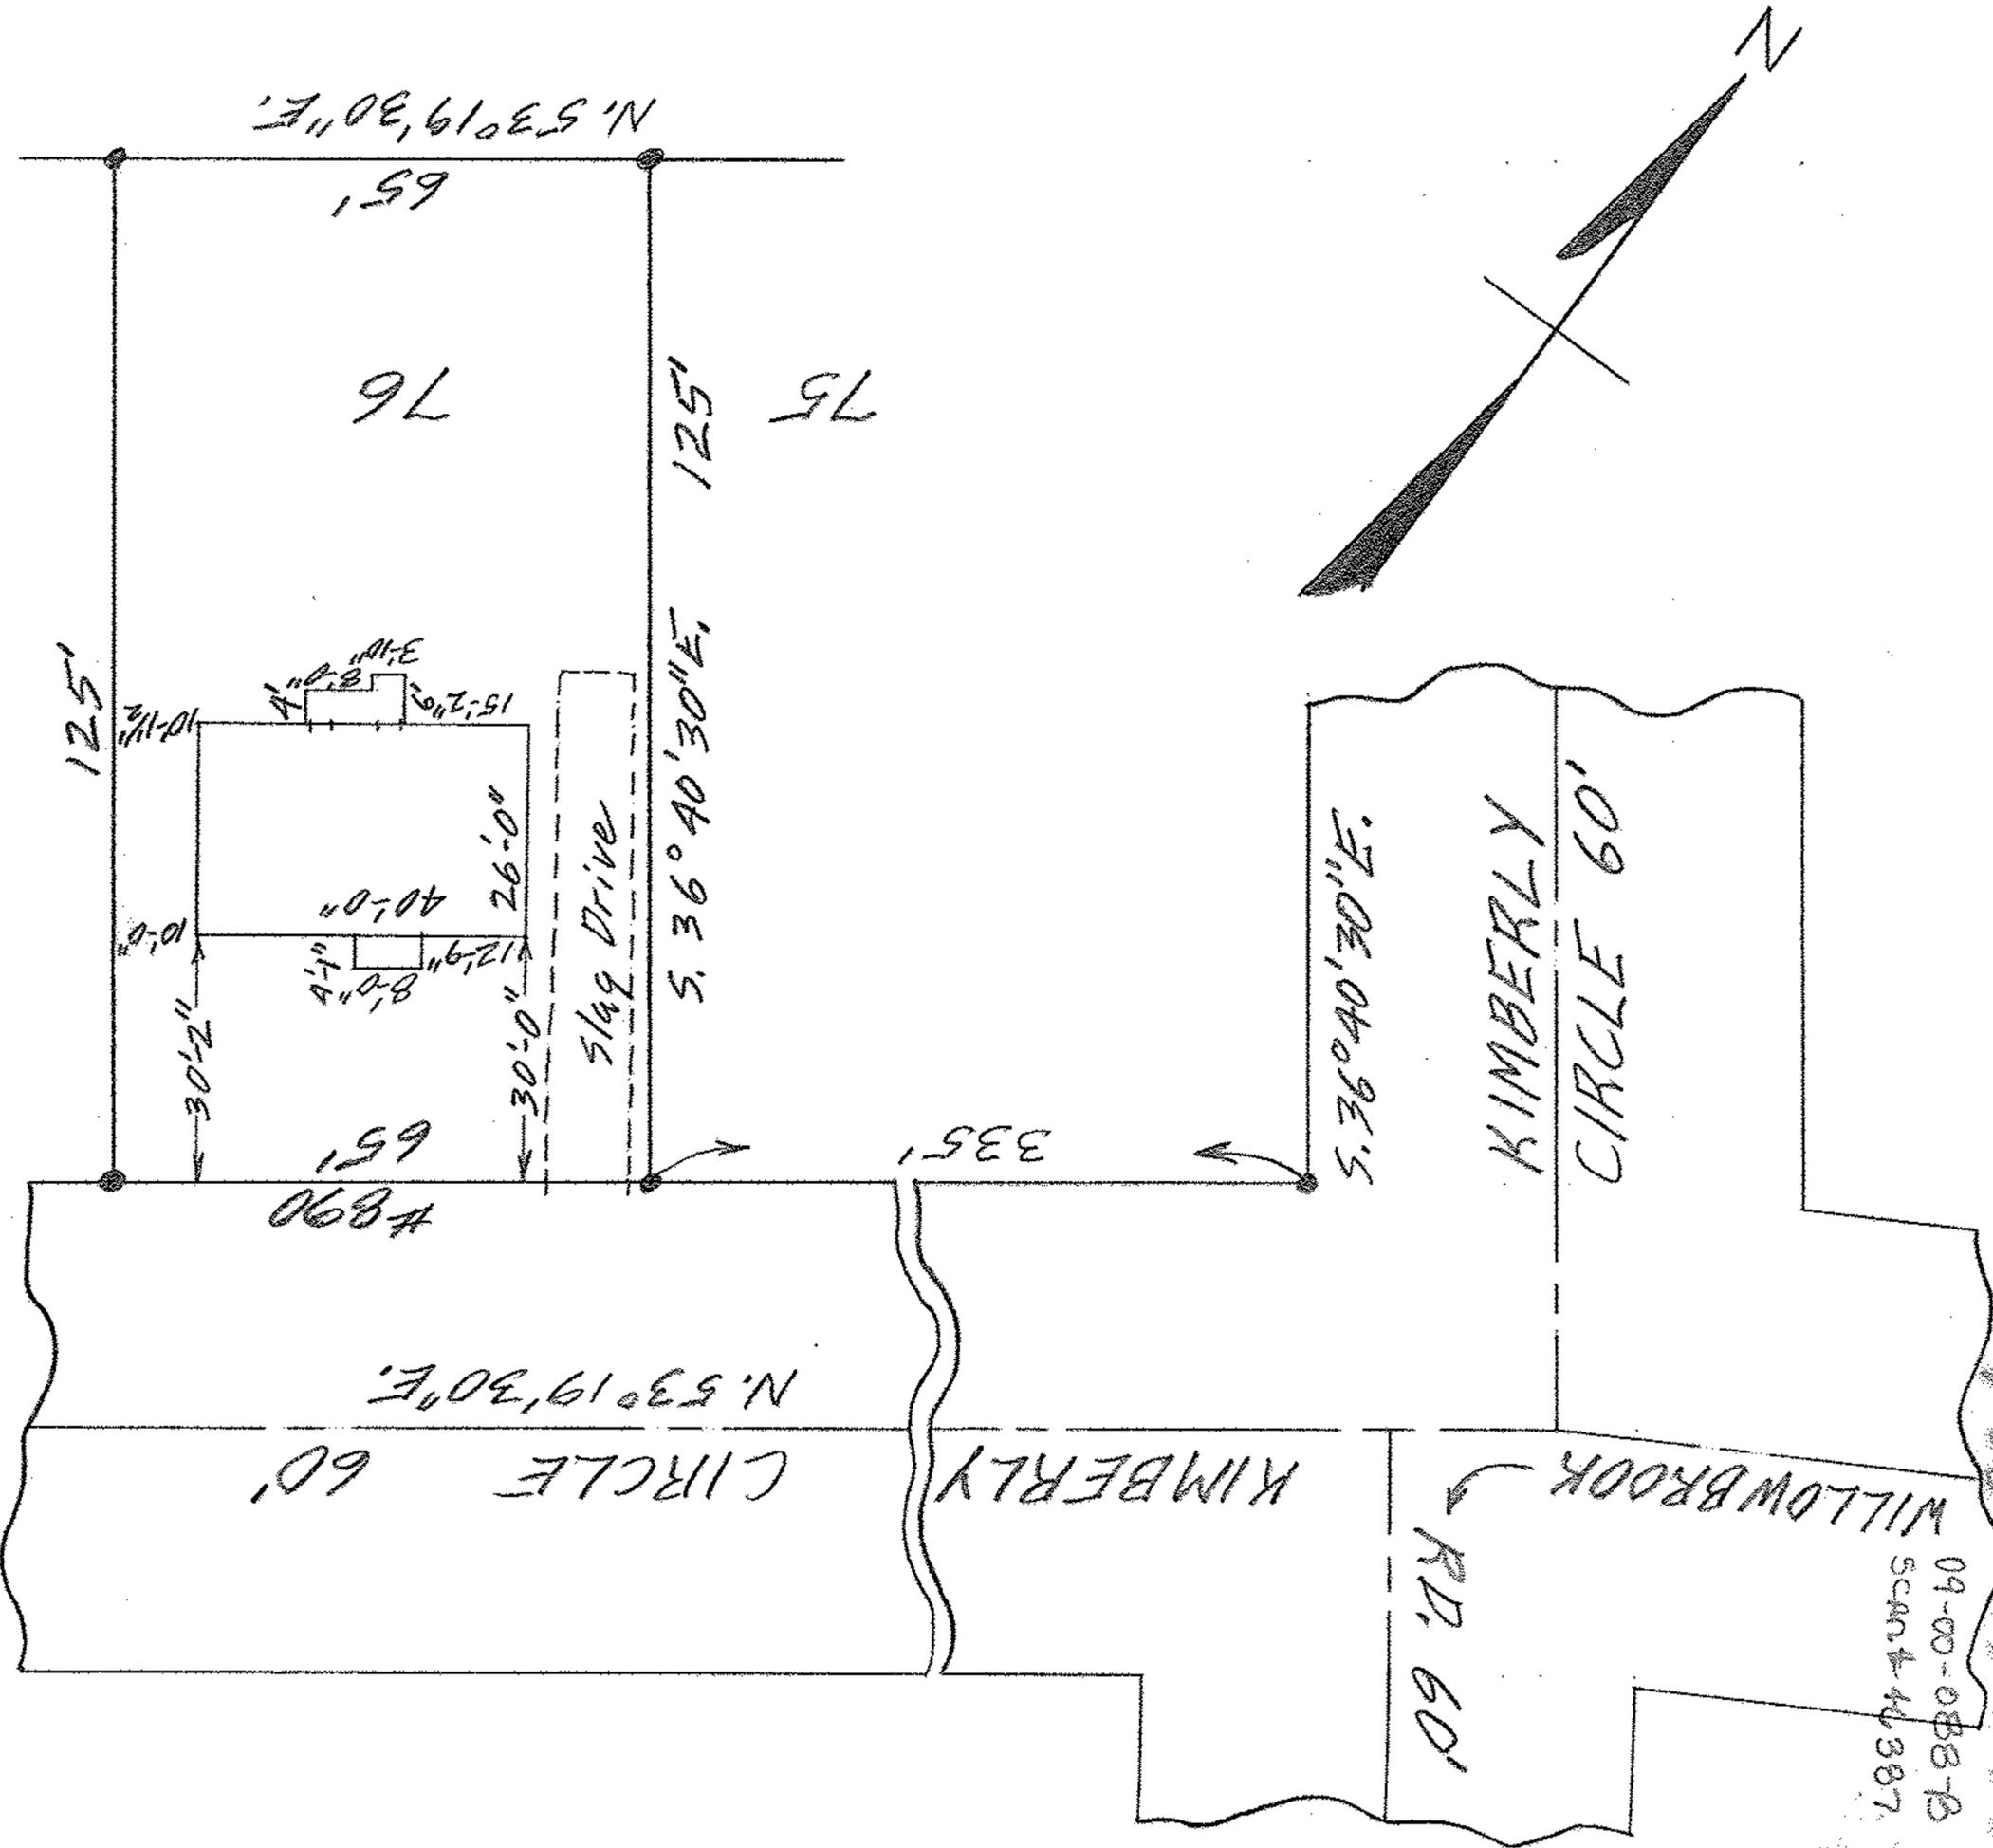

09-00-083-B
Scan # 40387

04-00-084-104-020