
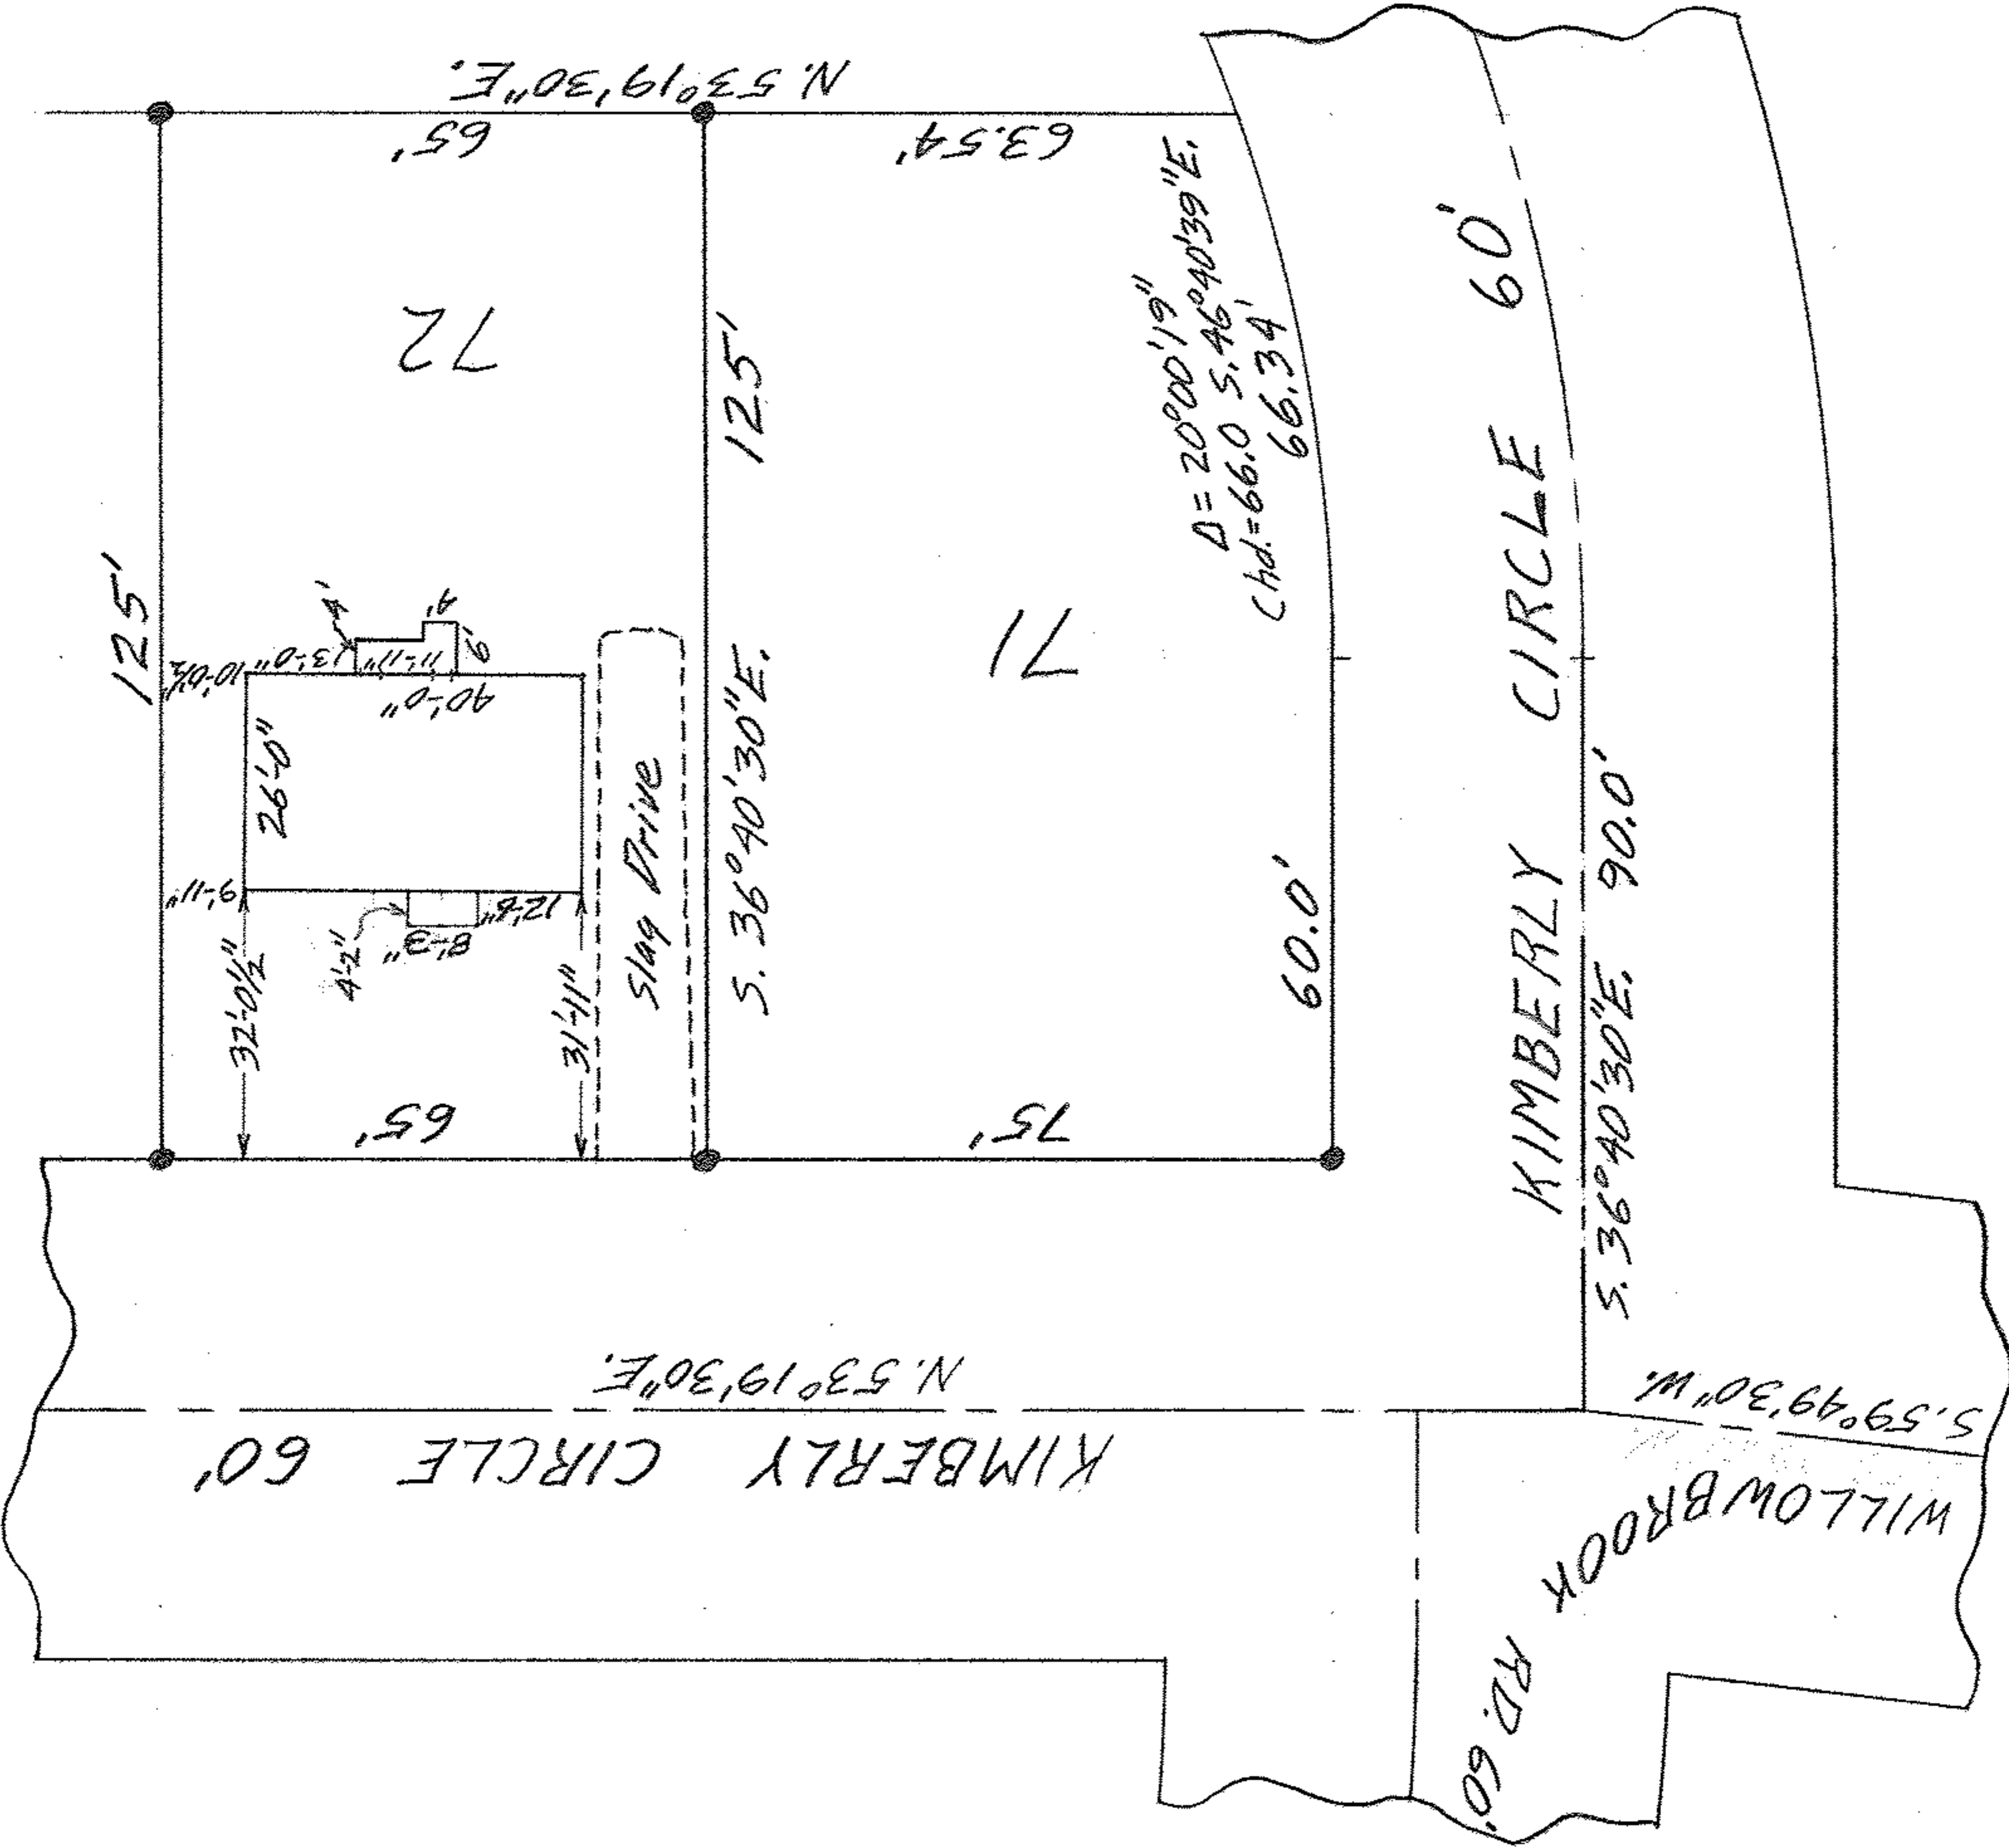



09-00-088-104-024,025
5CANT# 46388
09-00-088-0

MAP OF SUB-LOT NO. 72
WILLOWBROOK FARMS SUBN. NO. 2
VOL. 22 PG. 53 PLAT. RECORDS
O.L. 88 RUSSIA TWP - OBERLIN CITY
LORAIN COUNTY OHIO
SCALE: 1"=30'
FEB. 15-1963 12:10 P.M.
GUY E. Penfound REG. SURVEYOR

Paul D. & Katie Baker

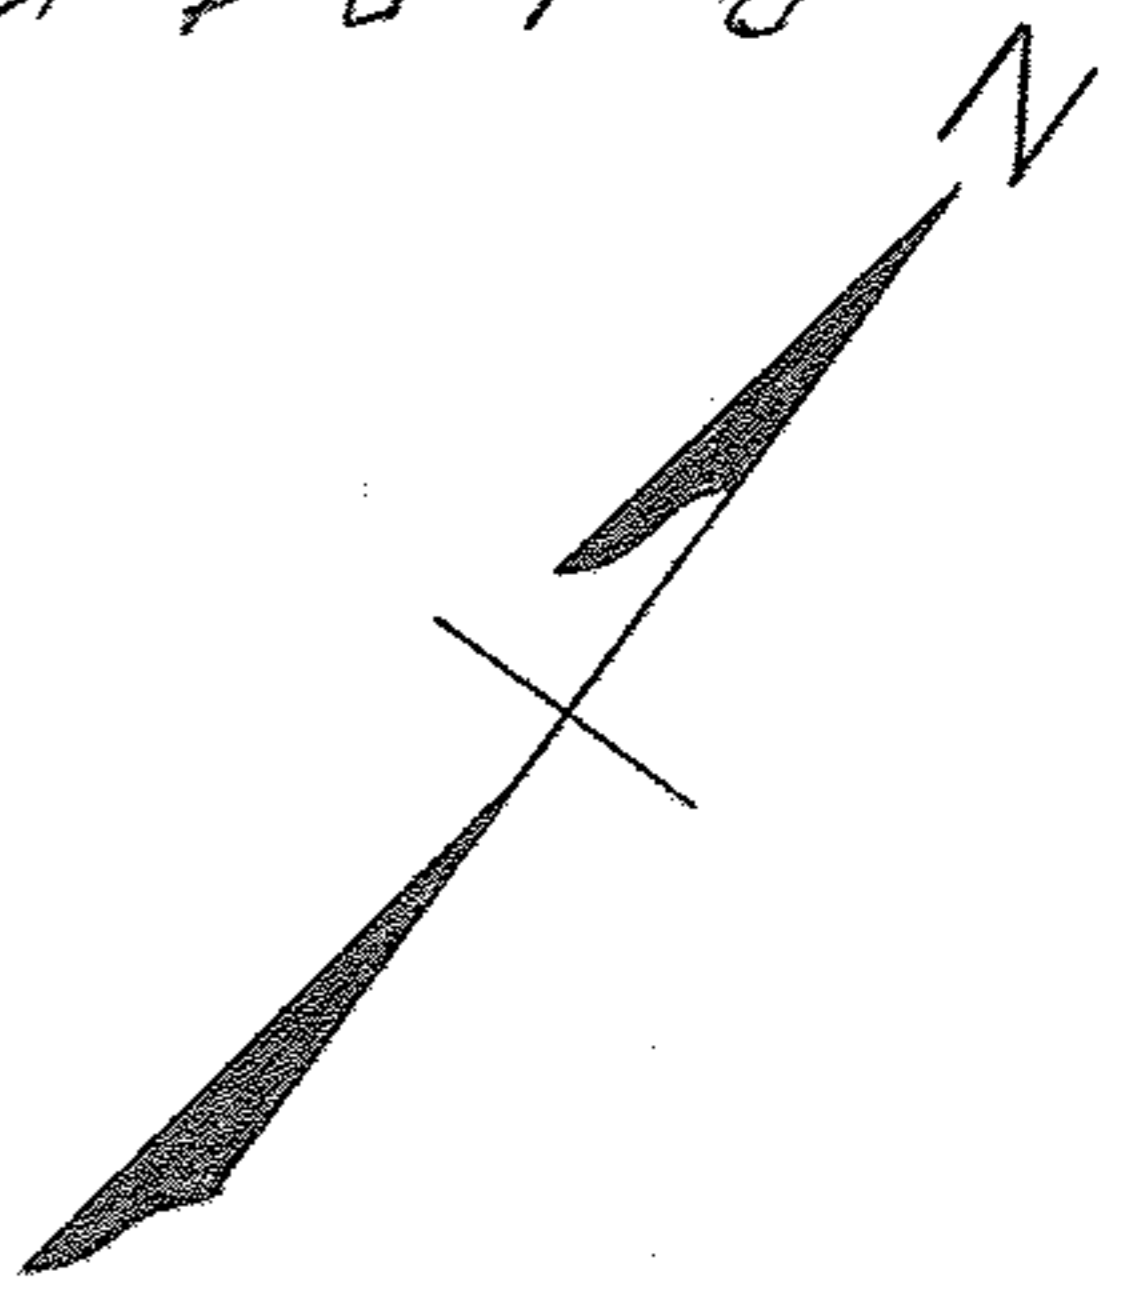

65' 63.54' N. 53°19'30"E.
125' 125' 72
65' 75' 60.0'
S. 36°40'30"E. 125'
S. 36°40'30"E. 60.0'
D = 20°00'19"
Chd. = 66.0 S. 46°40'39"E.
66.34'

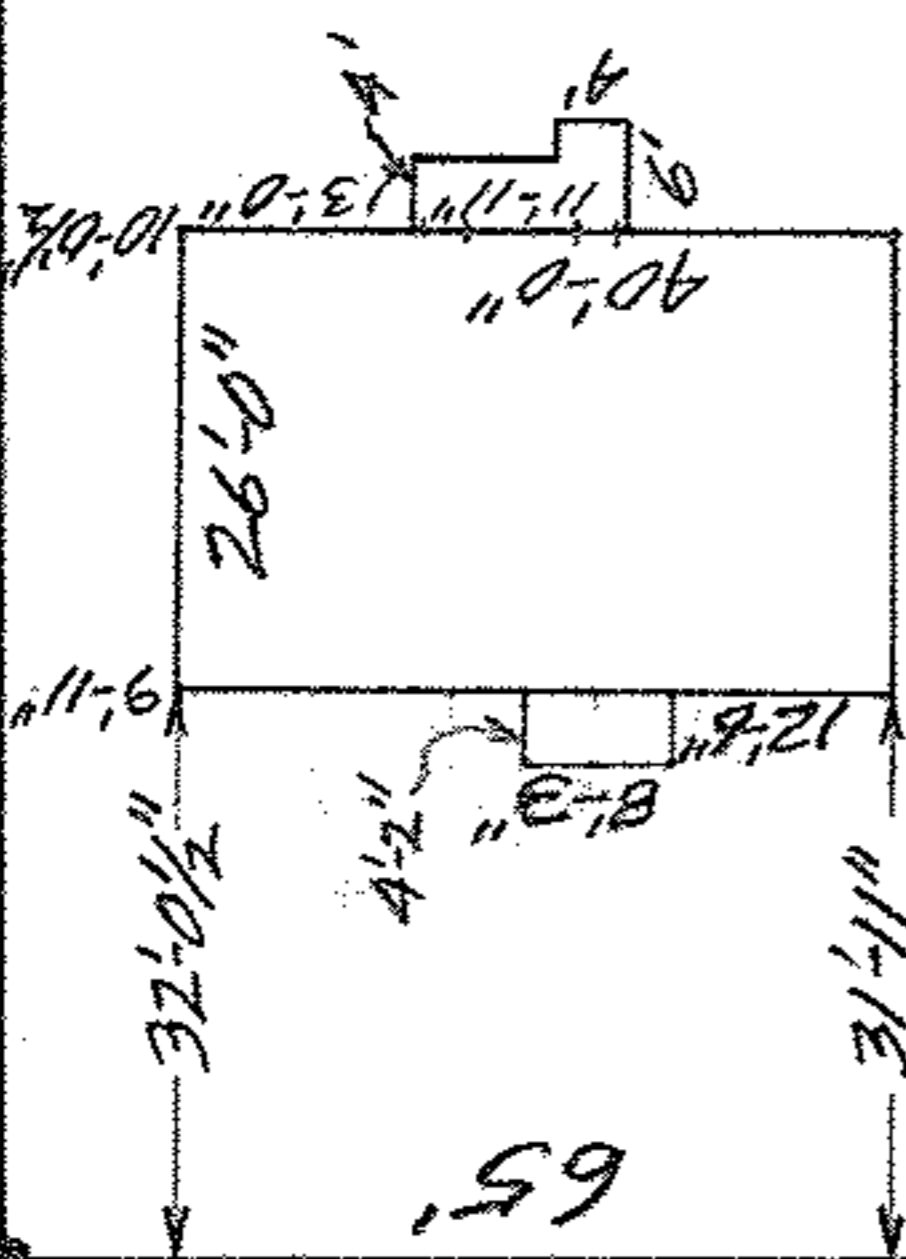

KIMBERLY CIRCLE 60'
WILLOWBROOK RD. 60'
S. 59°49'30"W.
S. 36°40'30"E. 90.0'