
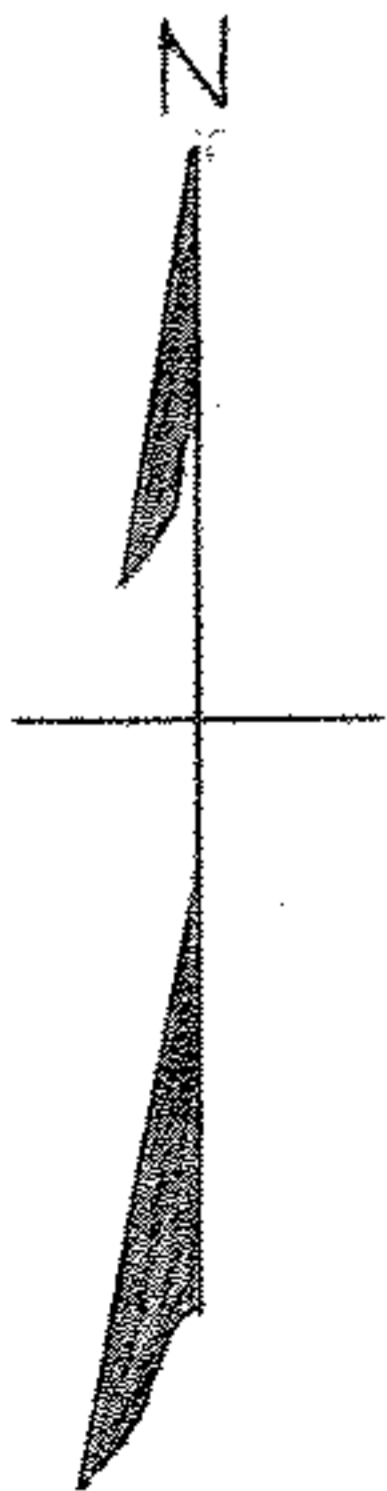


09-00-096-113-025
 09-00-094-A SCANT-46394

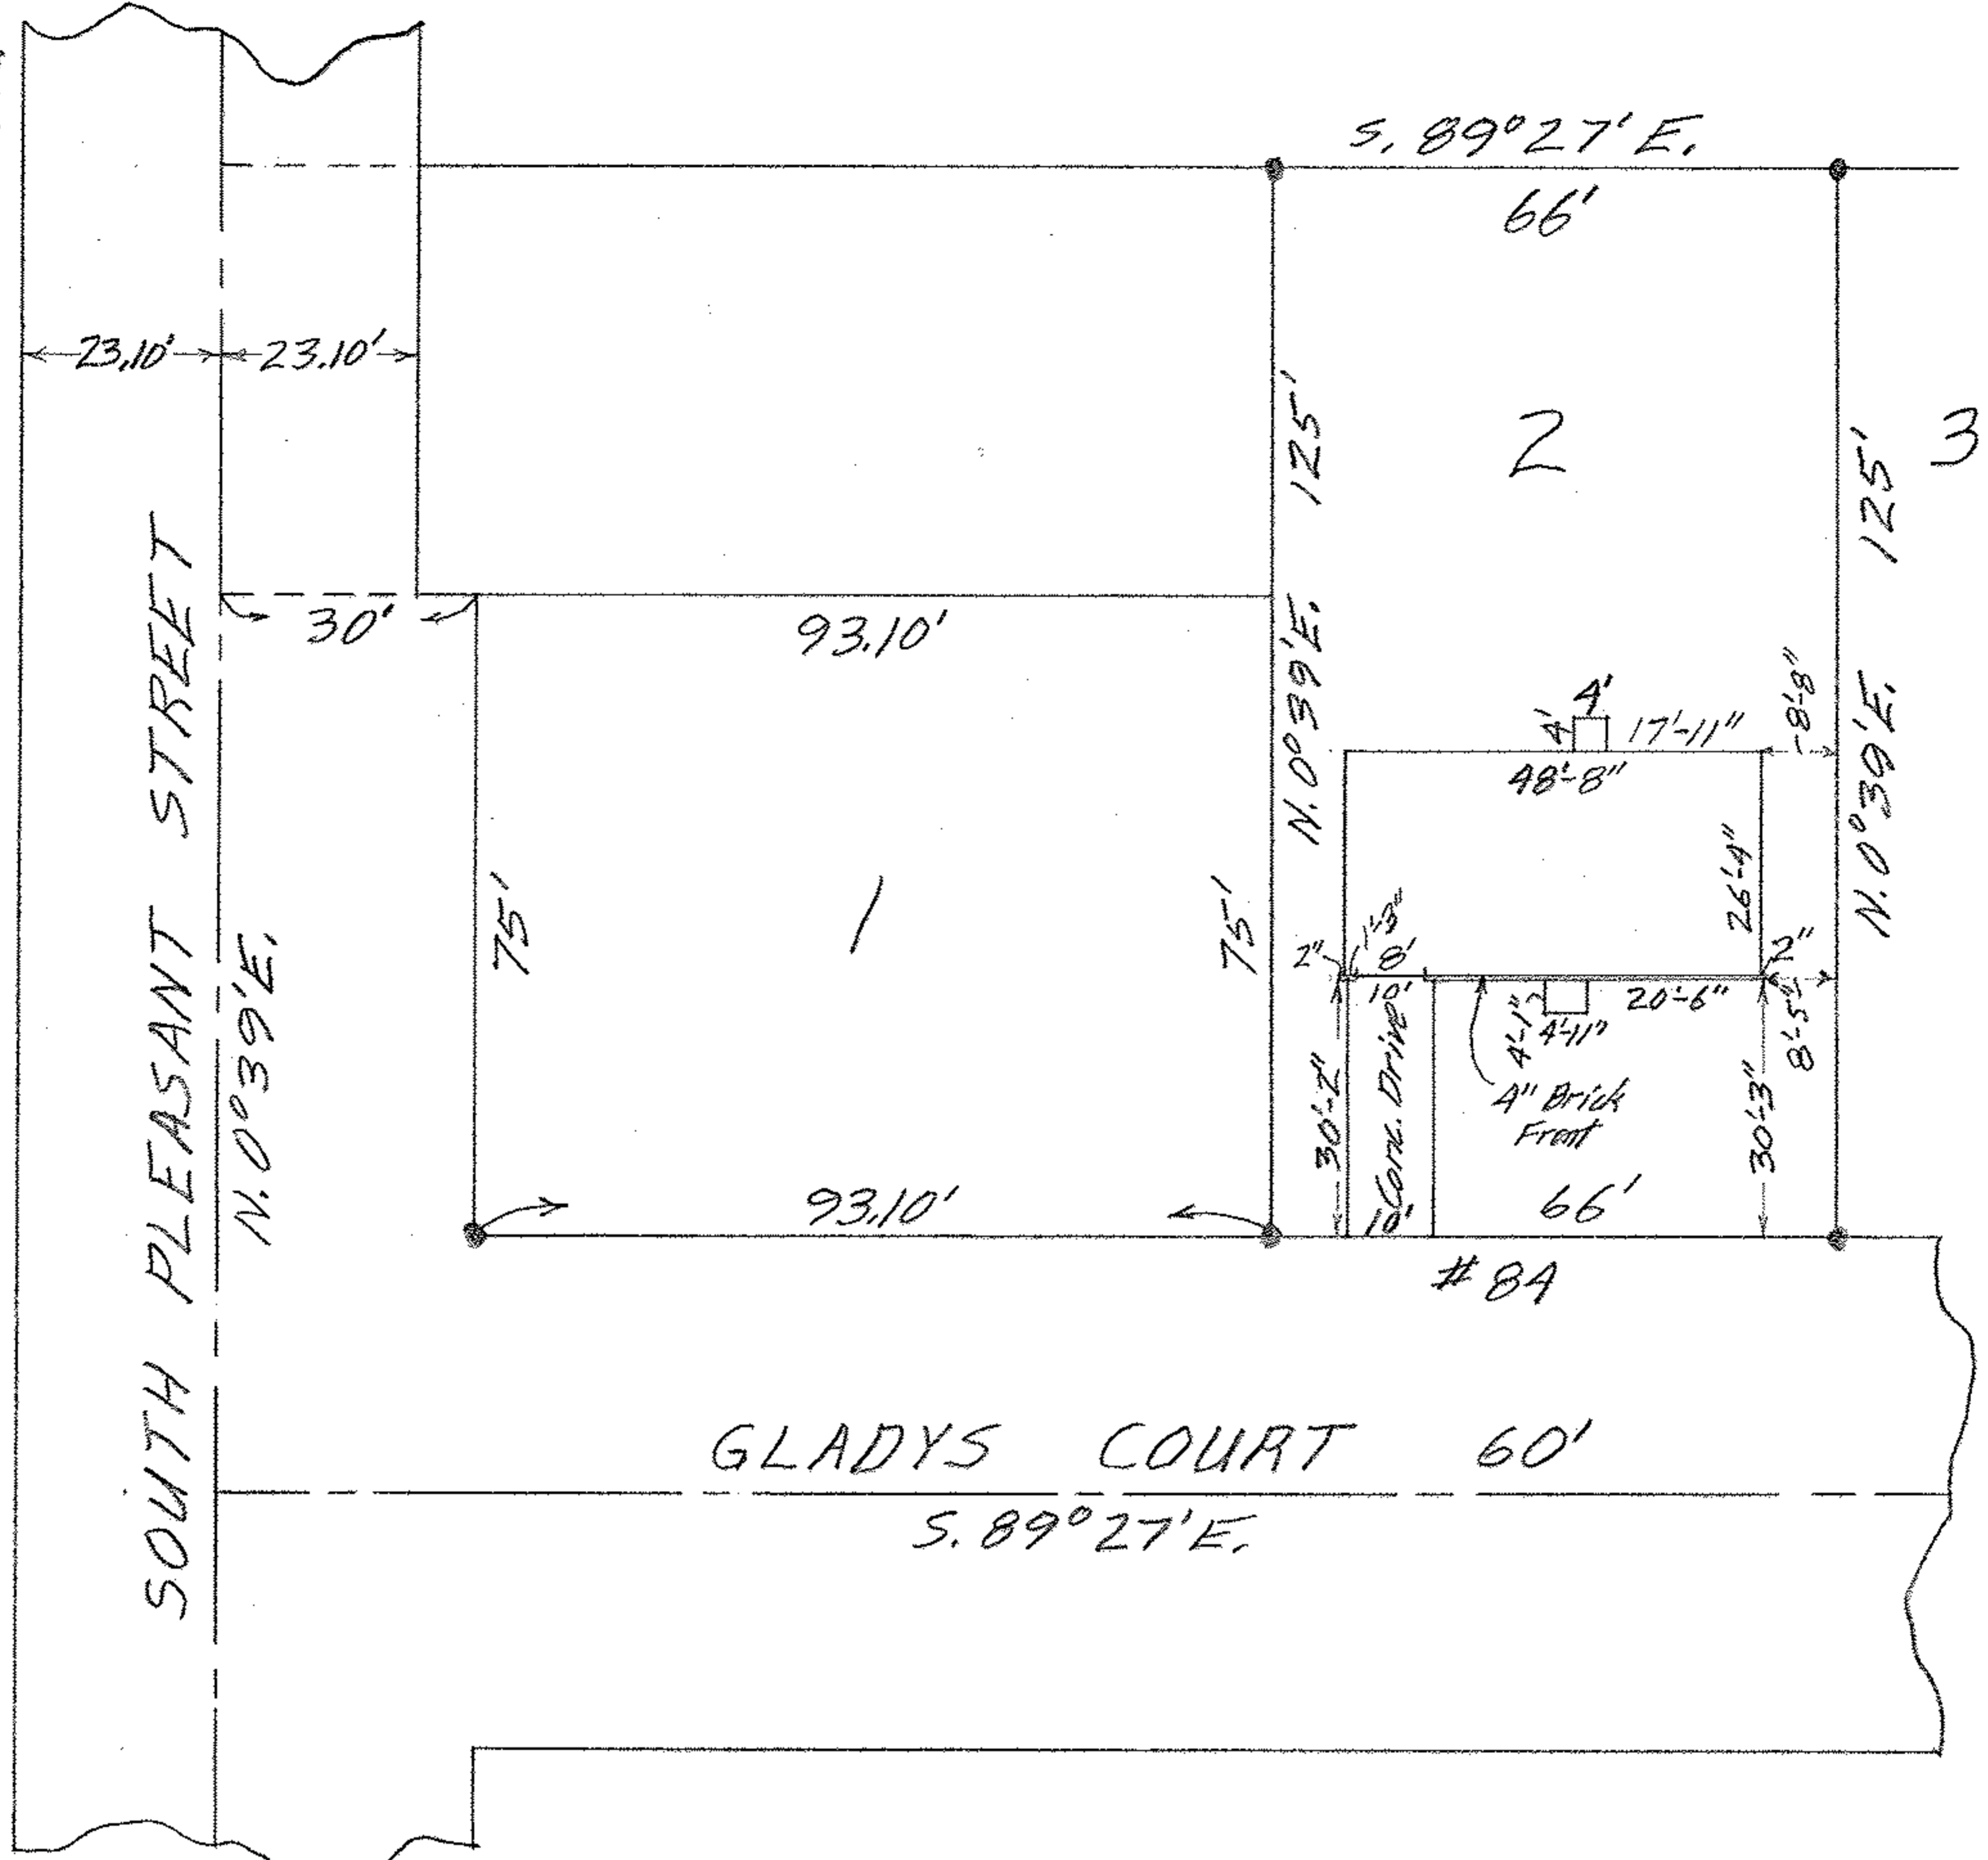

MAP OF SUB-LOT NO. 2
 GLADYS SUB'N. VOL. 21 PG. 46 PLATS
 ORIG. LOT 96 RUSSIA TOWNSHIP
 OBERLIN CITY - LORAIN COUNTY - OHIO
 SCALE: 1" = 30' JUNE 4-1962 3:15 P.M.
 Gary E. Penfound REG. SURVEYOR

Ernest Lee & Alice L. Lee WW