


10-00-003-119-031

10-00-003-D

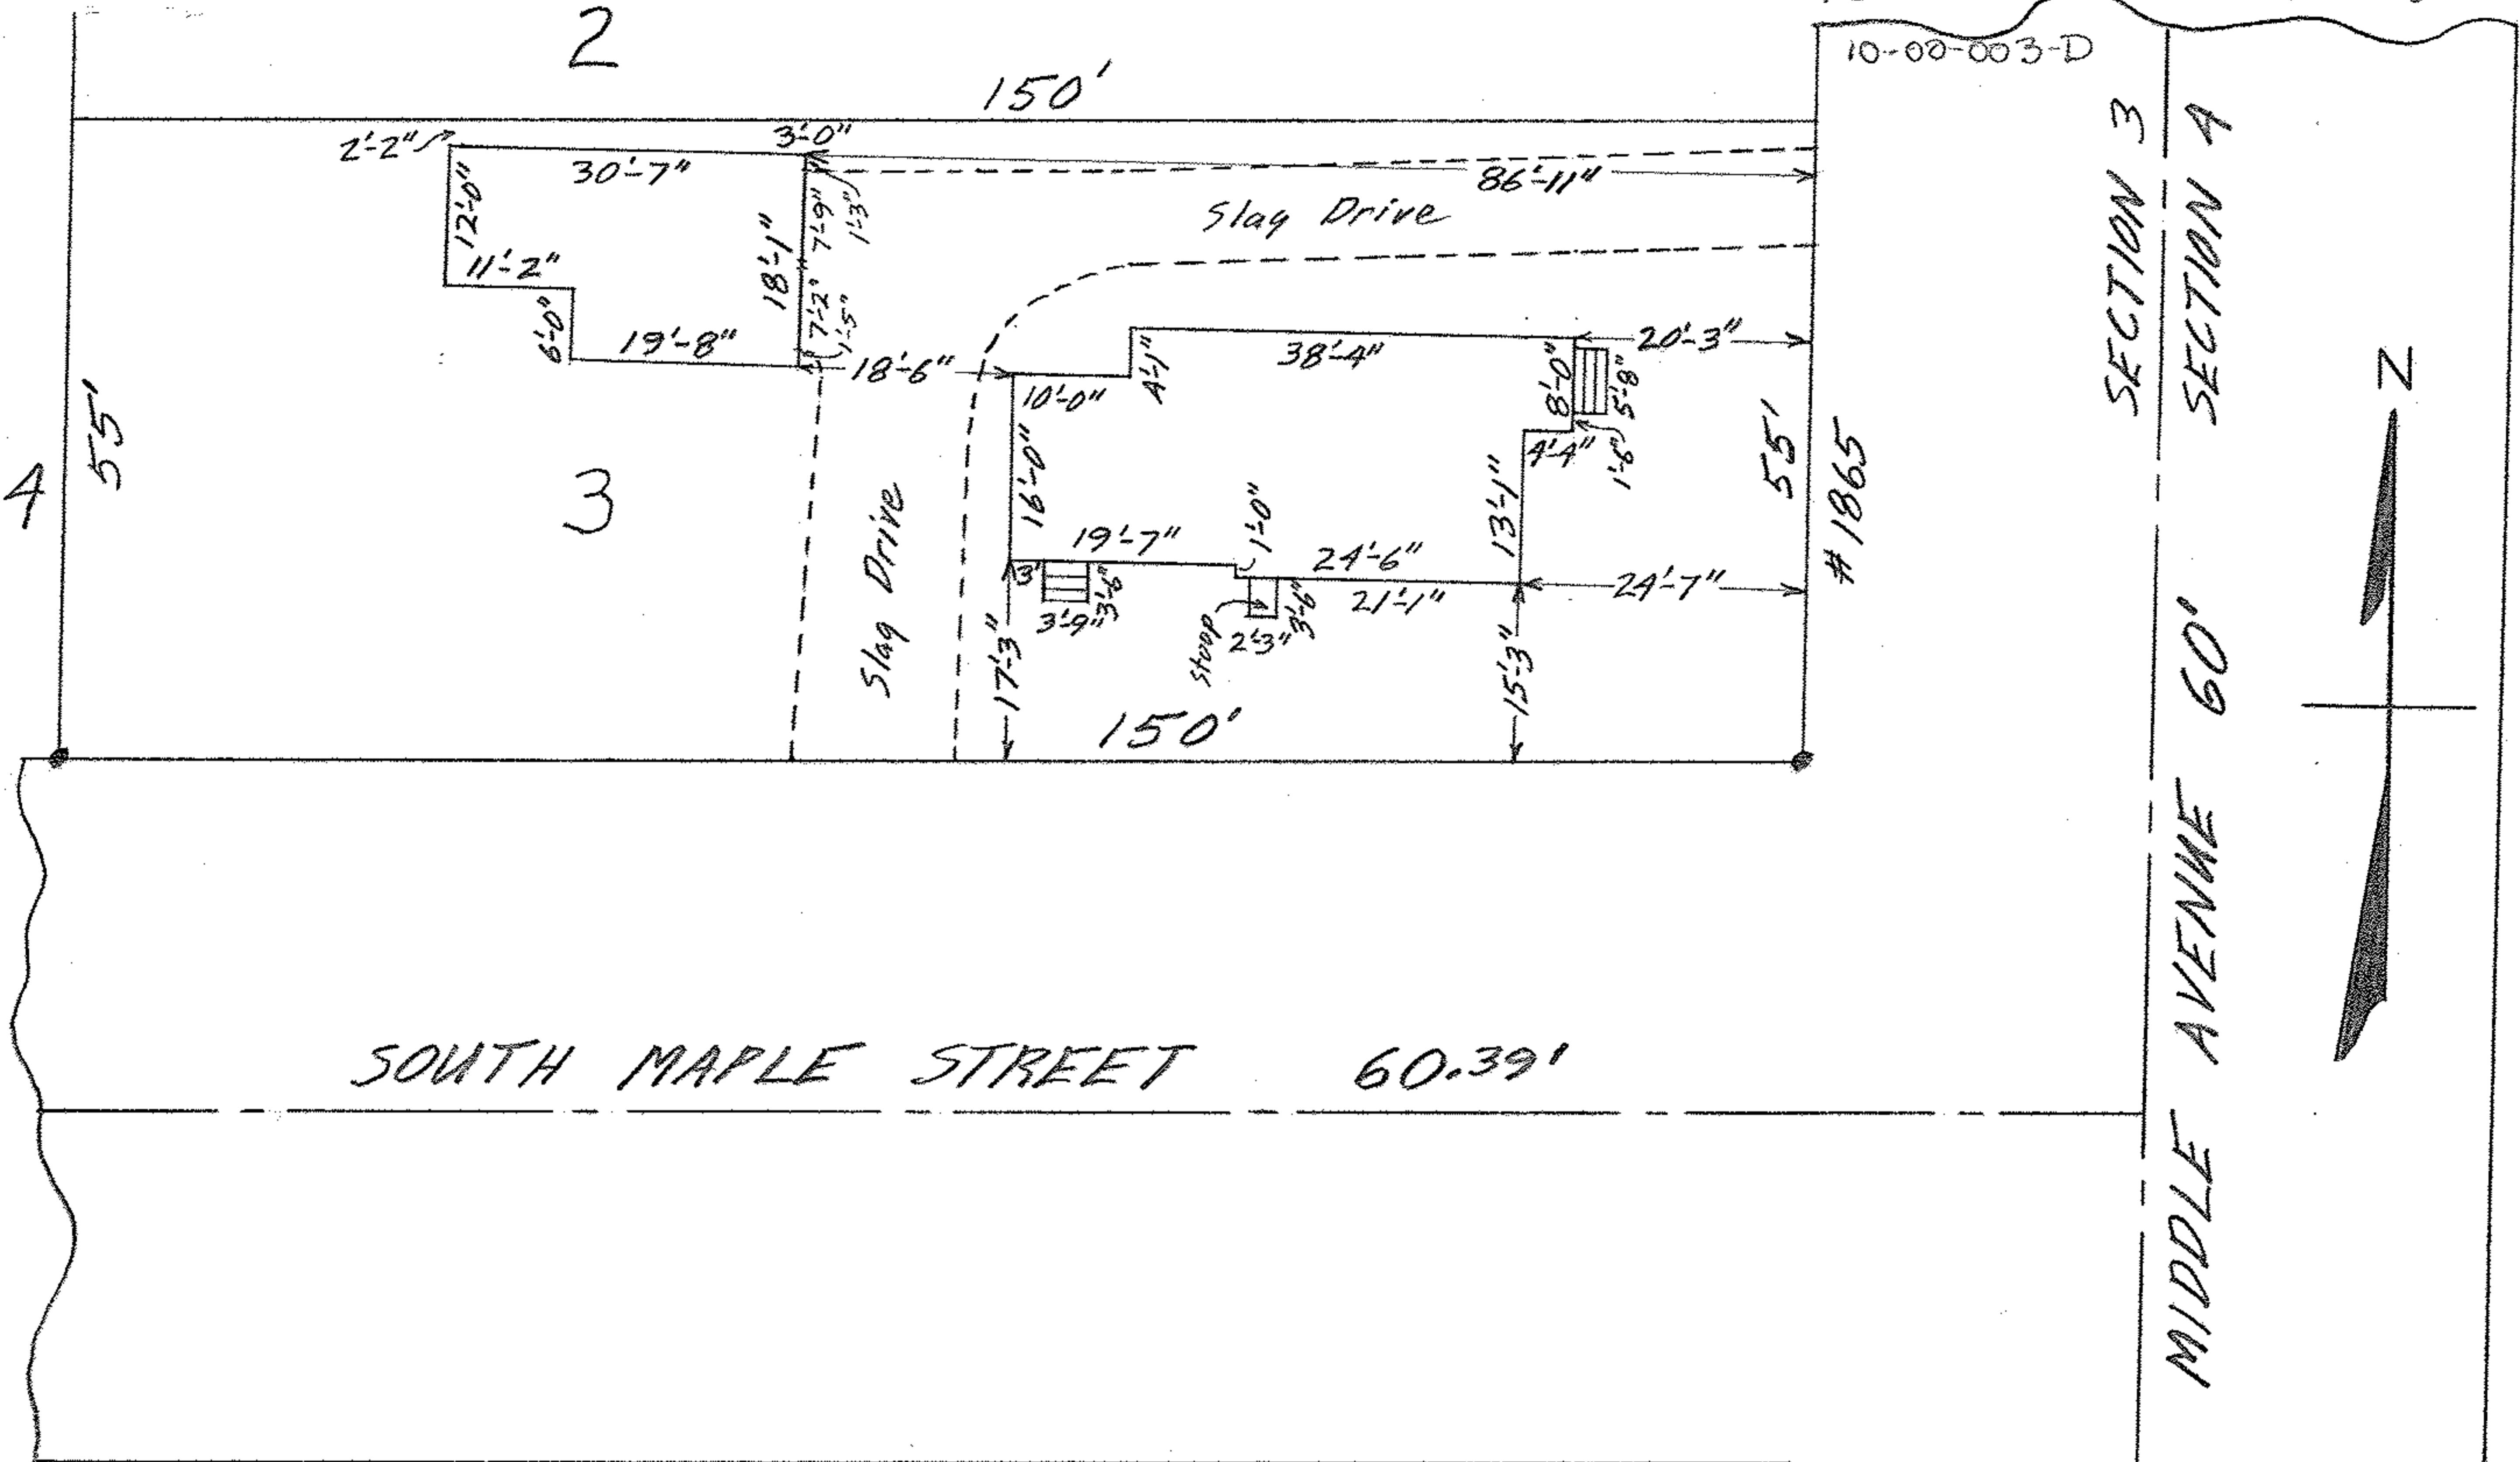

SOUTH MAPLE STREET 60.39'

SECTION 3
SECTION A
MIDDLE AVENUE 60'

MAP OF SUB-LOT No. 3 - W. H. & M. C. TUCKER'S SUB'N.
 VOL. 4 PG. 43 PLATS SECTION 3 - CARLISLE TWP.
 ELYRIA CITY LORAIN COUNTY OHIO

SCALE: 1" = 20'

FEB. 11-1963 12:15 P.M.

Gary E. Penfound

REG. SURVEYOR

W W
Gardner & Marva E. Caywood