


10-00-003-117-009  
 10-00-003-D  
 SCANT# 46413

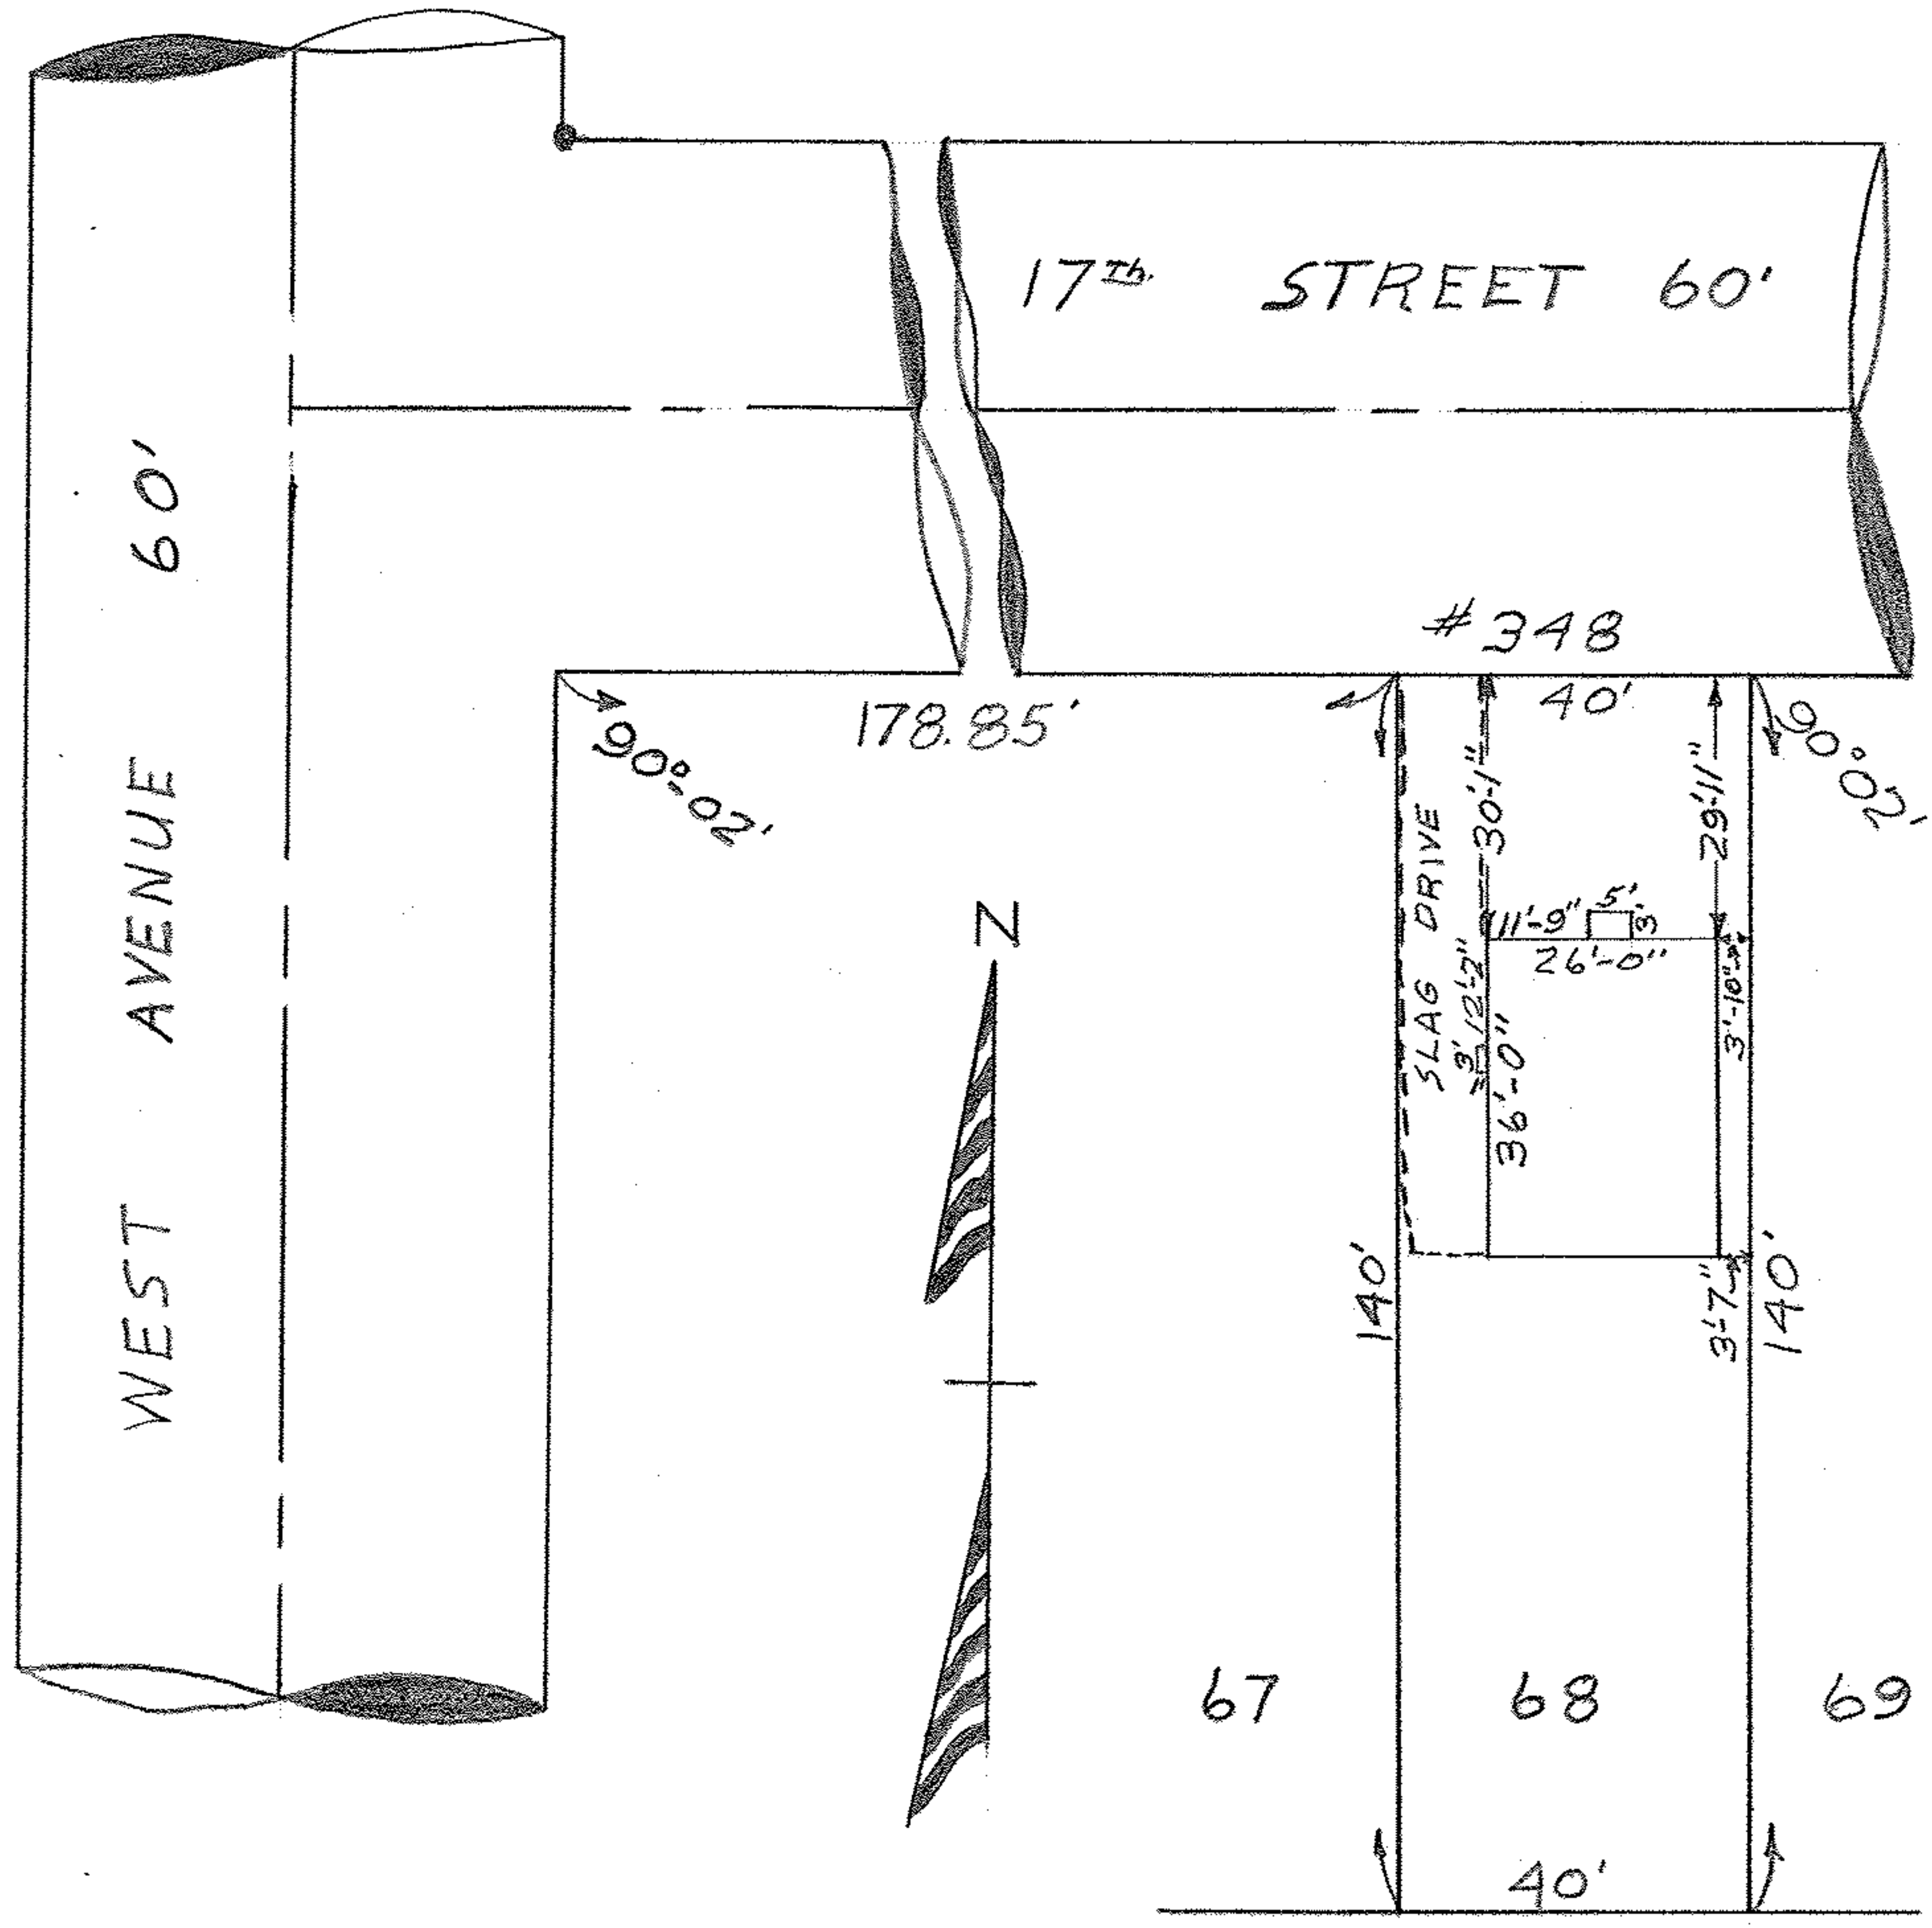

MAP of SUB-LOT 68

GEORGE H. ELY TRUSTEE'S SUB'N Vol. 5 Pg. 5 PLATS  
 PART of Sec. 3 CARLISLE TWP.  
 ELYRIA CITY - LORAIN CO. OHIO

Scale: 1"=30' Dec. 3, 1962 10:30 A.M.

Gary E. Penfound Registered Surveyor