


10-00-003-115-036
 10-00-003-C, SCAN # 44414

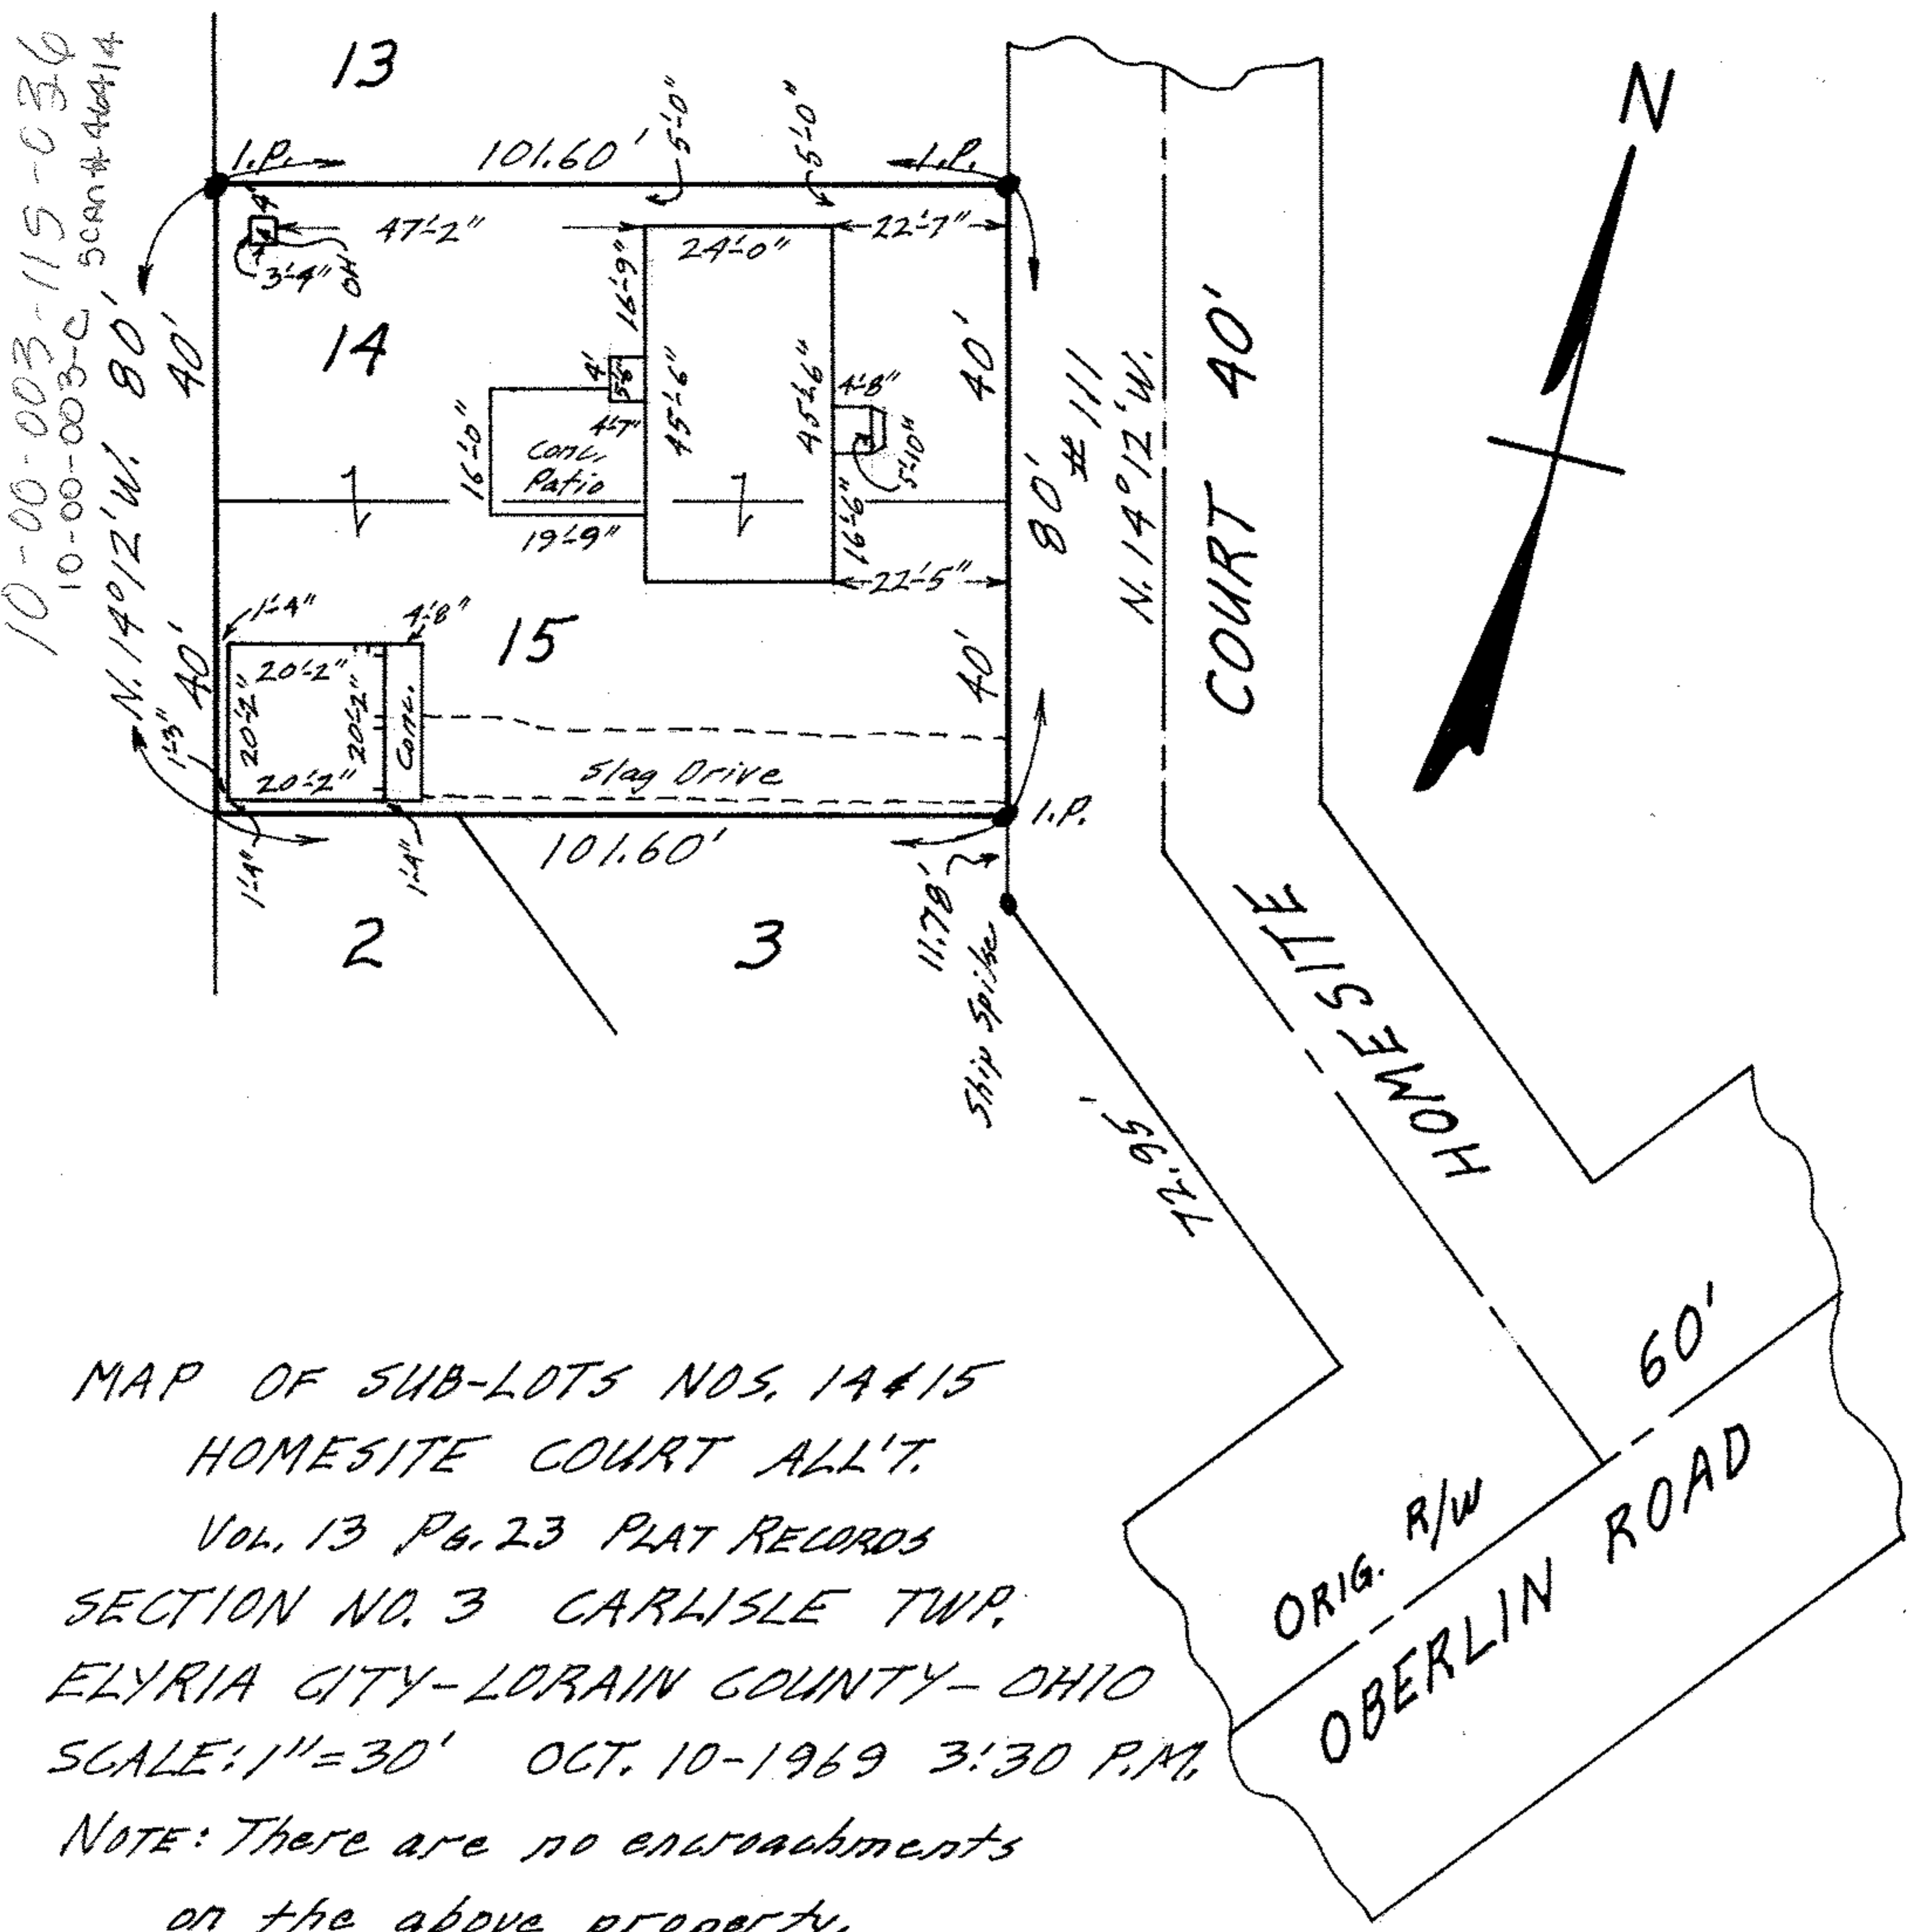

MAP OF SUB-LOTS NOS. 14 & 15
 HOMESITE COURT ALL'T.
 Vol. 13 Pg. 23 PLAT RECORDS
 SECTION NO. 3 CARLISLE TWP.
 ELYRIA CITY-LORAIN COUNTY-OHIO
 SCALE: 1"=30' OCT. 10-1969 3:30 P.M.

NOTE: There are no encroachments
 on the above property.

Gary E. Penfound REG. SURVEYOR NO. 4457

CITY TITLE CO. Order No. E-887-8
 Michael & Grace E. Bizzo to
 William & Henrietta Massey