

SCALE: 1" = 100'



HIGHLAND DEVELOPMENT
O.R.V. 782 P. 392
PCL. 2

357.95' C.
357.85' R.

3/4" ROD
FD.
0.53' W
N. 10° 59' 31" E

N. 89° 01' 00" W

225.91' R.
S. 89° 01' 00" E

89° 19' 30"
R 2 U. 30"

3/4" I.P.FD. 2 U.

131.94' R.

131.90' C.
131.94' R.

1/2" I.P.FD.
0.16' SW. S. 89° 01' 00" E
U. FOR
LINE

25

CURVE "A":
R=60.00
A=50.00
Δ=47°44'47"
C=48.57'
S-68°30'21"-W

0.97 AC.
466.5' R.
466.59' C.
199.31' U.

REBAR SET
P. 548
555.20' R.
1.18 AC.
555.28' C.
290.39' U.
N. 41° 42' 18" E C.

290.39' R.
N. 41° 42' 18" E C.

WILDWOOD ESTATES
SUBDIVISION NO. 2
P.V. 35 PP. 45 & 46

190.71' R.
250.71' R.
250.74' C.

27-21463

APPROVED
LORAIN CO.
MAP DEPT

DATE 8-24-95

PAGE 10-00-005 E

BY CAROLYN
FRANCIS

#21463

BOUNDARY SURVEY


OF PART OF
CARLISLE TOWNSHIP
SECTION NO. 5

TOWNSHIP OF CARLISLE COUNTY OF LORAIN
STATE OF OHIO

10-00-005-107-

PREPARED BY:
KS ASSOCIATES INC.
ENGINEERS SURVEYORS

David L. Elwell
REG. SURV. NO. 6333

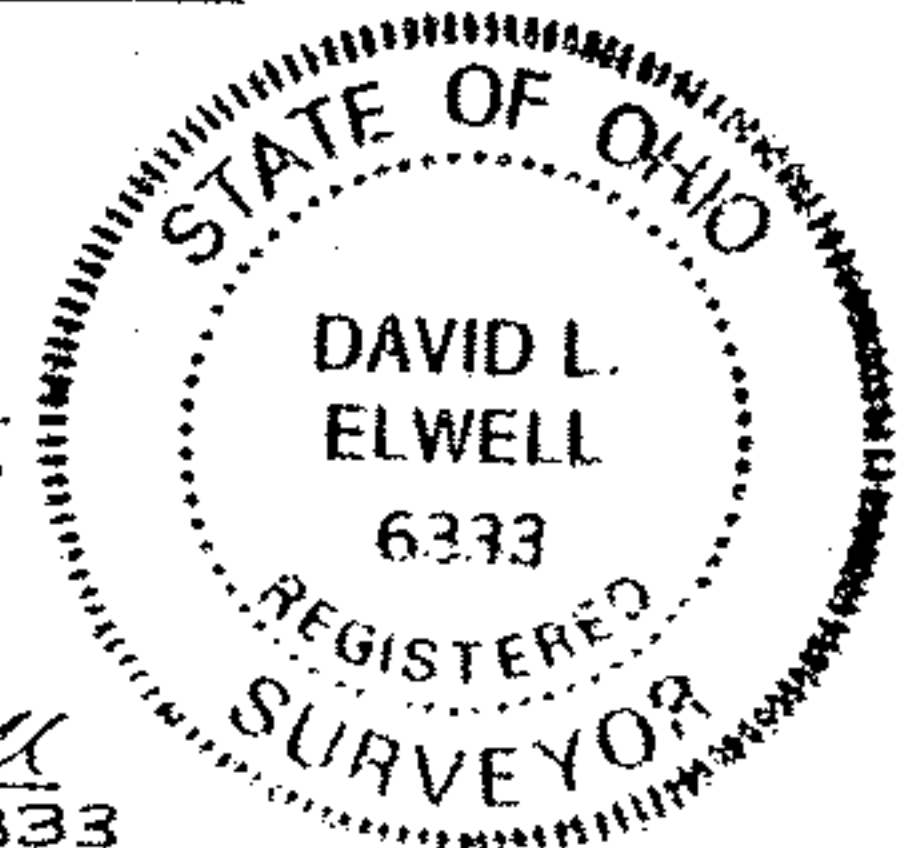

ASPEN CT.
NO. MON. FD.

06-22-95

95-173

10-00-005-107-357, 258

D.V. DONALD L. & ISABELLE G. MILLER
0.61 AC.
265.08' R.
S. 41° 42' 18" W
D.V. 518 P. 207
0.61 AC.
265.08' R.
N. 46° 46' 53" W

D.V. PAUL E. & STEPHAN N. & LORETTA N. DOCS
0.61 AC.
265.08' R.
N. 41° 42' 18" E
D.V. 518 P. 211
0.61 AC.
265.08' R.
N. 46° 46' 53" W

1.01 AC.
STEPHAN N. & LORETTA N. DOCS
D.V. 1210 P. 215
N. 41° 42' 18" E

DONNA J. STEWART
0.6105 AC.
88° 30' R.
88° 27' 11" C.
239
S. 41° 42' 18" W
D.V. 607
264.81' R.
264.89' C.
240.30' R.

EAST RIVER ROAD
DEED # 415'
100.0' R.
200.0' R.

