

MAP OF SUB-LOTS NOS. 156-157-158-159 & 160 OF MEADOW VIEW ALL'T.

VOL. 12 PG. 7 PLATS

SECTION NO. 9 CARLISLE TOWNSHIP



LORAIN COUNTY OHIO

SCALE: 1"=40' SEPT. 30-1969 3:15 P.M.

NOTE: There are no encroachments on this property.

Gary E. Penfound
REG. SURVEYOR NO. 4457

10-00-009-112-014
10-00-009-01
Scan# 46463

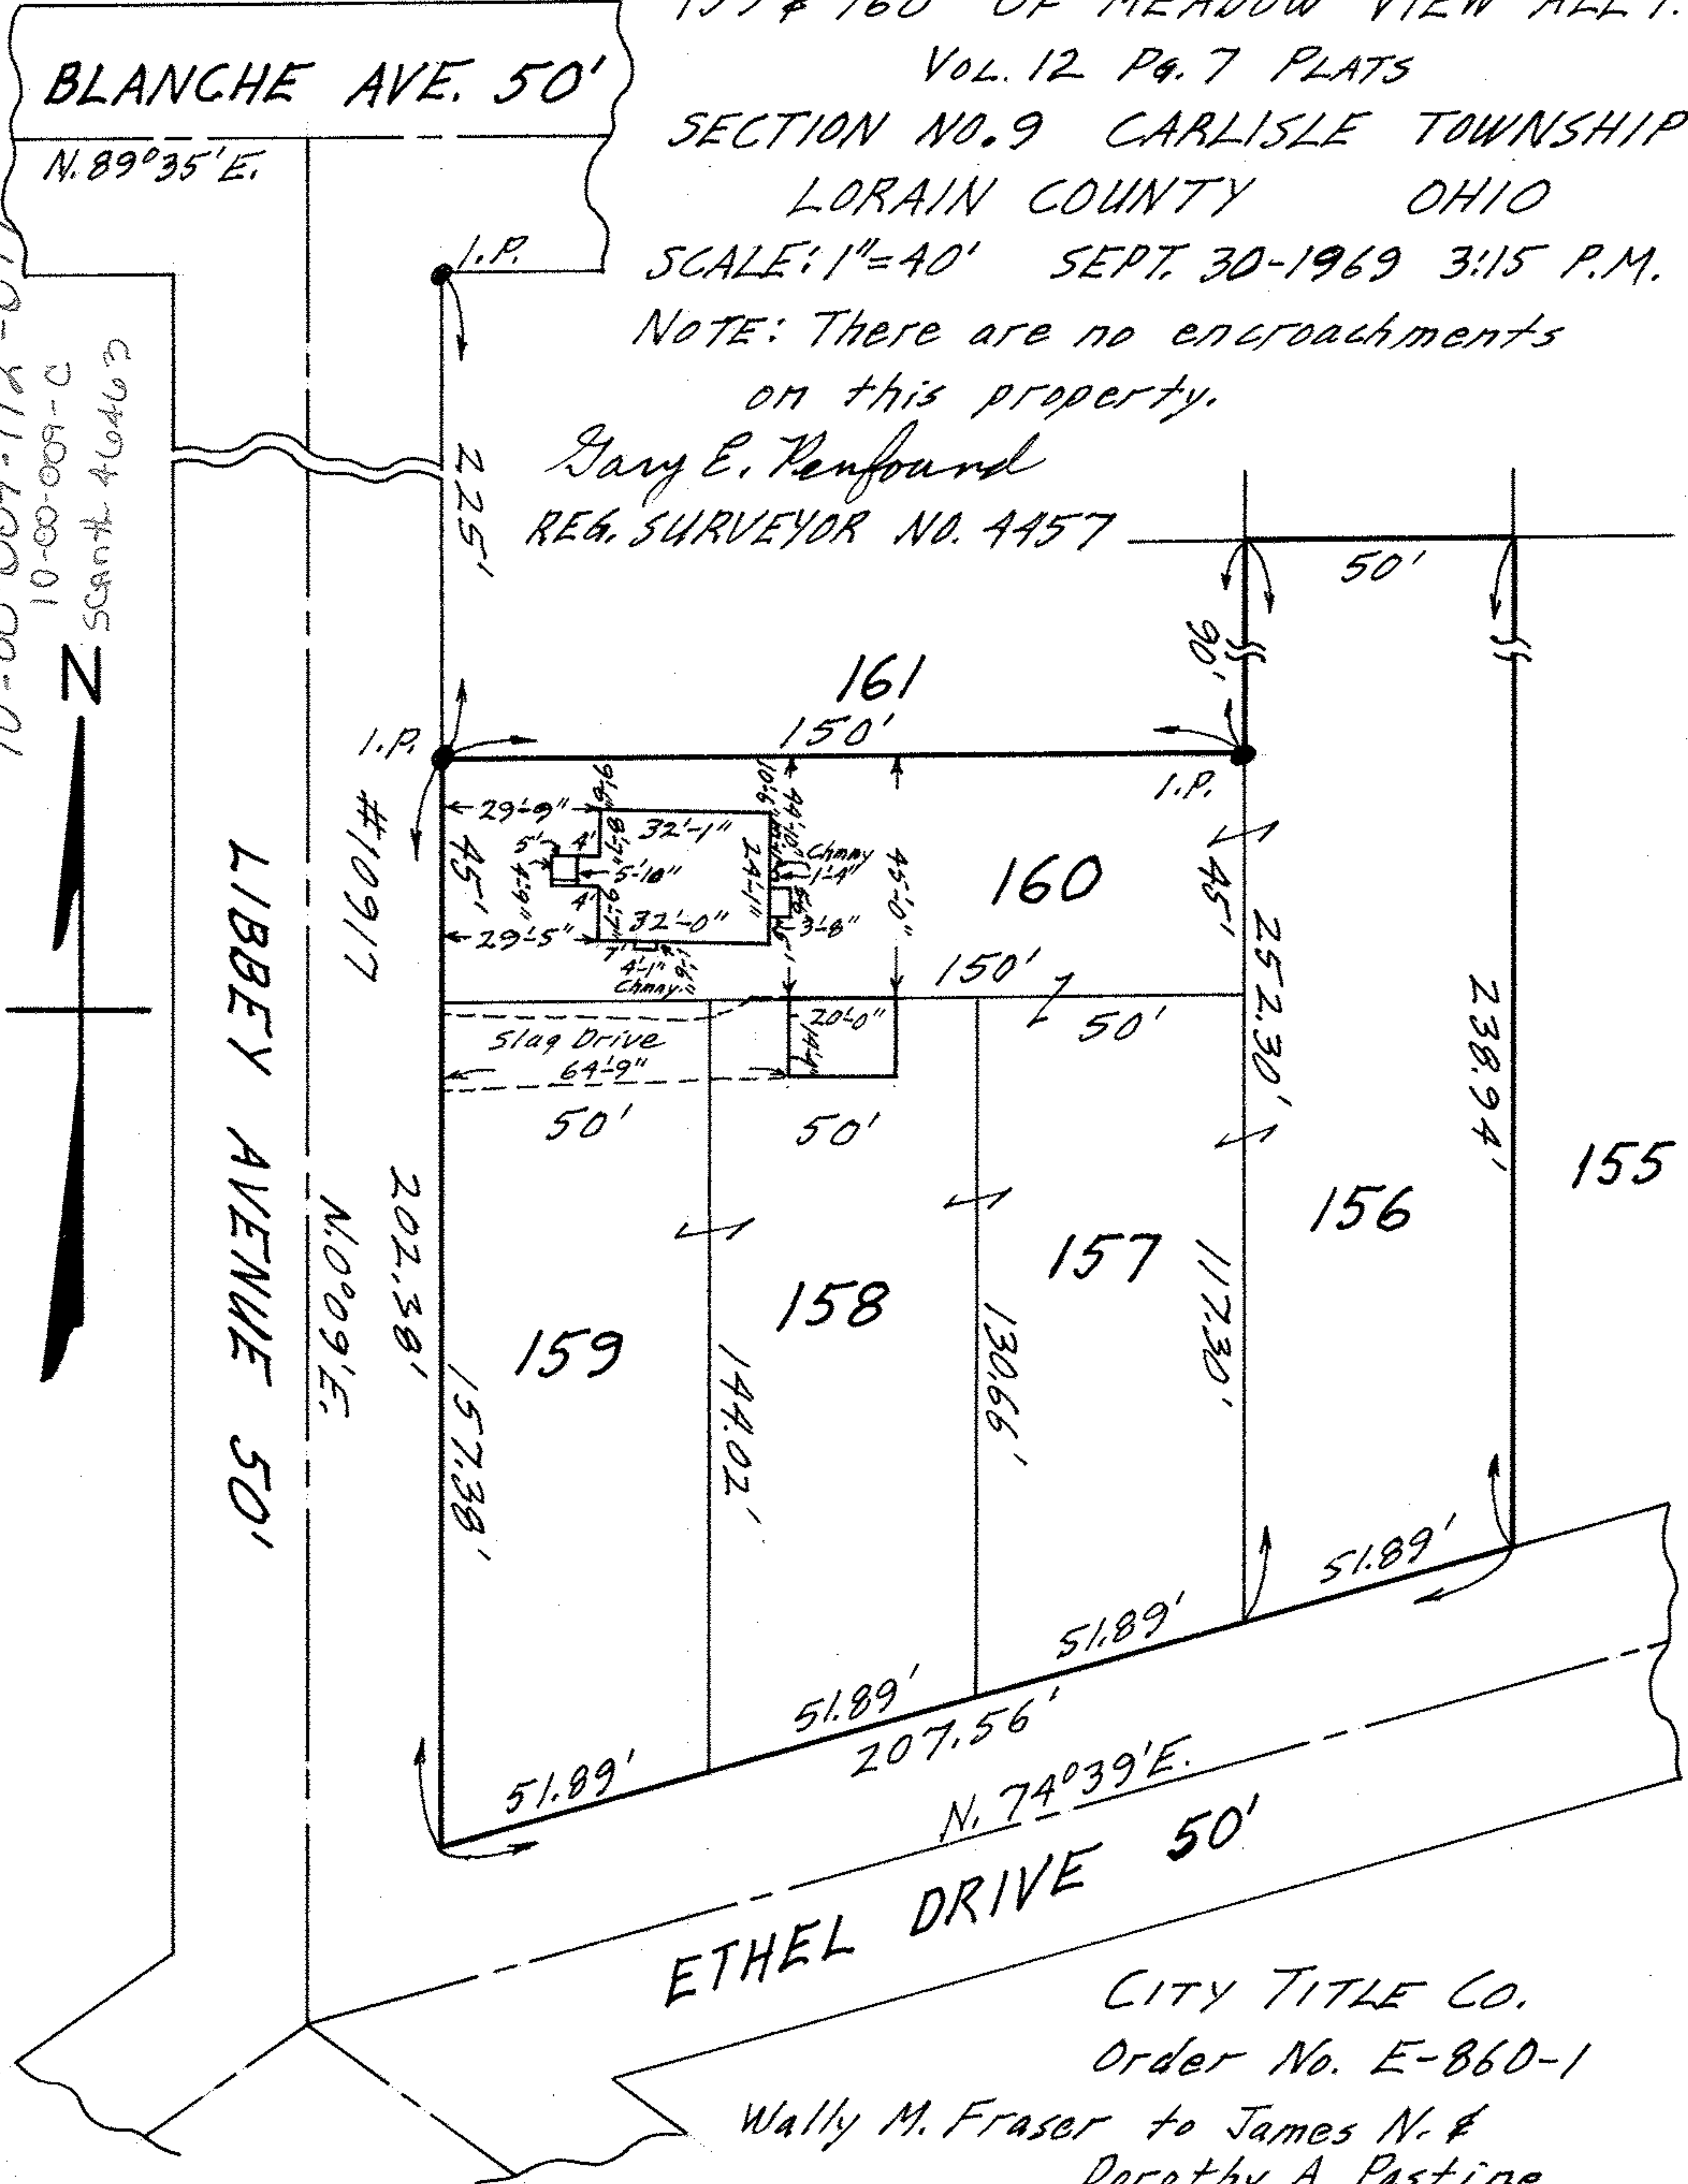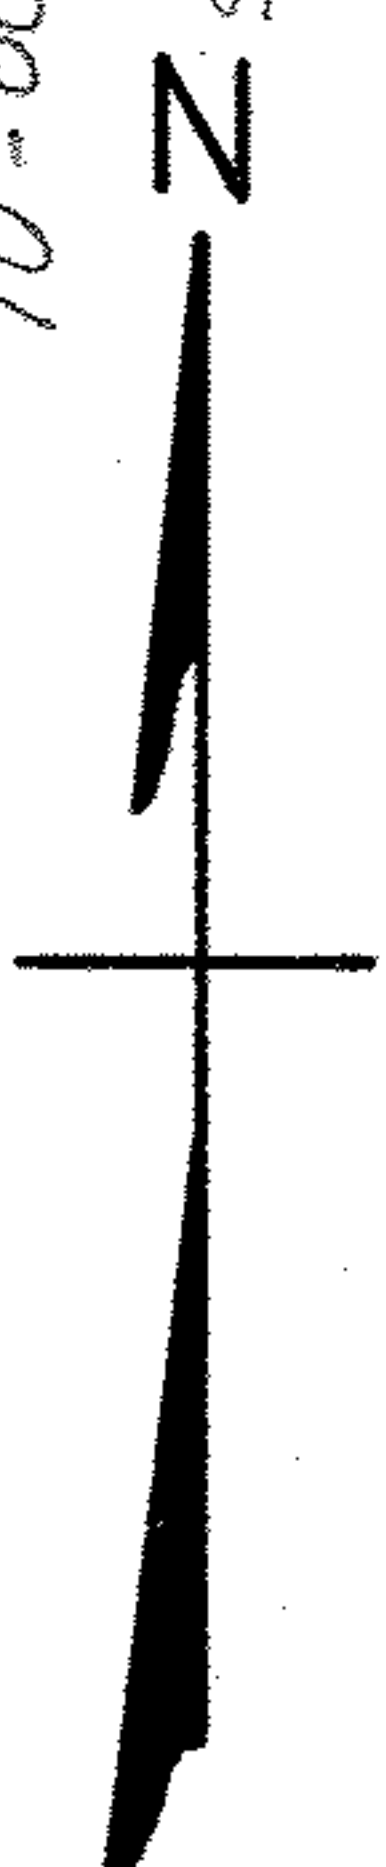

ETHEL DRIVE 50'

CITY TITLE CO.
Order No. E-860-1

Wally M. Fraser to James N. &
Dorothy A. Pastine