


Note: Existing shared driveway.

Line	Bearing	Distance
1	N 38°21'48"W	11.10'
2	N 38°25'00"W	31.41'
3	S 40°40'00"E	30.00'
4	S 38°25'00"E	30.02'

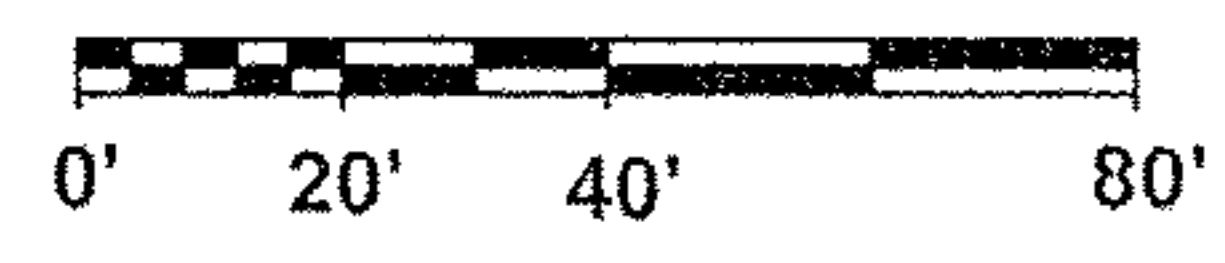

Scale: 1" = 40'  
March 29, 2010

Point	Northing	Easting	Description
1	5000.00000	5000.00000	PT
2	5048.13119	4961.82889	PT
3	5095.18084	5016.59357	PT
4	4960.80257	5132.04116	PT
5	4908.10230	5110.48091	PT
6	4907.86231	5035.48130	PT
7	4991.29873	5006.88751	PT
8	5024.61014	4980.48259	PT
9	5072.42543	5036.14329	IRON PIN FOUND
10	4960.89031	5131.96673	IRON PIN FOUND
11	4908.21766	5110.39427	IRON PIN FOUND
12	5024.62341	4980.49795	IF BENT +RESET
13	4999.98088	4999.98999	IRON PIN SET
14	5032.43226	5041.32409	HOUSE
15	5001.35226	5067.05621	HOUSE
16	4812.10428	4686.81791	IMF
17	5015.41864	5021.01300	HOUSE
18	4984.30439	5046.50907	HOUSE
19	4953.92583	5051.89649	GARAGE
20	4935.02289	5029.14807	GARAGE
21	4907.97302	5035.37812	IRON PIN FOUND
22	4991.43601	5006.79880	IRON PIN FOUND

Note: Bearings shown are to an assumed meridian and are used to describe angles only.

Note: Only copies signed with Red Ink shall be considered Valid.

*Patrick A. McGannon*  
Patrick A. McGannon P.S. 7154

Prepared for the City of Lorain  
Community Development  
Department, 200 West Erie  
Avenue, Lorain, Ohio 44052.

Being known as part of Original Lot  
of Tract One of Black River Township  
now in the City of Lorain, County of  
Lorain, in the State of Ohio.

# Boundary Survey

**Patrick A. McGannon**  
Registered Professional Surveyor



1731 Gettysburg Drive, Lorain, Ohio 44053

(440)-2822712