


1-00-032-A

#17823

01-00-032-000-054
SCAN # 46522

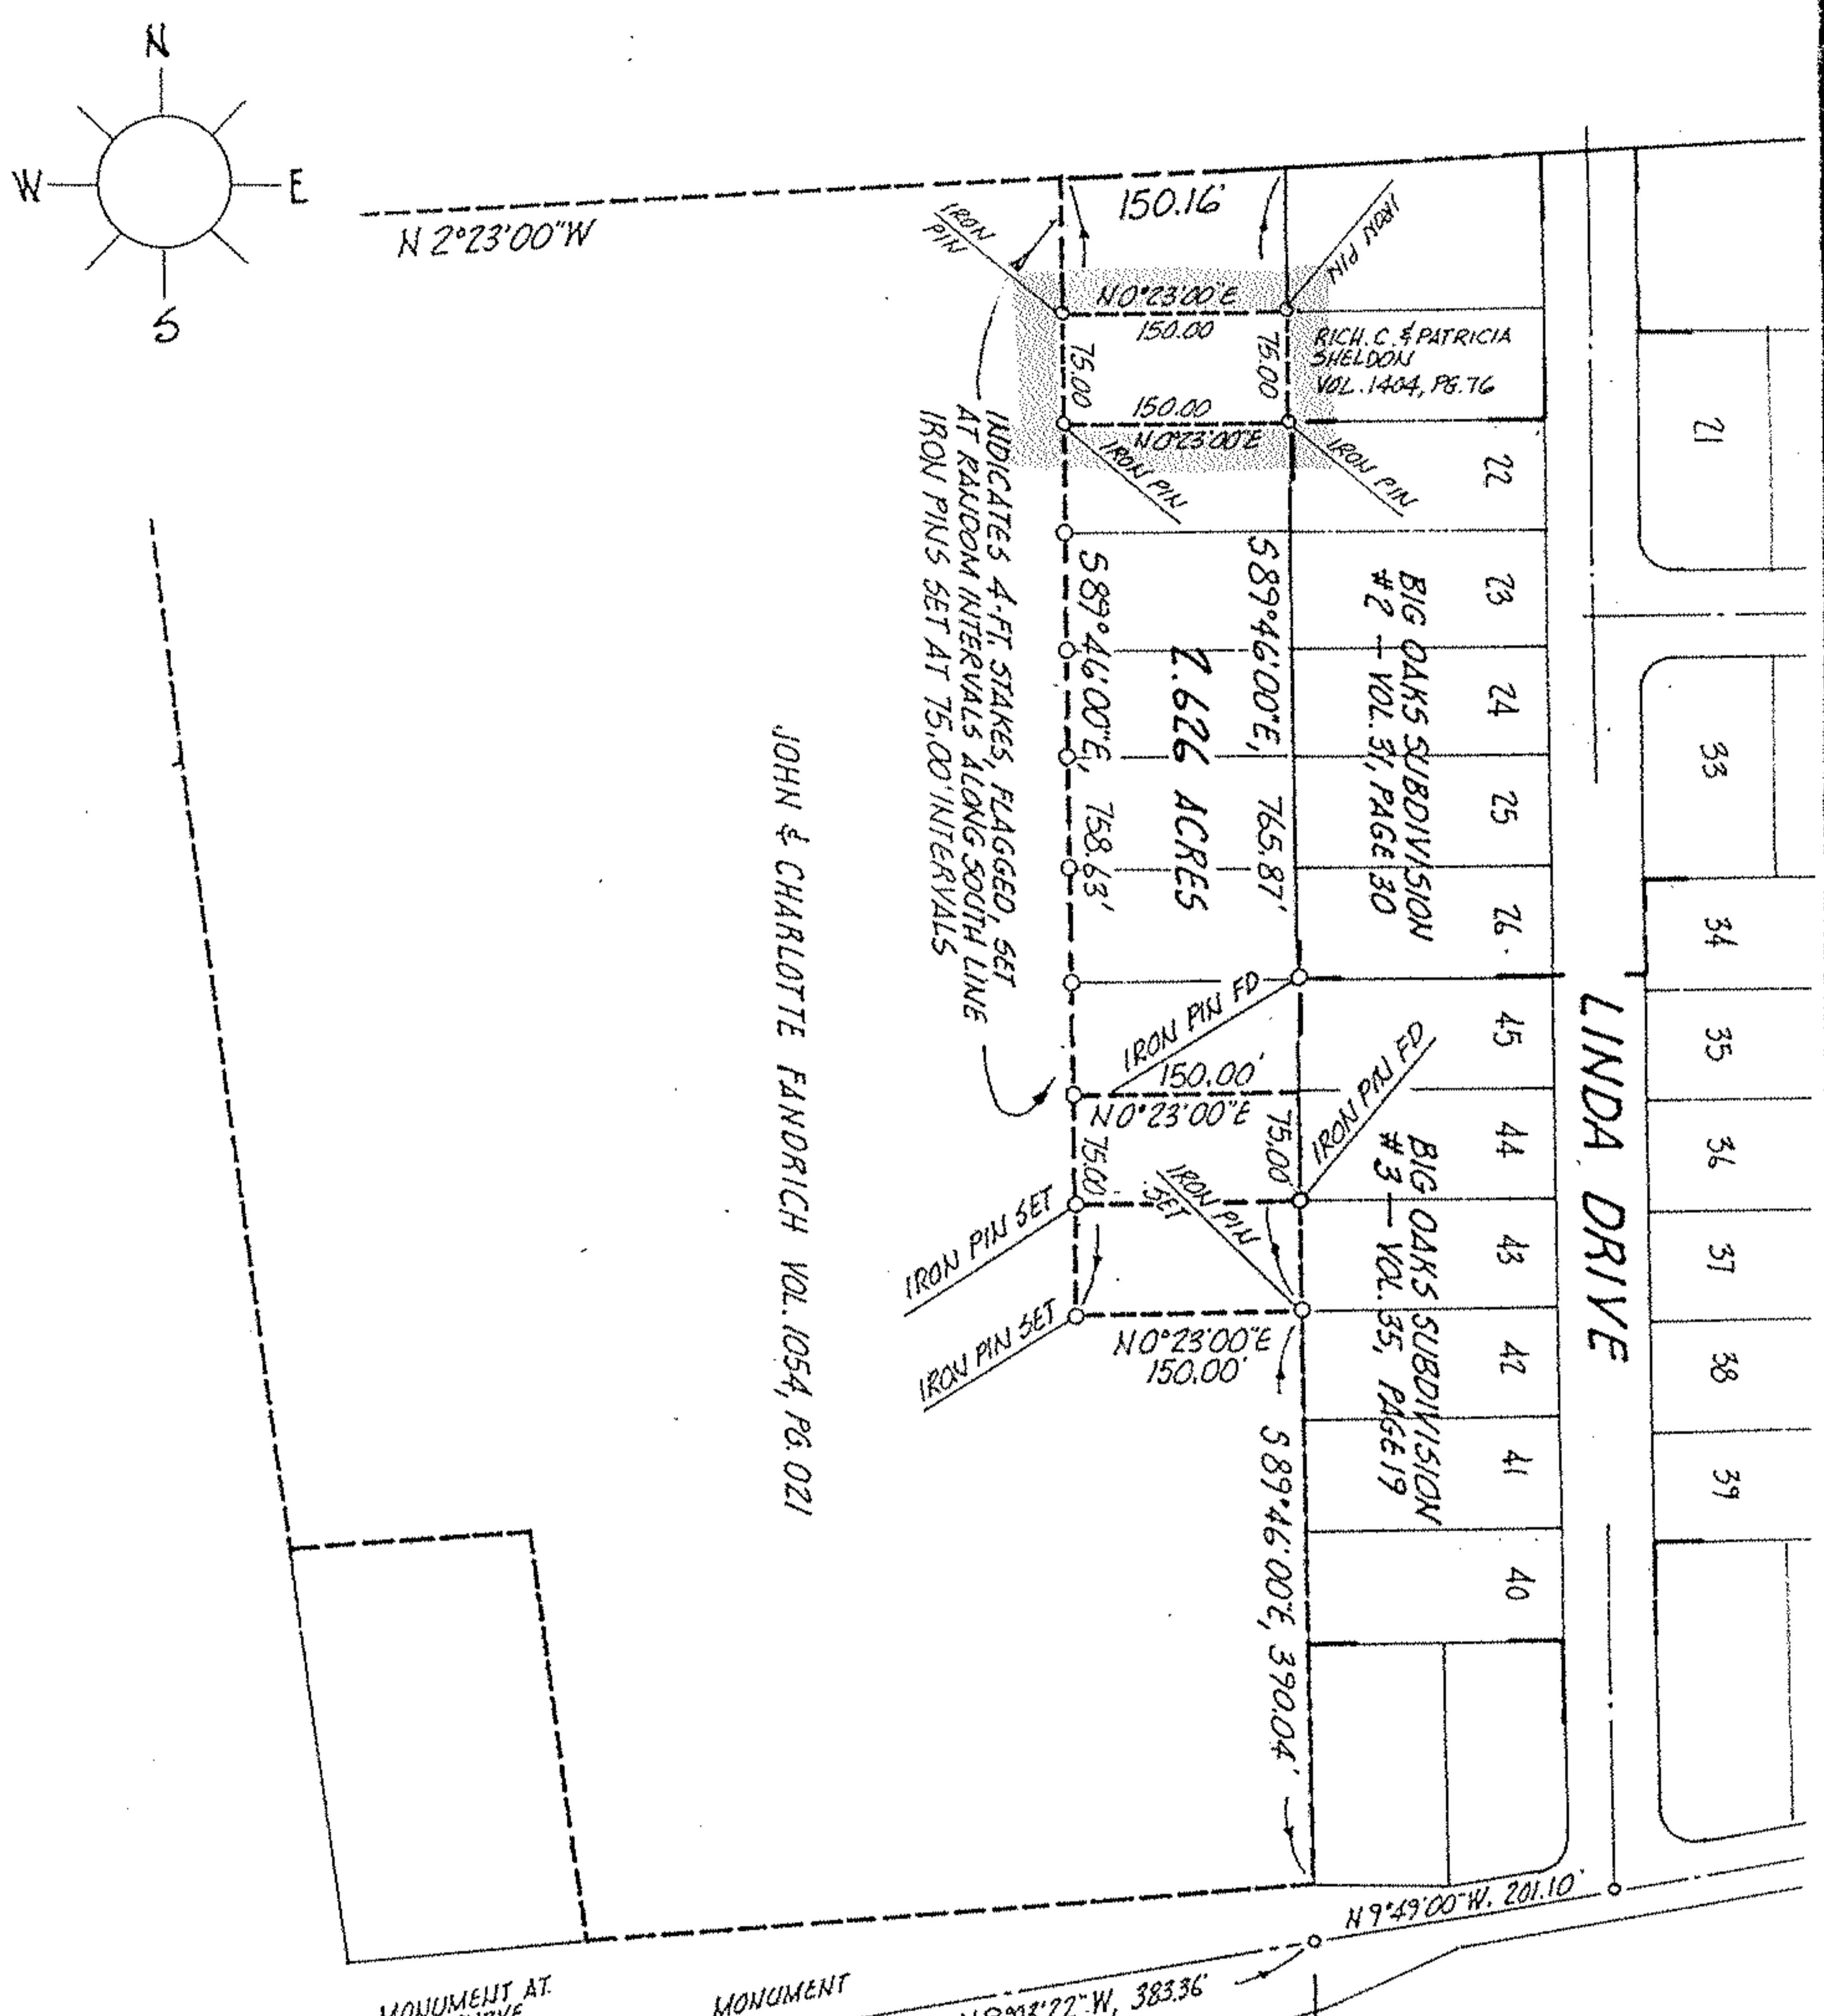

BY *Carol Feancis*
 VOID AFTER 17823
 DATE 1-15-88
 PAGE 1-00-032-A
 APPROVED
 LORAIN CO.
 MAP DEPT.
 #17823

MONUMENT AT P.I. OF CURVE
 MONUMENT
 N 9°03'22\"W, 383.36'
 WEST RIVER ROAD
 O.L. 17
 O.L. 32

ACREAGE 0.258	PREPARED FOR MIDLAND TITLE SECURITY
DATE JAN-88	
DRAWN MGH	MICHAEL G. HURA registered surveyor 12706 MASON ROAD, VERMILION, OHIO [216] 965-4040
SCALE 1" = NONE ft.	PERIMETER SURVEY
	SUBLOT _____ OF _____ Volume _____ Page _____ of PLATS
	PART OF O.L. 32 TRACT _____ SECTION _____ OF
	BROWNHELM TOWNSHIP LORAIN CO., OHIO
Perm. Parcel N° _____	Ref. deed: 1404/076

CITY OF