


1-00-031-B

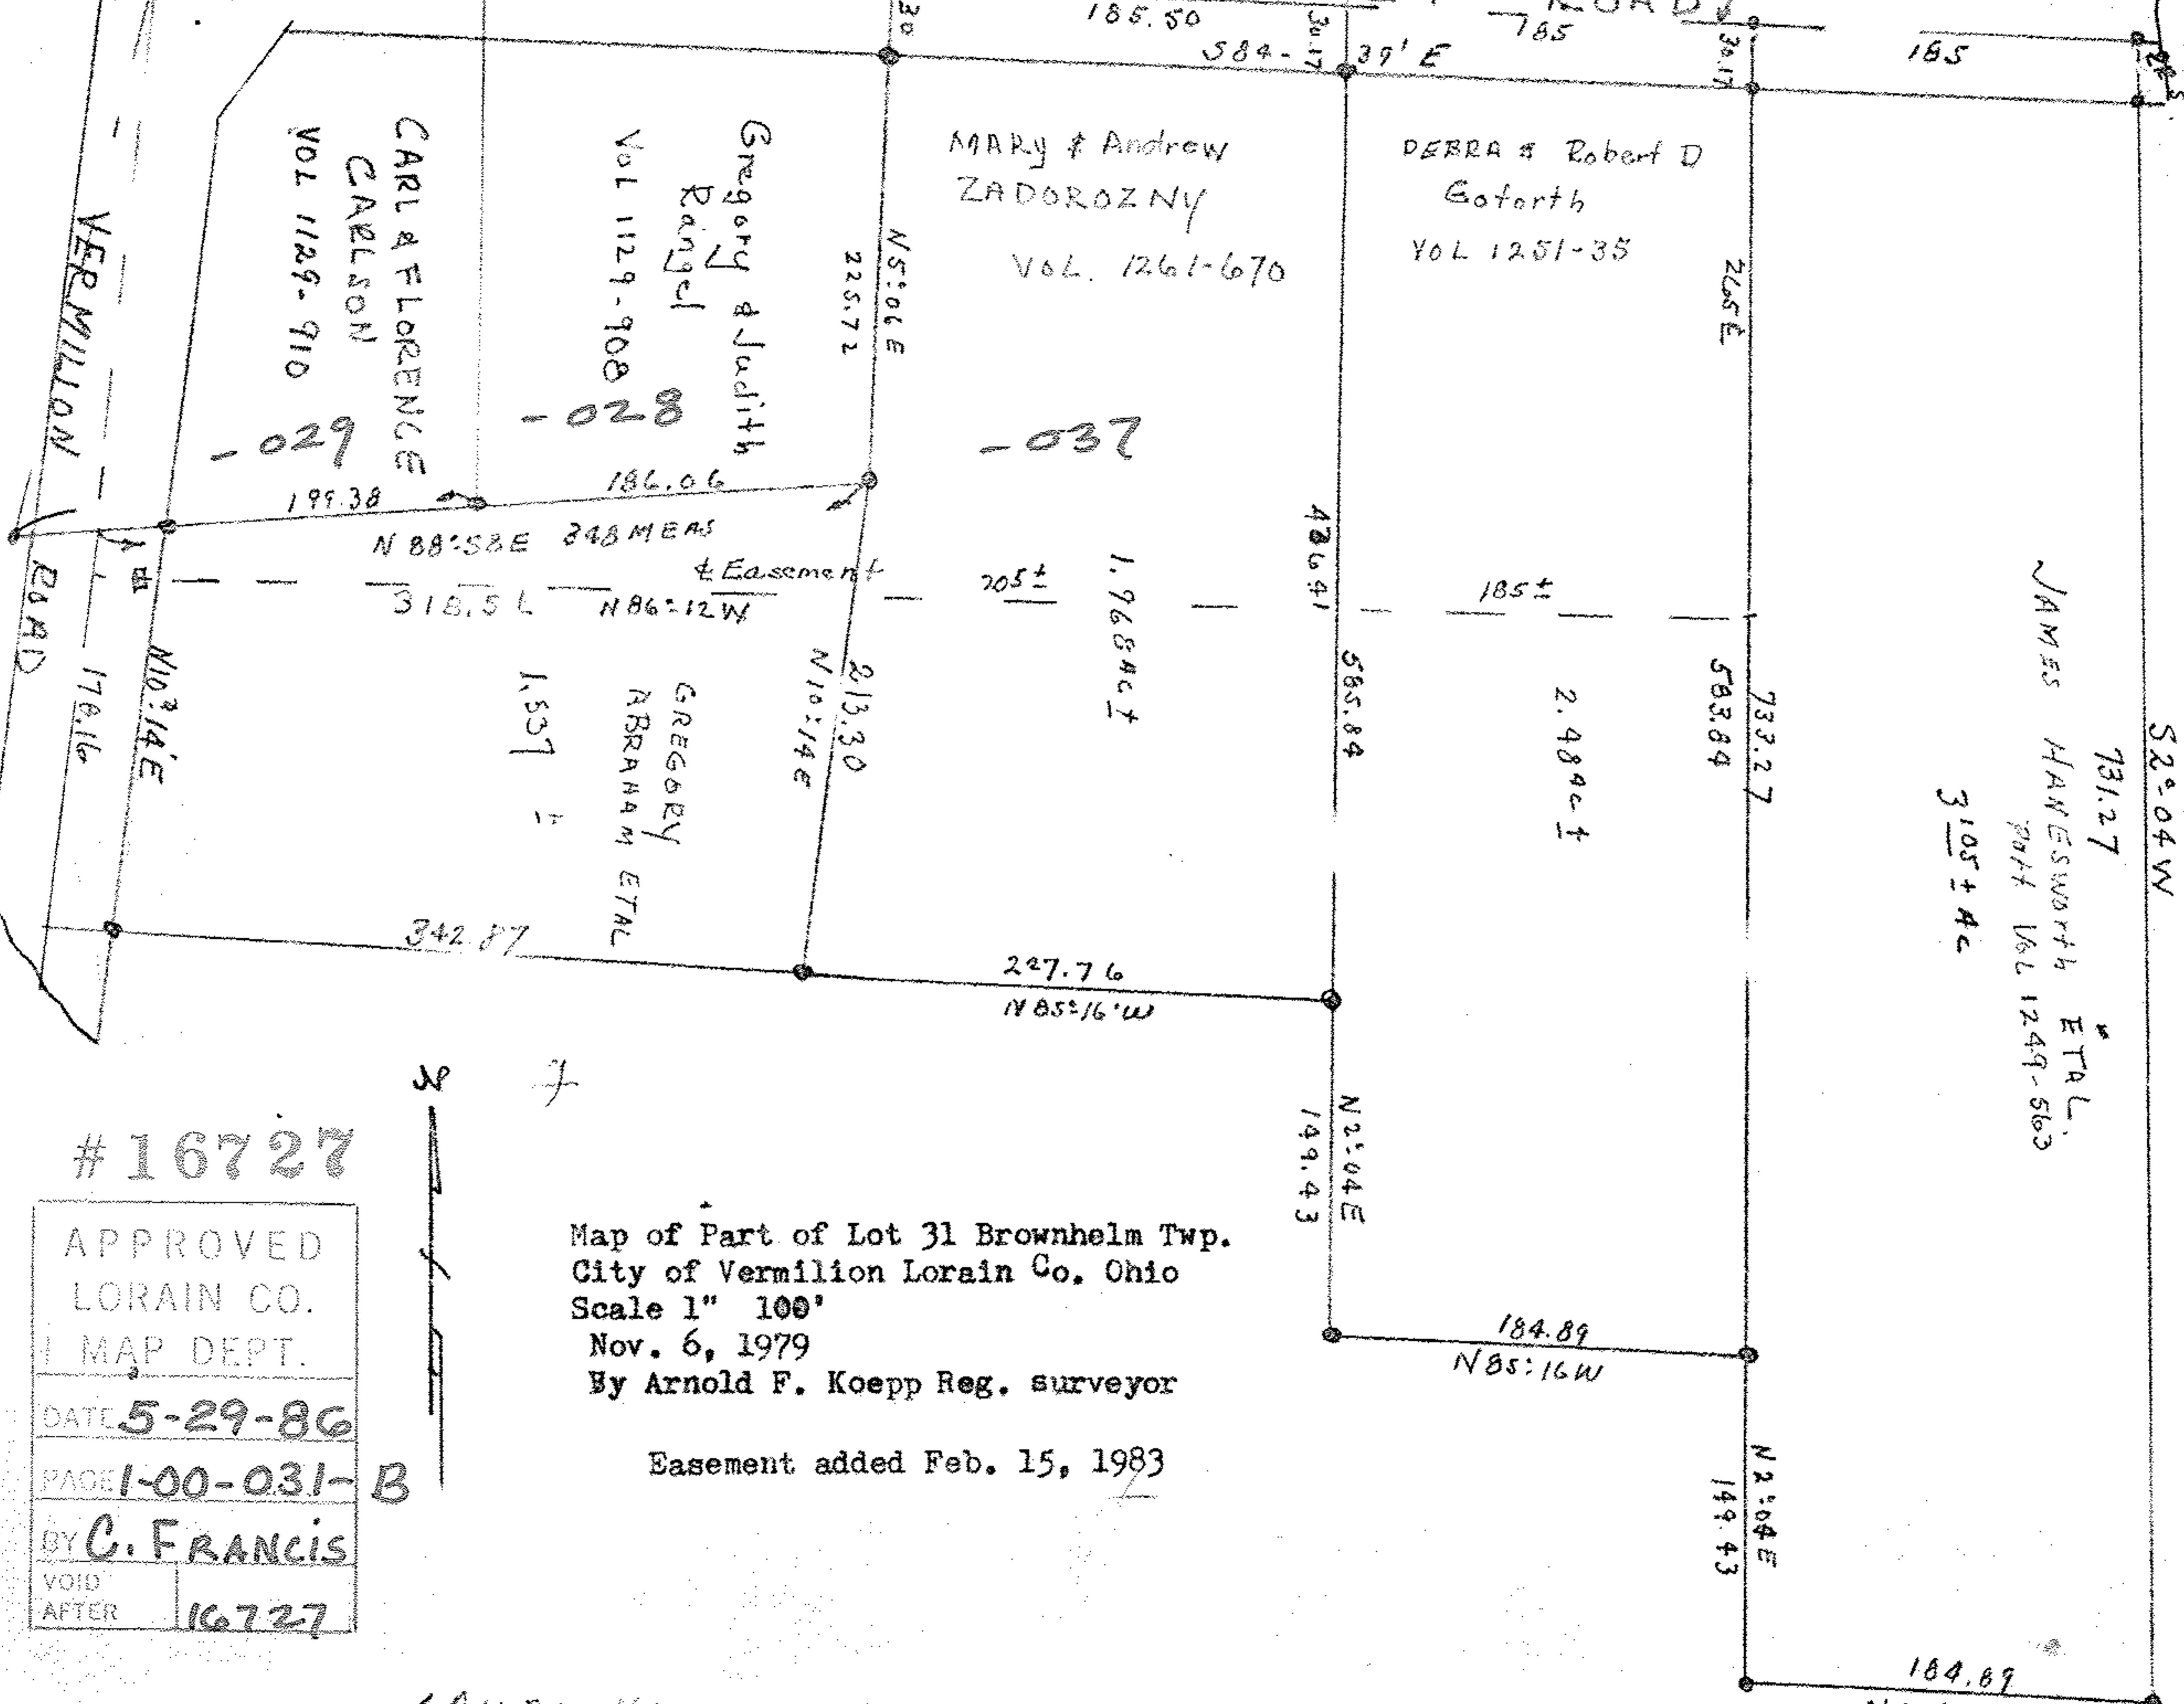

JAMES HANESWORTH ET AL.
Patt Vol 1249-563

3105±4c

184.89
N 85° 16 W

184.89
N 85° 16 W

184.89 N 85° 16 W 1249-563