



Scan # 46536

05-00-047-002

#16815

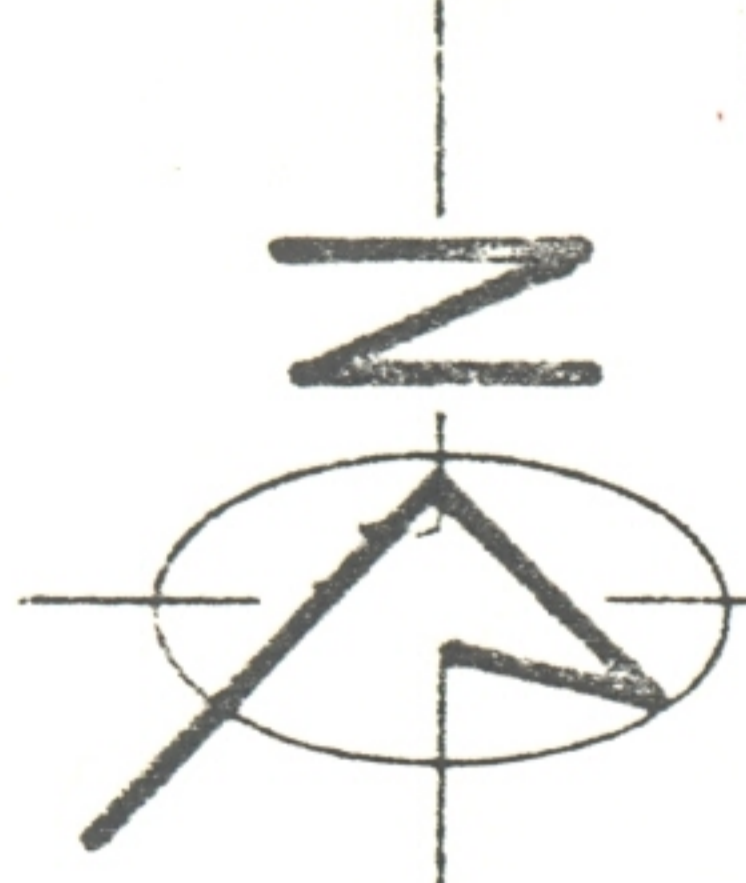


ERROR ON SURVEY

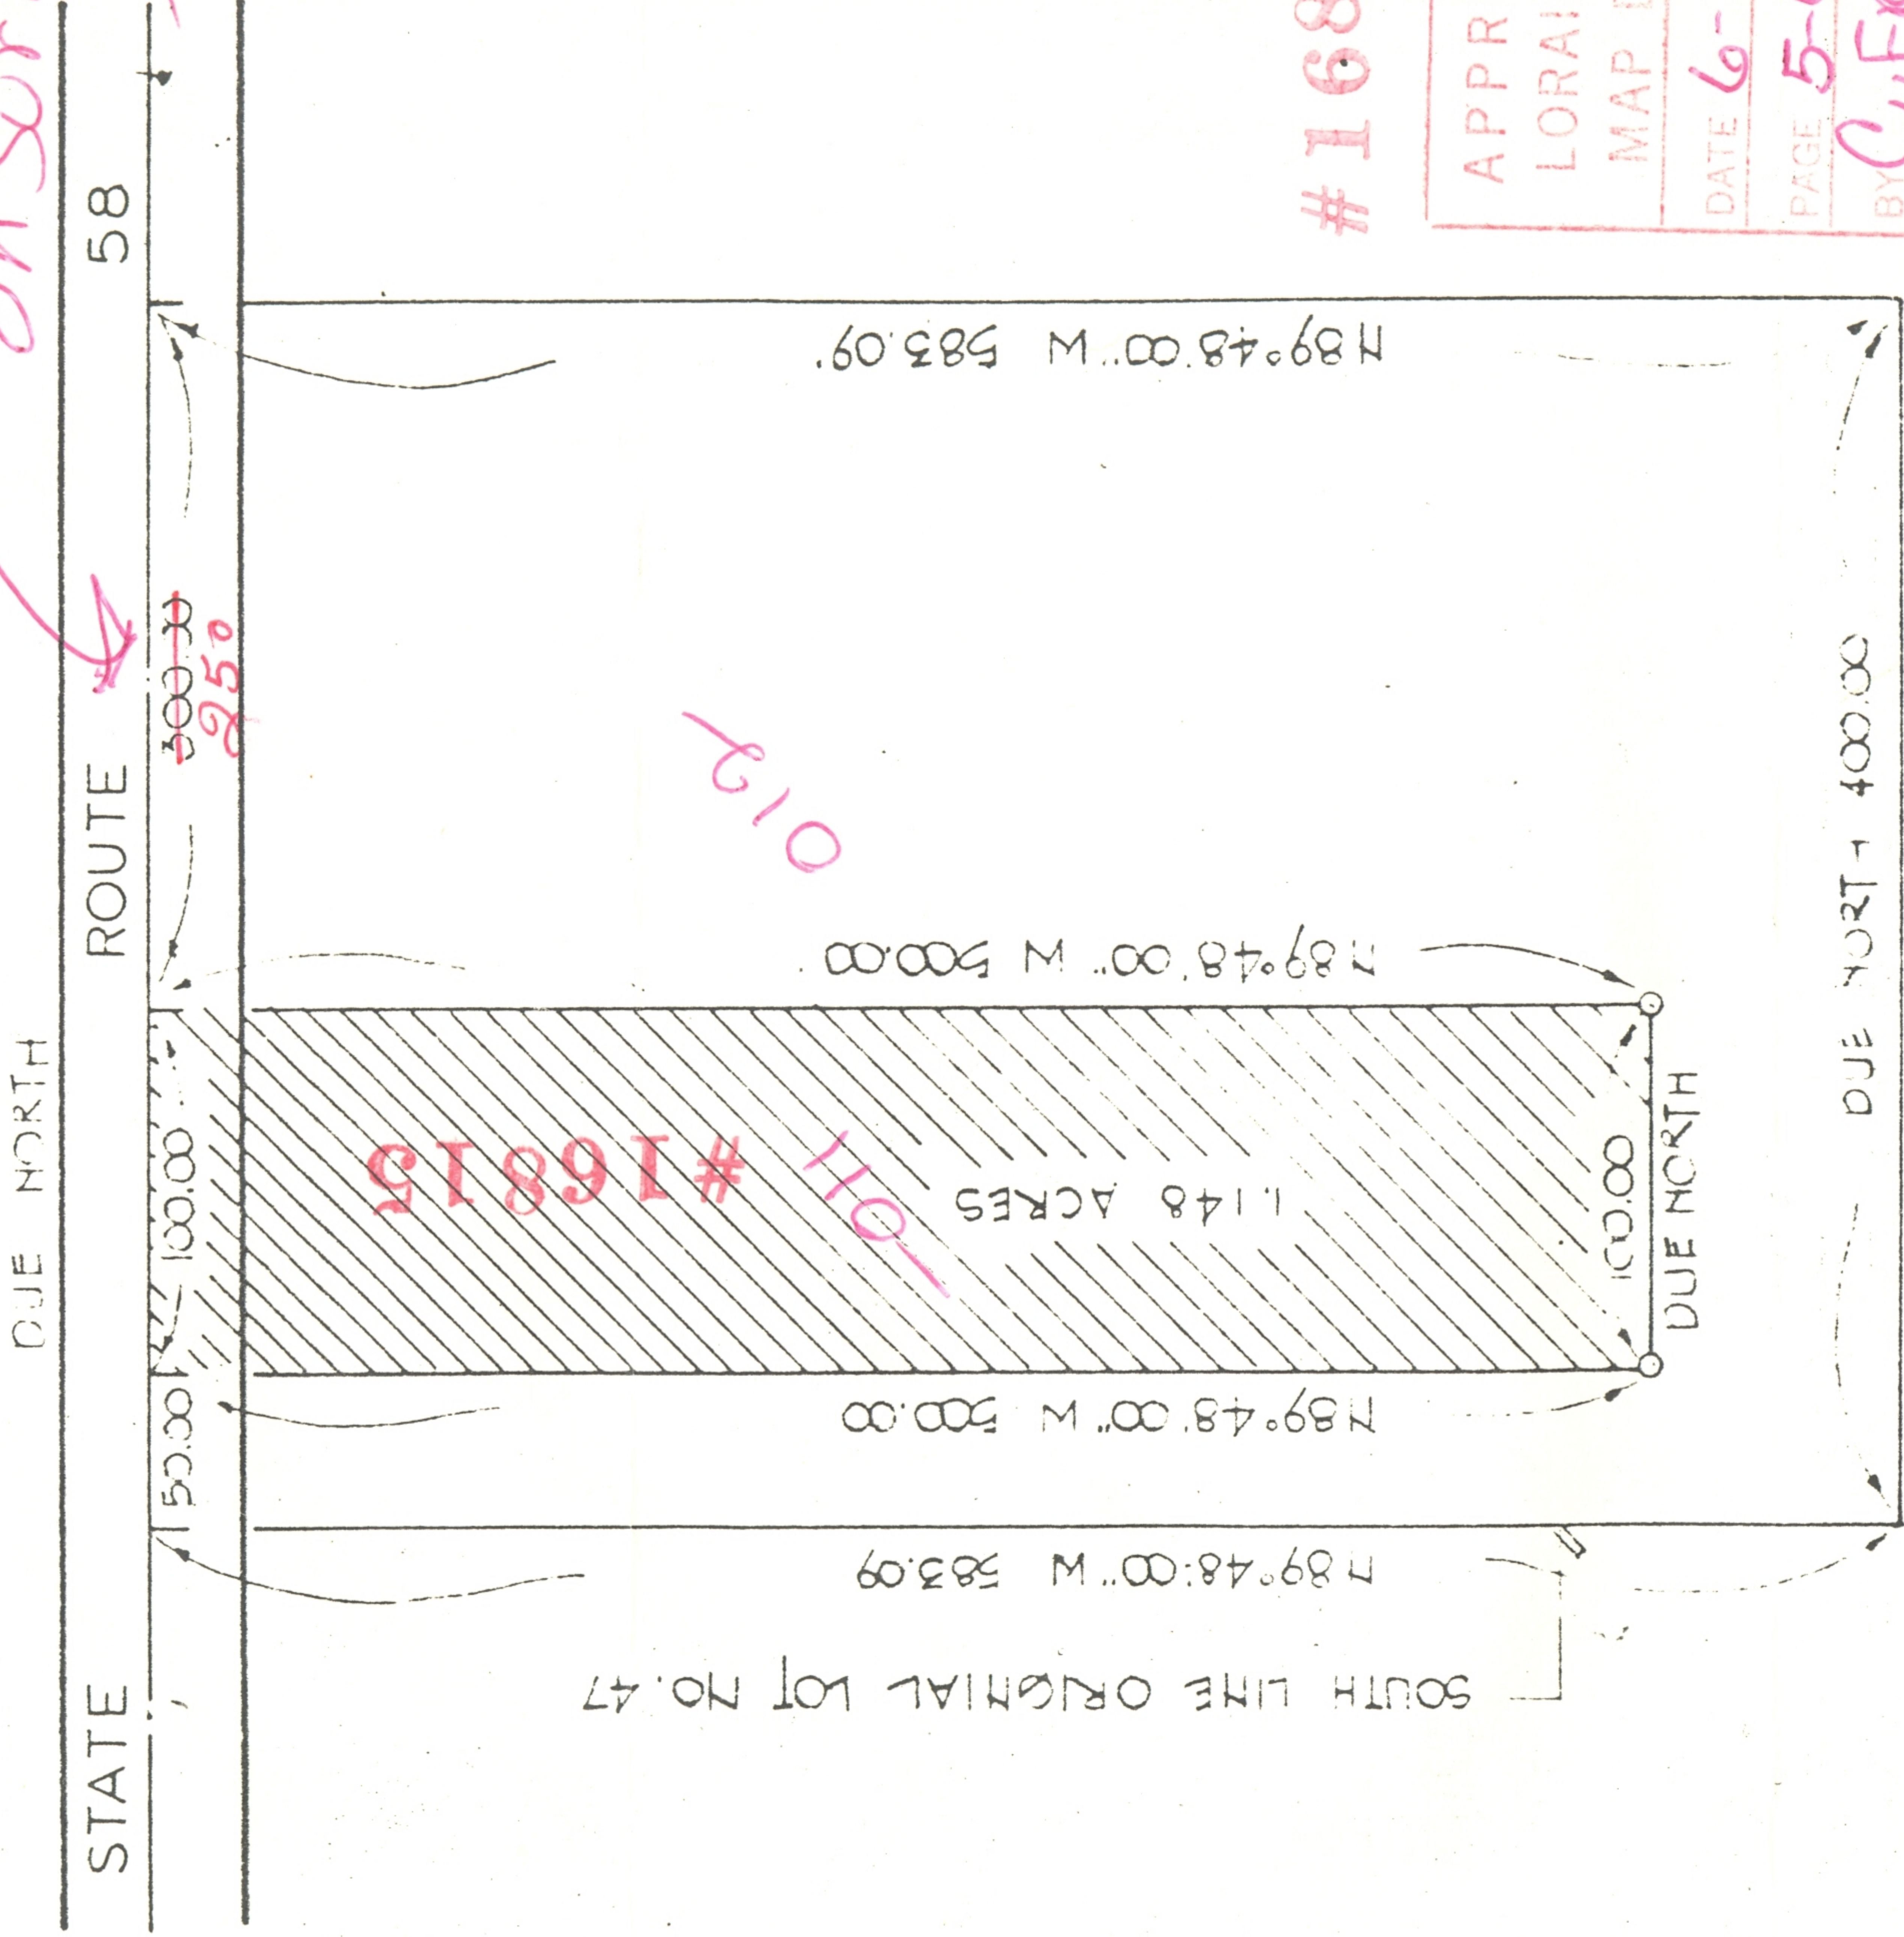

#16815

APPROVED
LORAIN CO.
MAP DEPT.

DATE 6-27-86
PAGE 5-G
BY C. Francis
VOID AFTER 16815

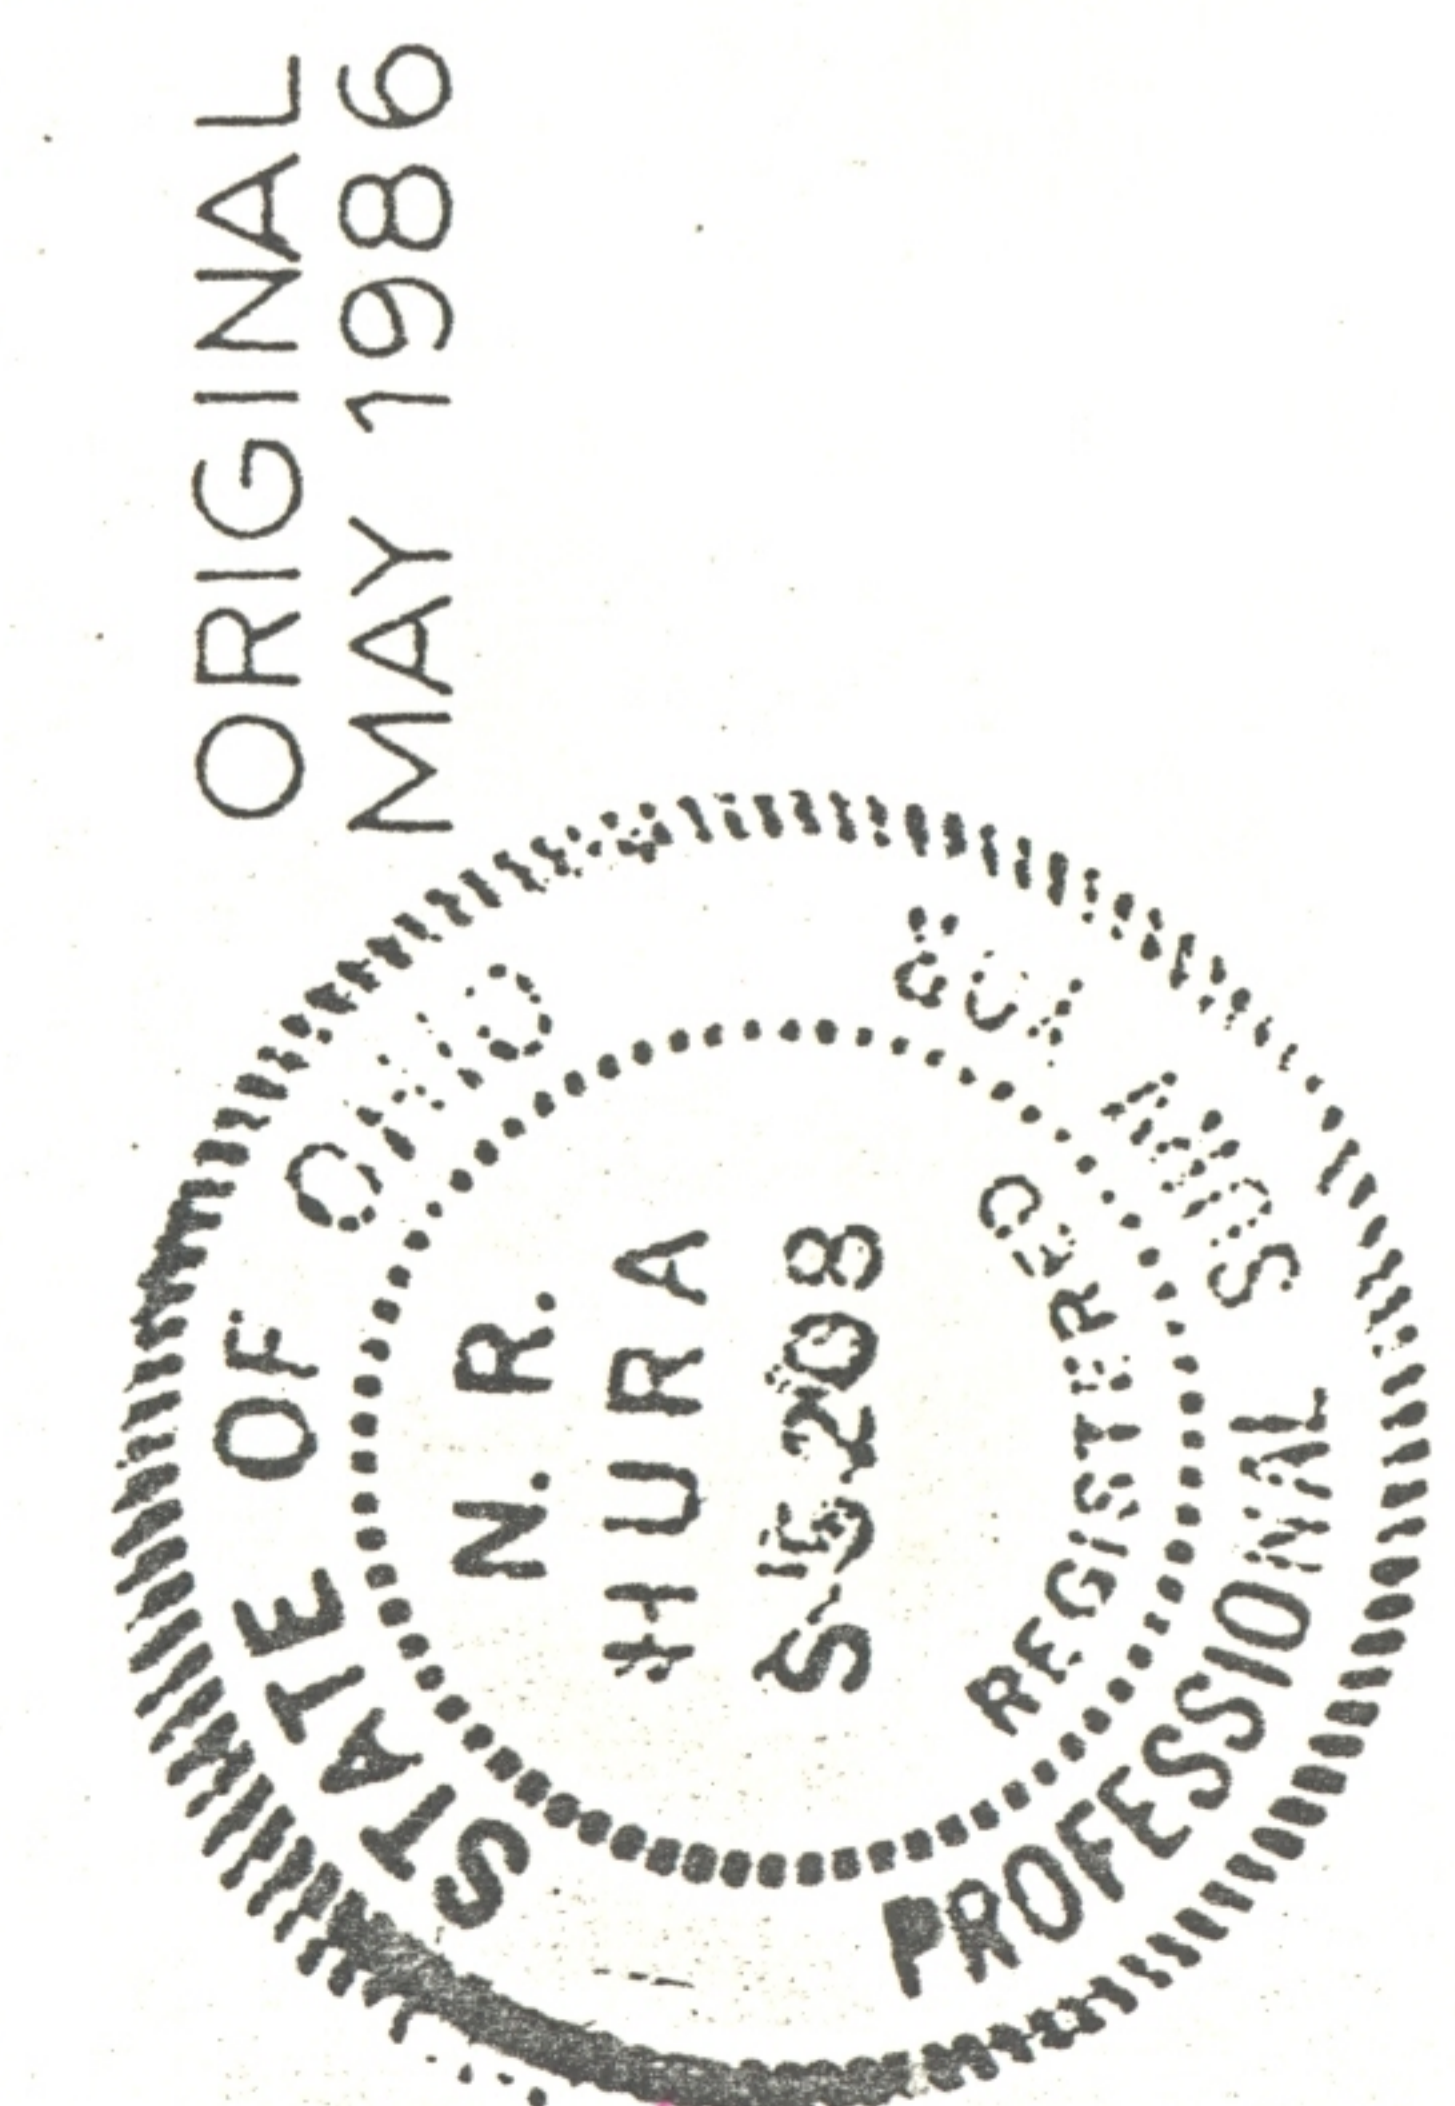

LOT SPLIT
ORIGINAL LOT NO. 47 AMHERST TOWNSHIP
MAY 1986
SCALE 1"=100'

norman r hura registered surveyor

5-G
0.71 47