


9-00-045-000-003

9-B

SCAN # 46538

MARLEY, J. FRANKLIN D.V. 122-408
12-20-20

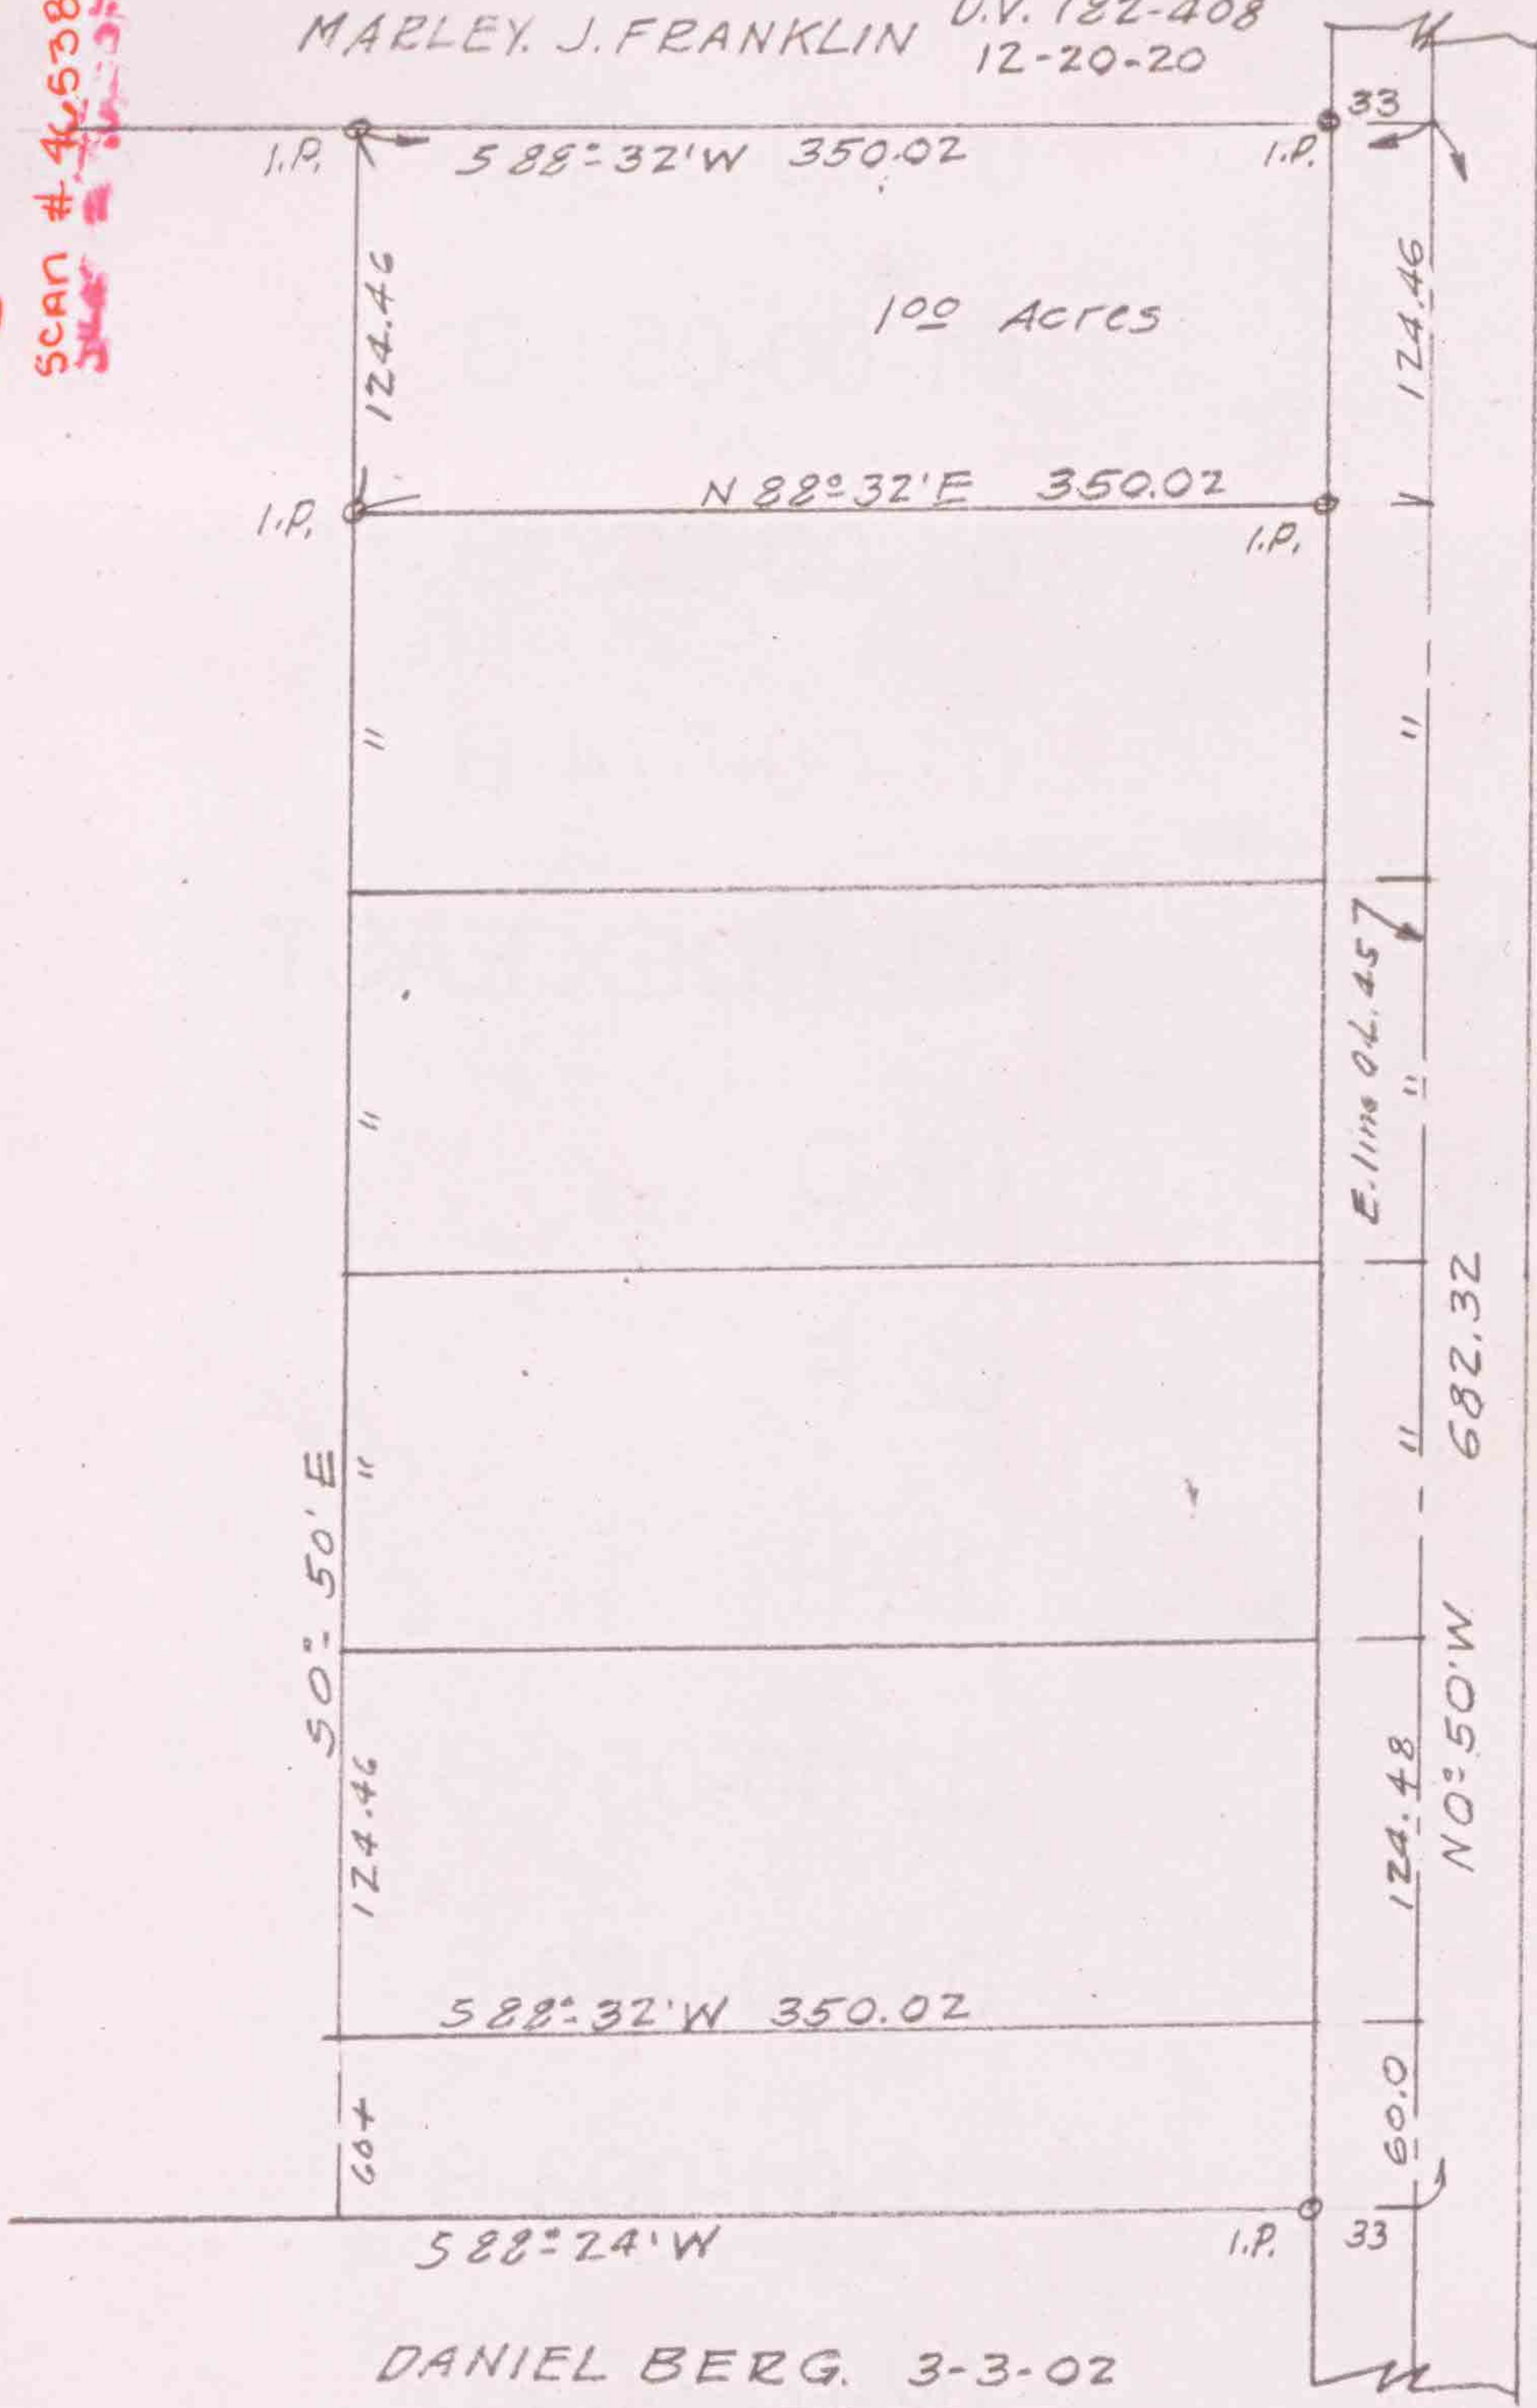

DANIEL BERG, 3-3-02
D.V. 88-62

SURVEY OF EARL V. LEIMBACH LANDS
PART OF O.L. 45 RUSSIA TP. LORAIN CO. OHIO
SCALE 1"=100'
MAY. 24. 1951
T.W. LAUNDON REGISTERED SURVEYOR