


9-00-046-000-007

9-00-046-000-008

9-C

Sum of 8558

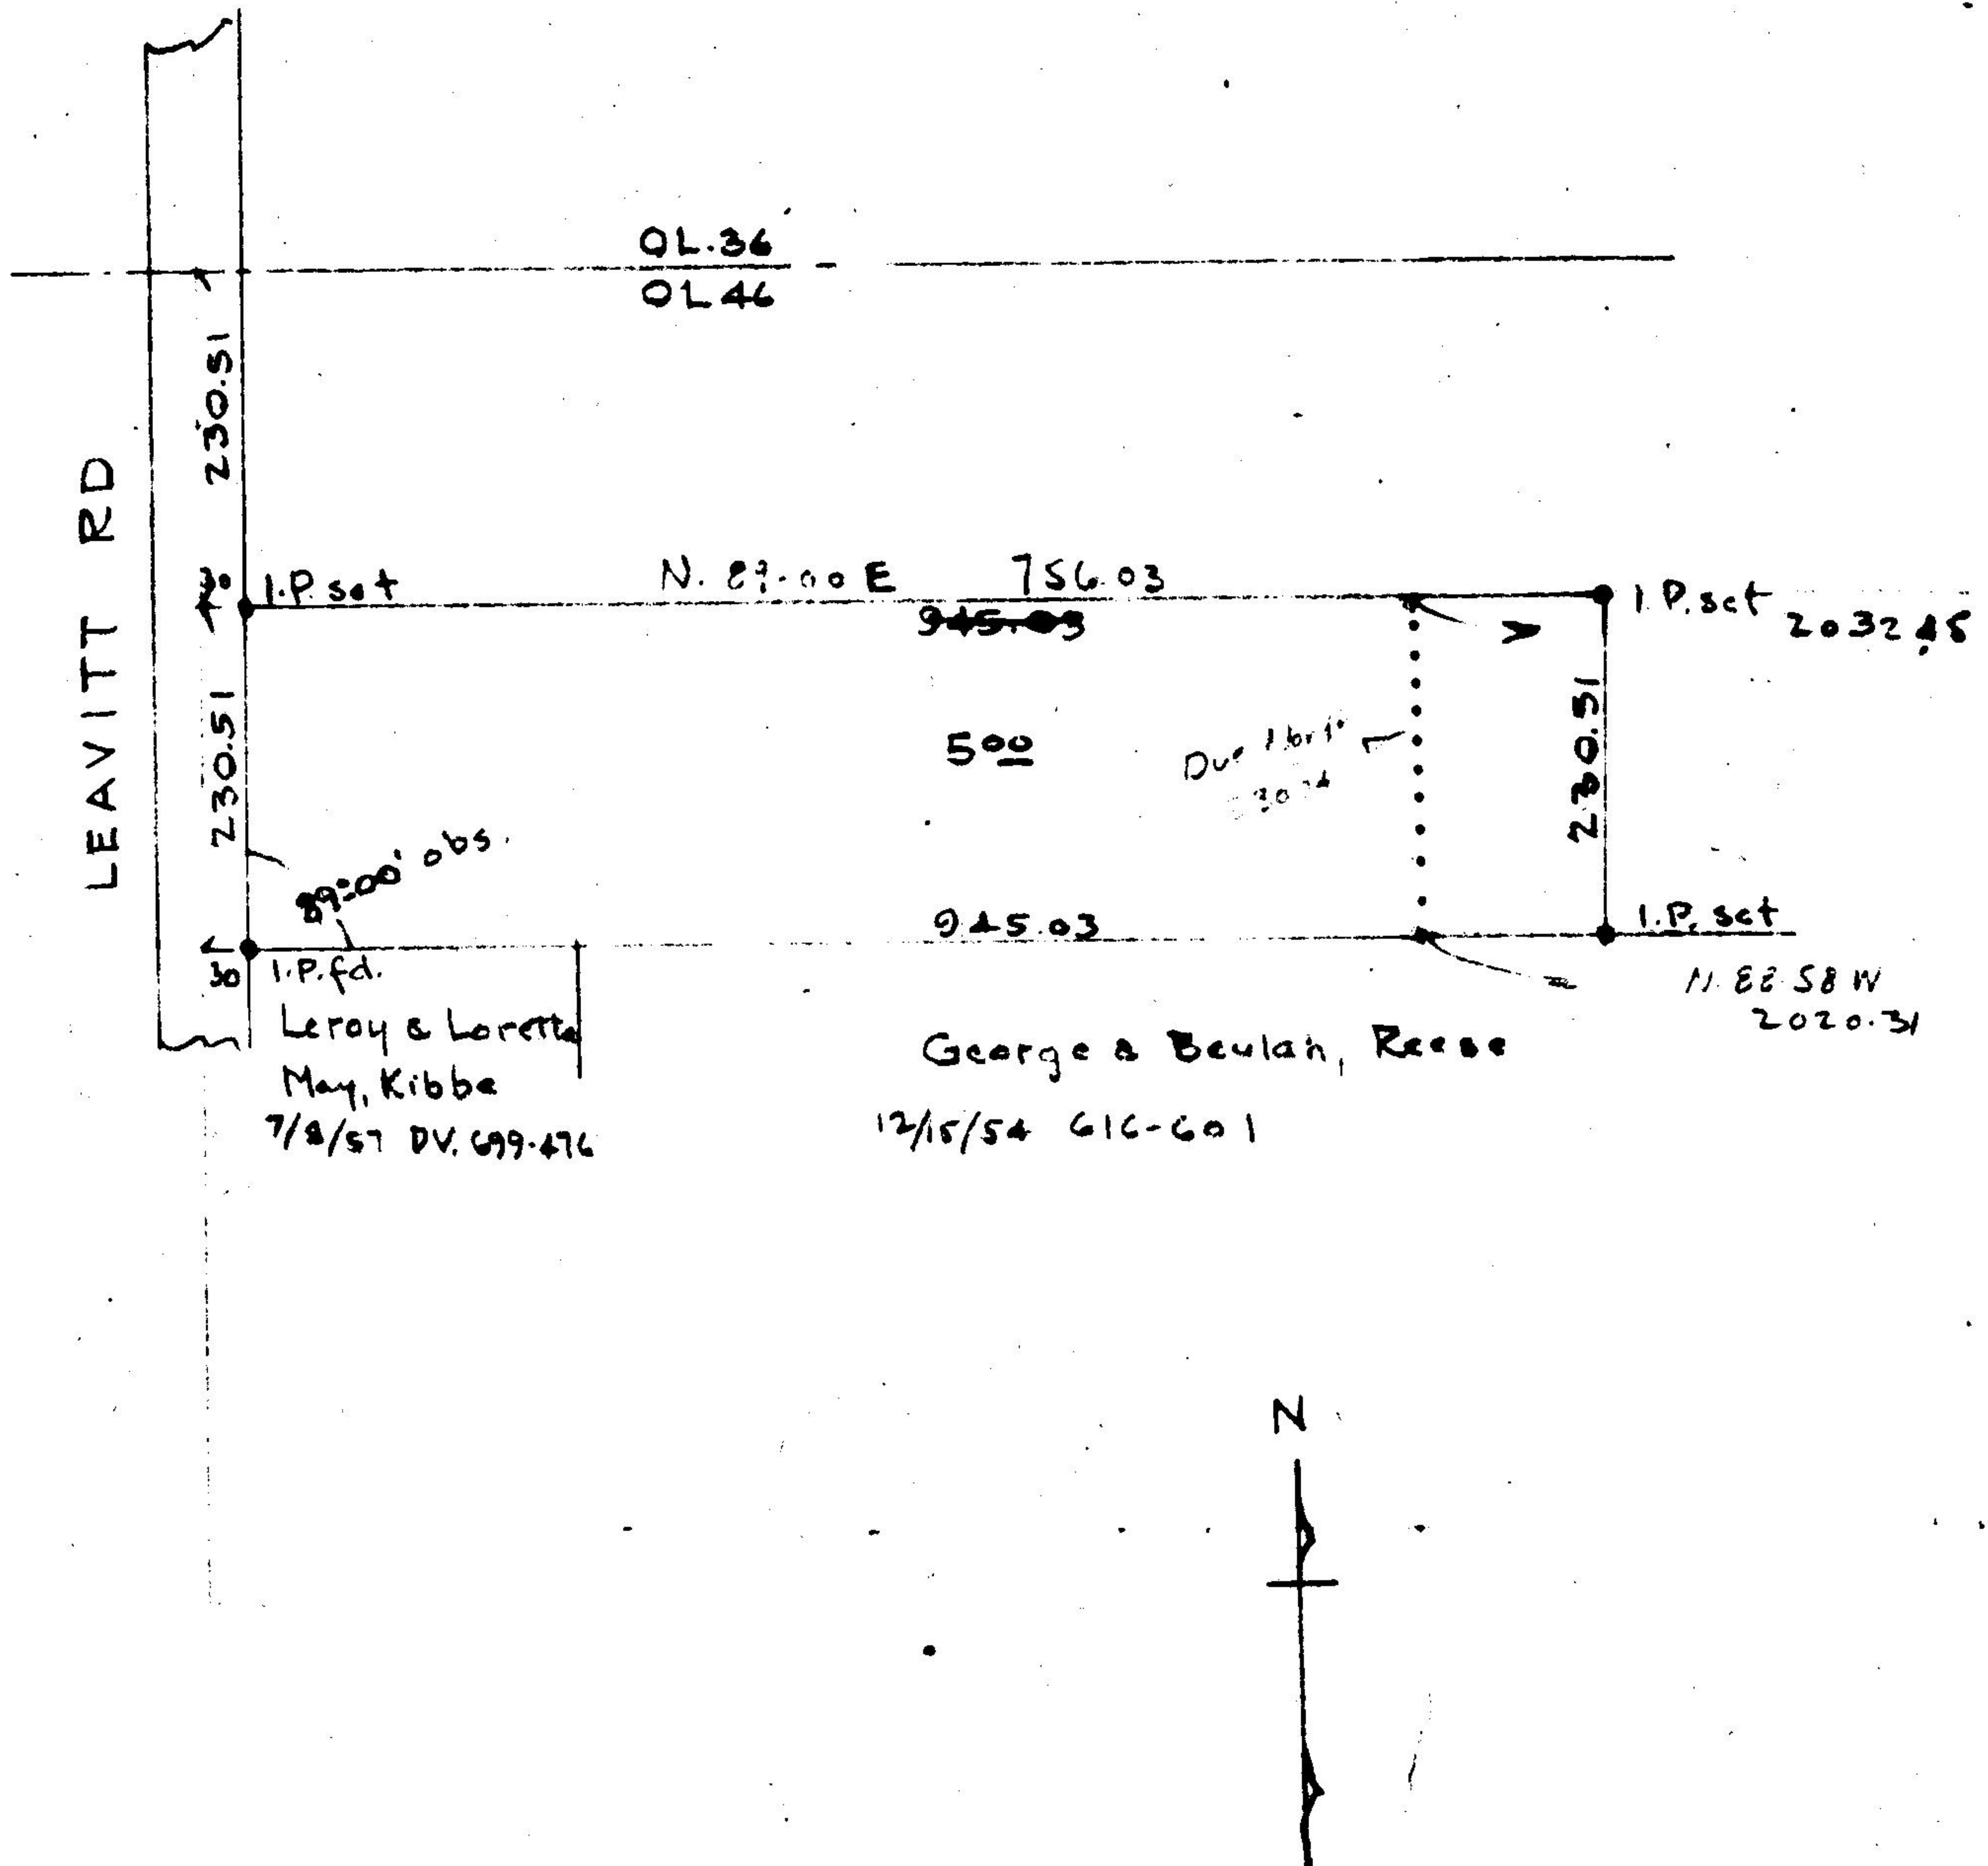

SURVEY FOR DONALD. R. & B.A. HENTGES  
 O.L. 46 RUSSIA TP. LORAIN CO. OHIO  
 SCALE 1" = 200' SEPT-11-1958  
 LAUNDON & HUFFMAN-REG. SURVEYORS.  
 P.O. 98-6