
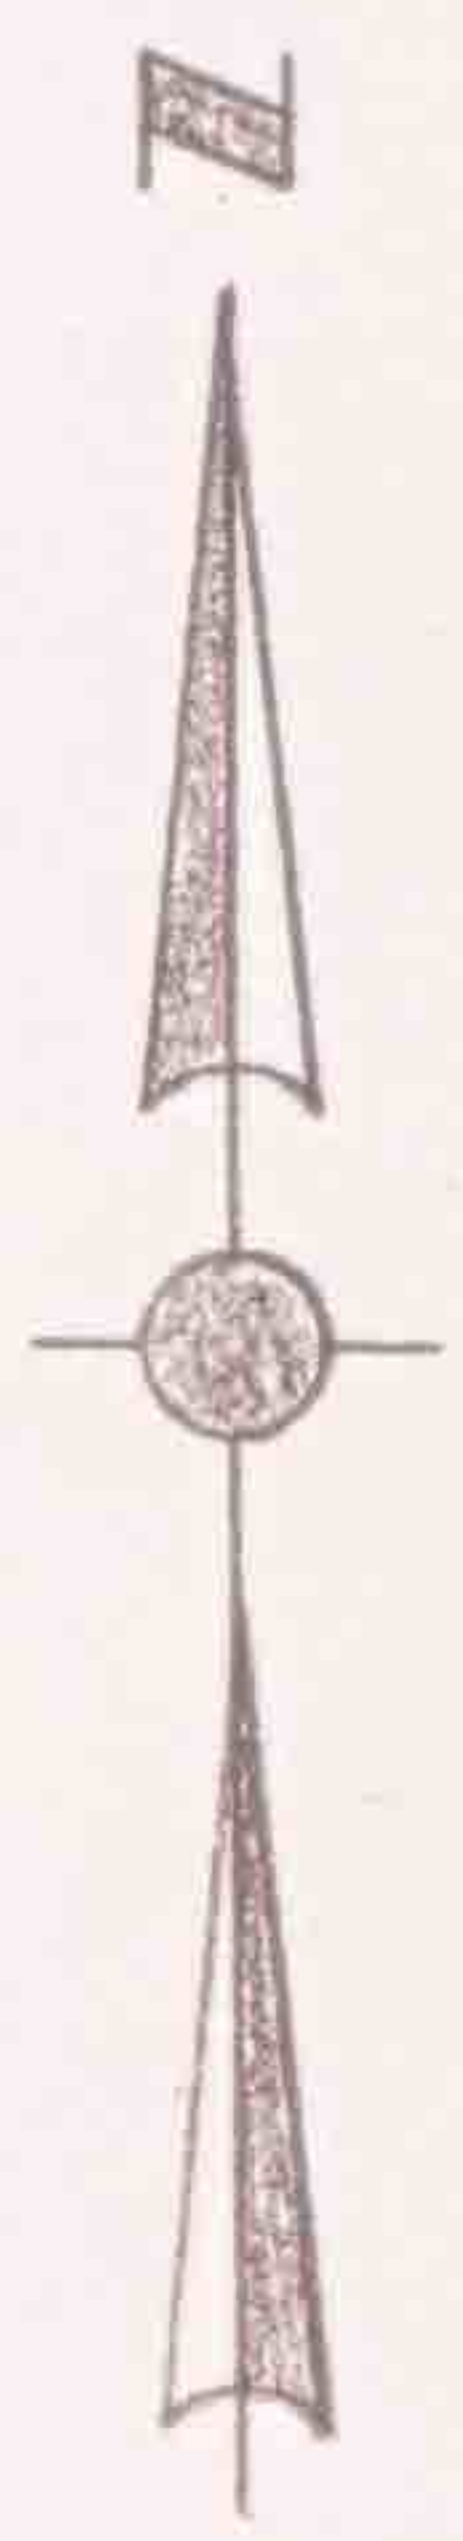


9-00-075-101-089

259900-075-A

SCM # 46548

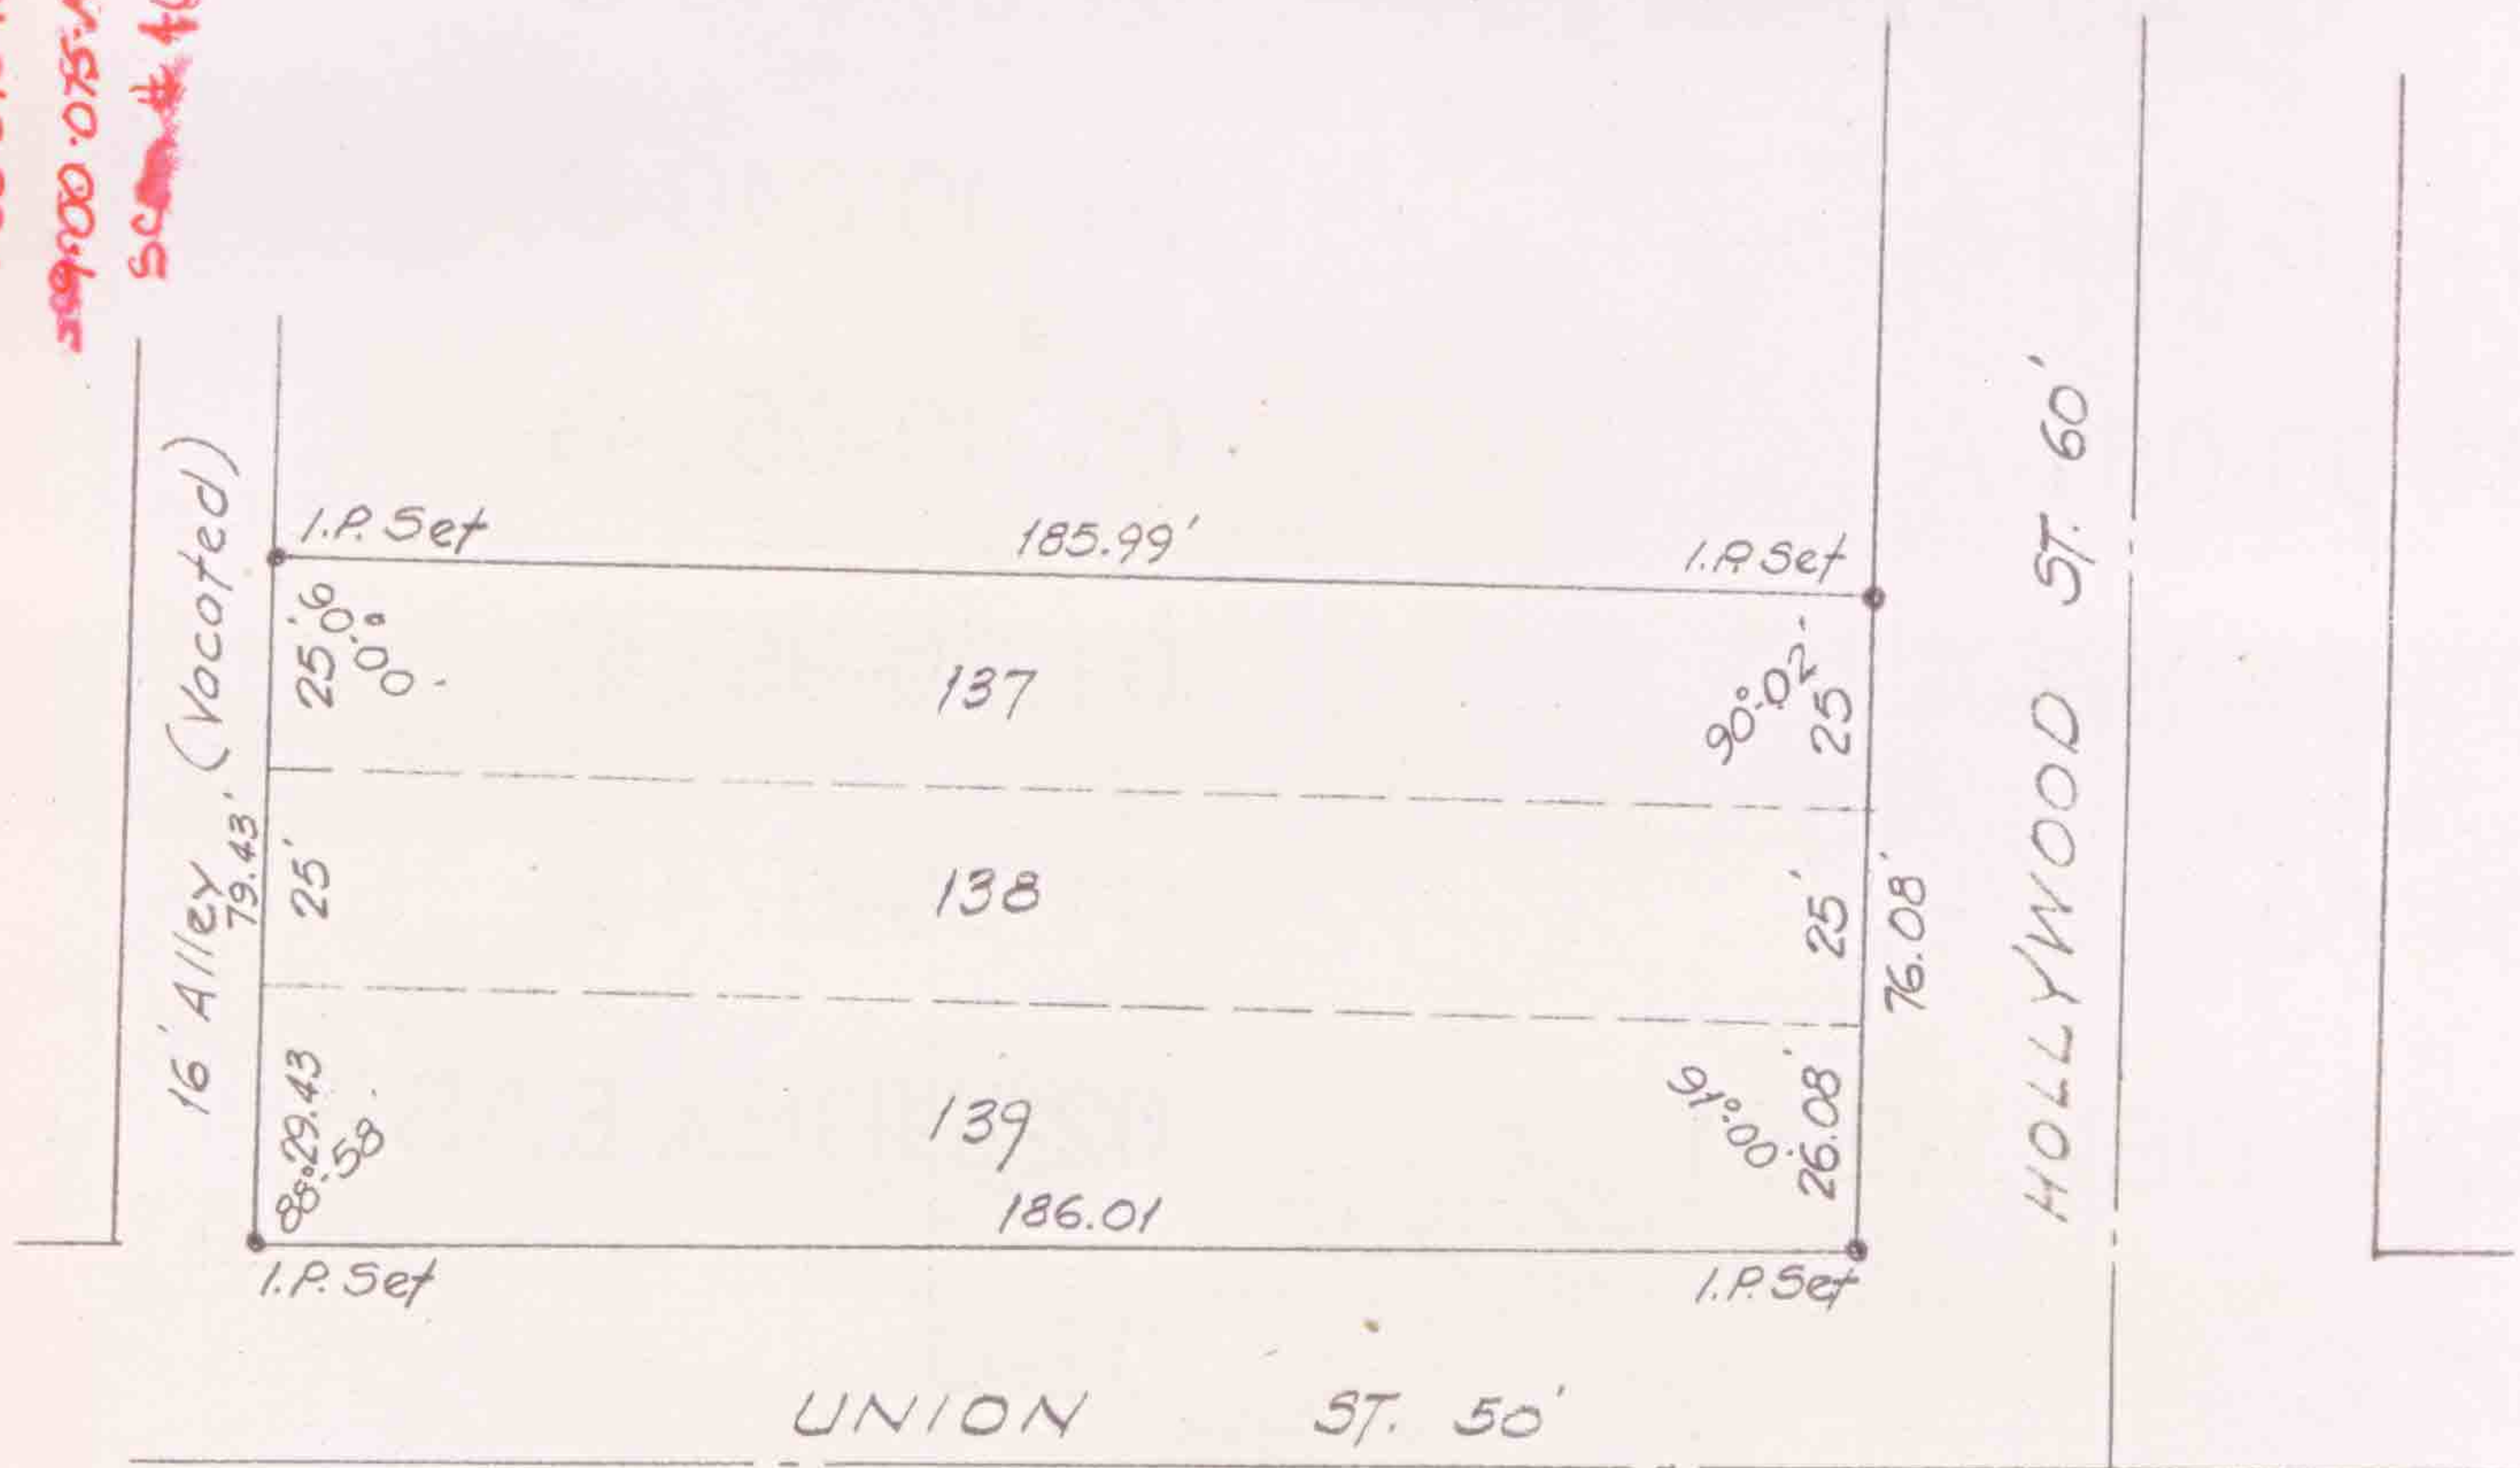

SURVEY FOR CLARK BROTHERS INC.
 S/L 137, 138 & 139 HOLLYWOOD ADDITION
 P.V. 7 PG. 55
 CITY OF OBERLIN • LORAIN COUNTY • OHIO
 AUGUST 1975 SCALE 1"=40'
 LAUNDON • SIMON • CAHL & ASSOC.
 ENGINEERS SURVEYORS
 Job 75-424 FB. 180/9