


9-00-075-110-007
9-00-075-B
SCAN # 46551

NORTH PROFESSOR ST. 60

UNION STREET 50

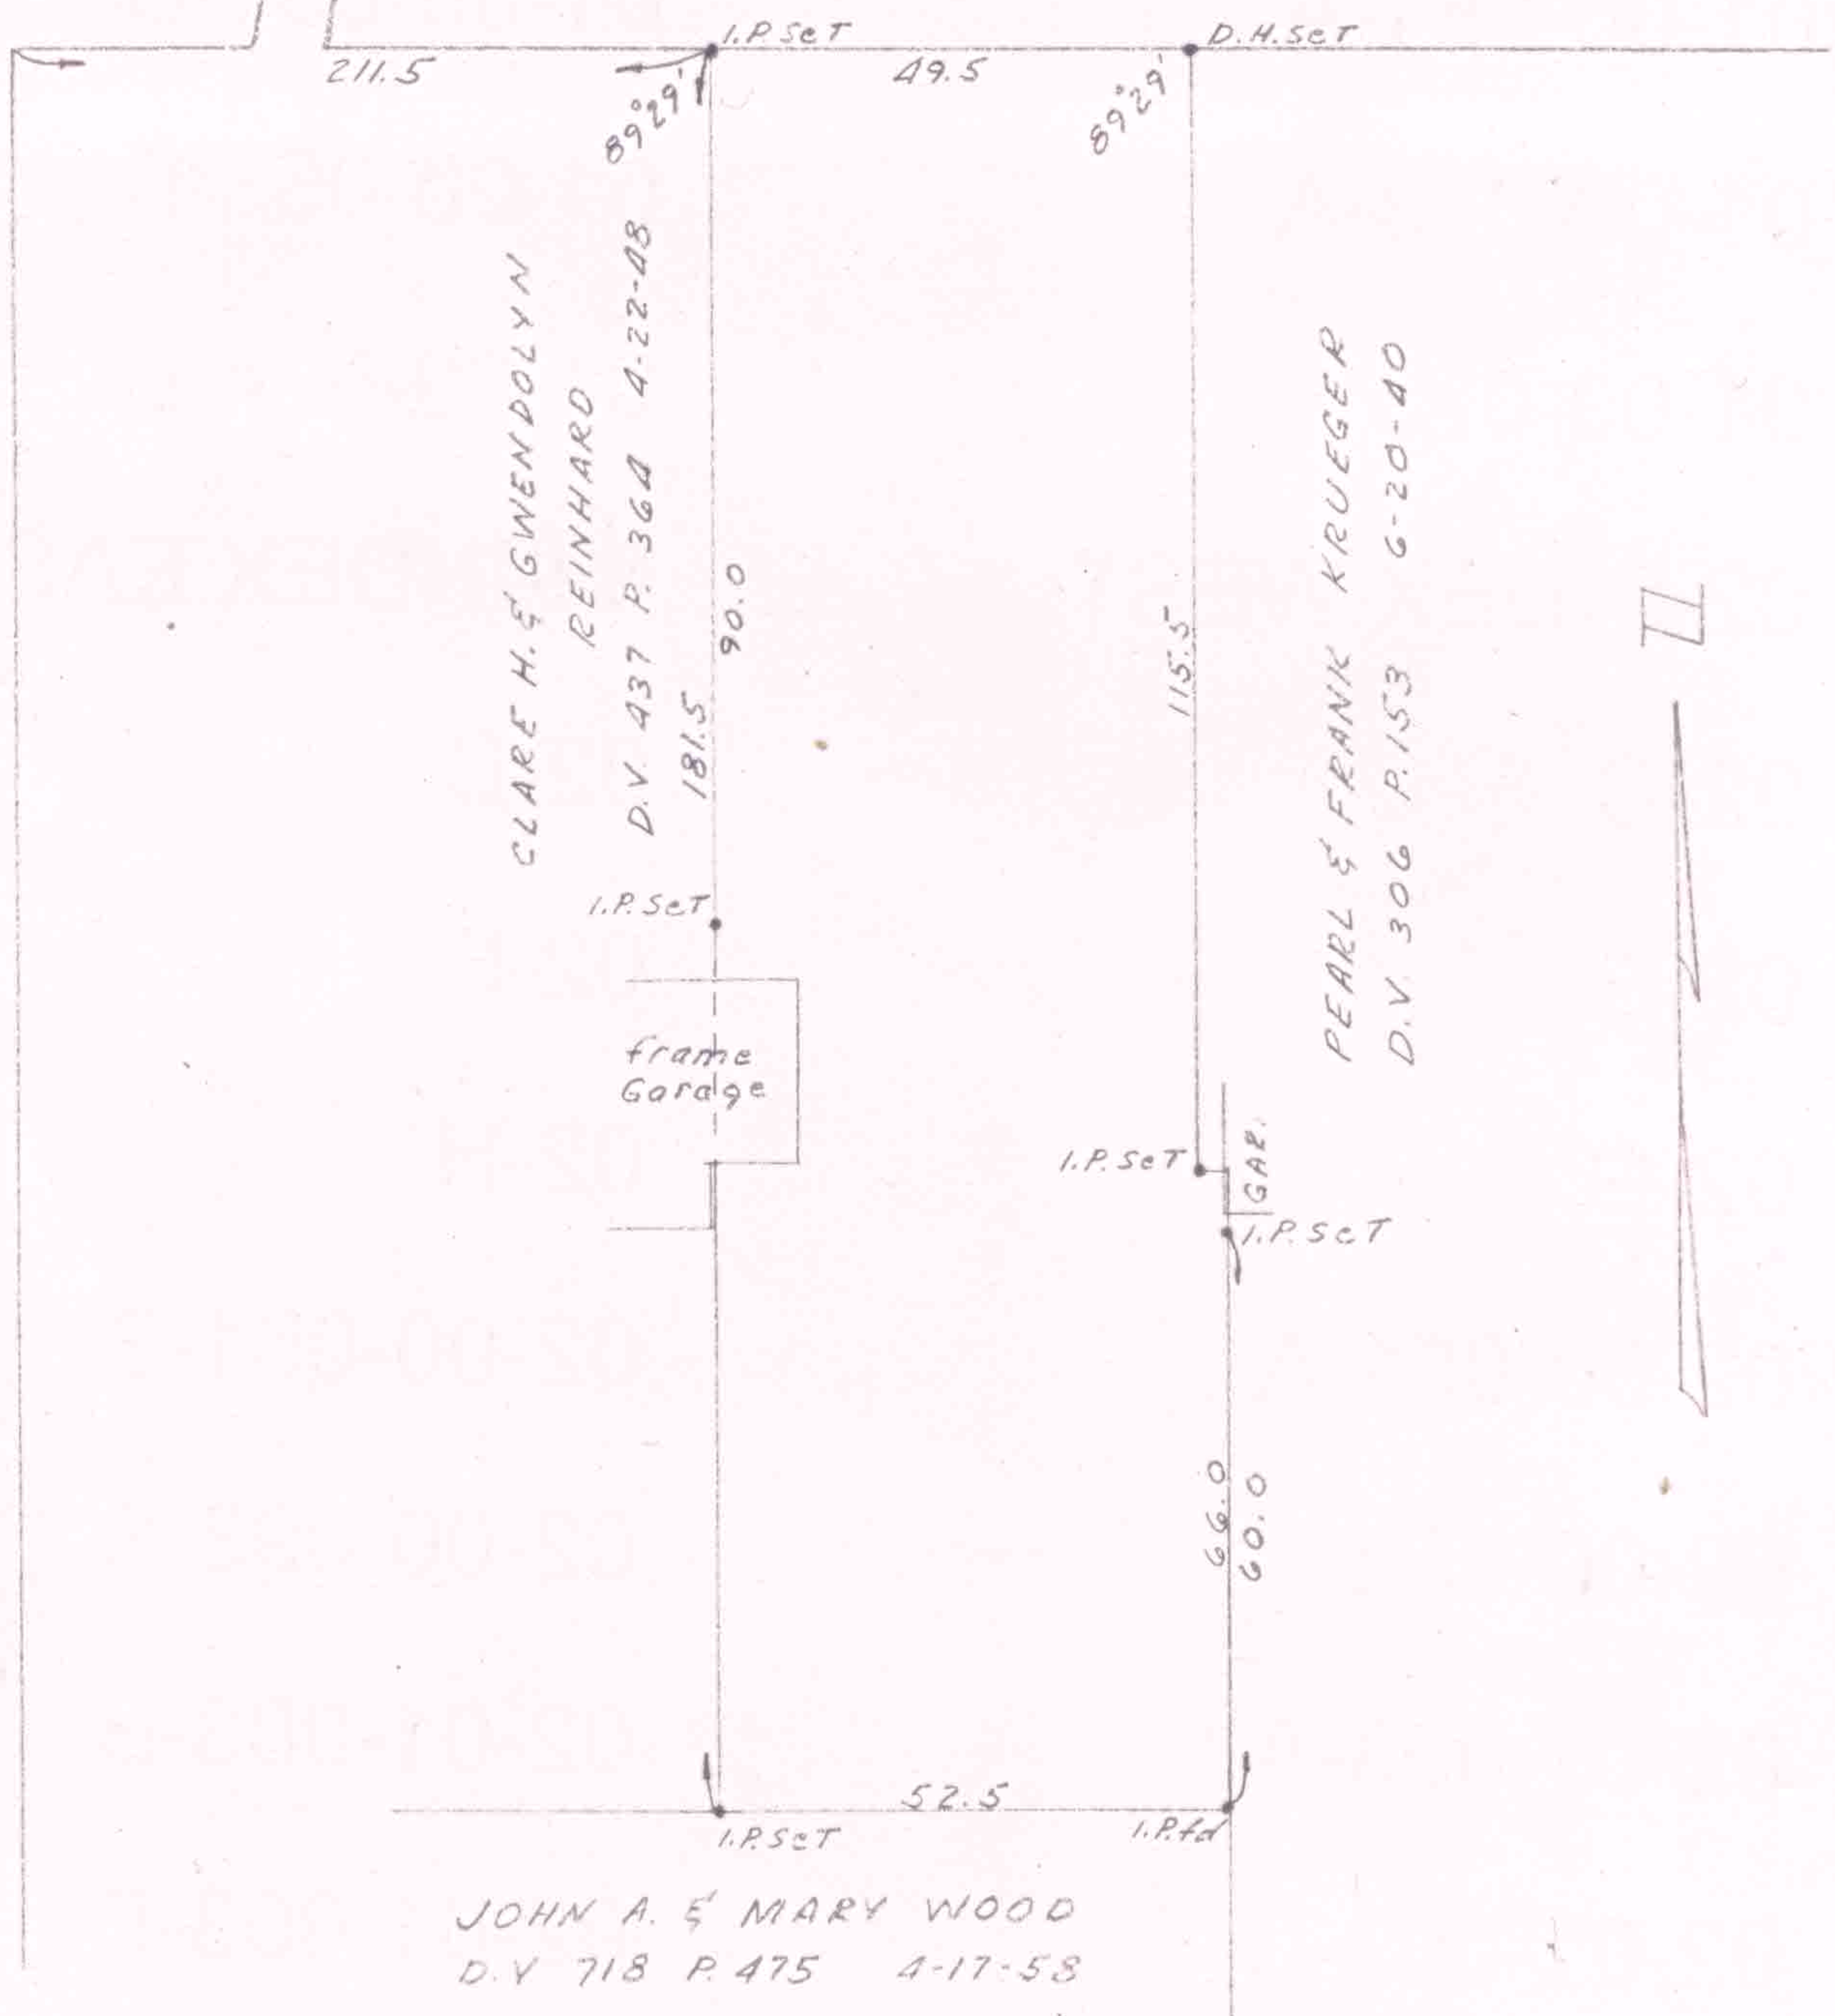

JOHN A. & MARY WOOD
D.V. 718 P. 475 4-17-58

SURVEY FOR
EDWARD WONG
PART OF O.V.L. 49,196,197 RUSSIA TWP
OBERLIN CITY LORAIN CO. OHIO
SCALE 1" = 30' 3-31-60
LAUNDON & HUFFMAN REG SURVEYORS