


I.P. used 33.0'

MAPLE ST.

9-00-076-101-011
9-00-076-A
Scan # 46558

NORTH MAIN ST. 66'

UNION ST.
I.P. used

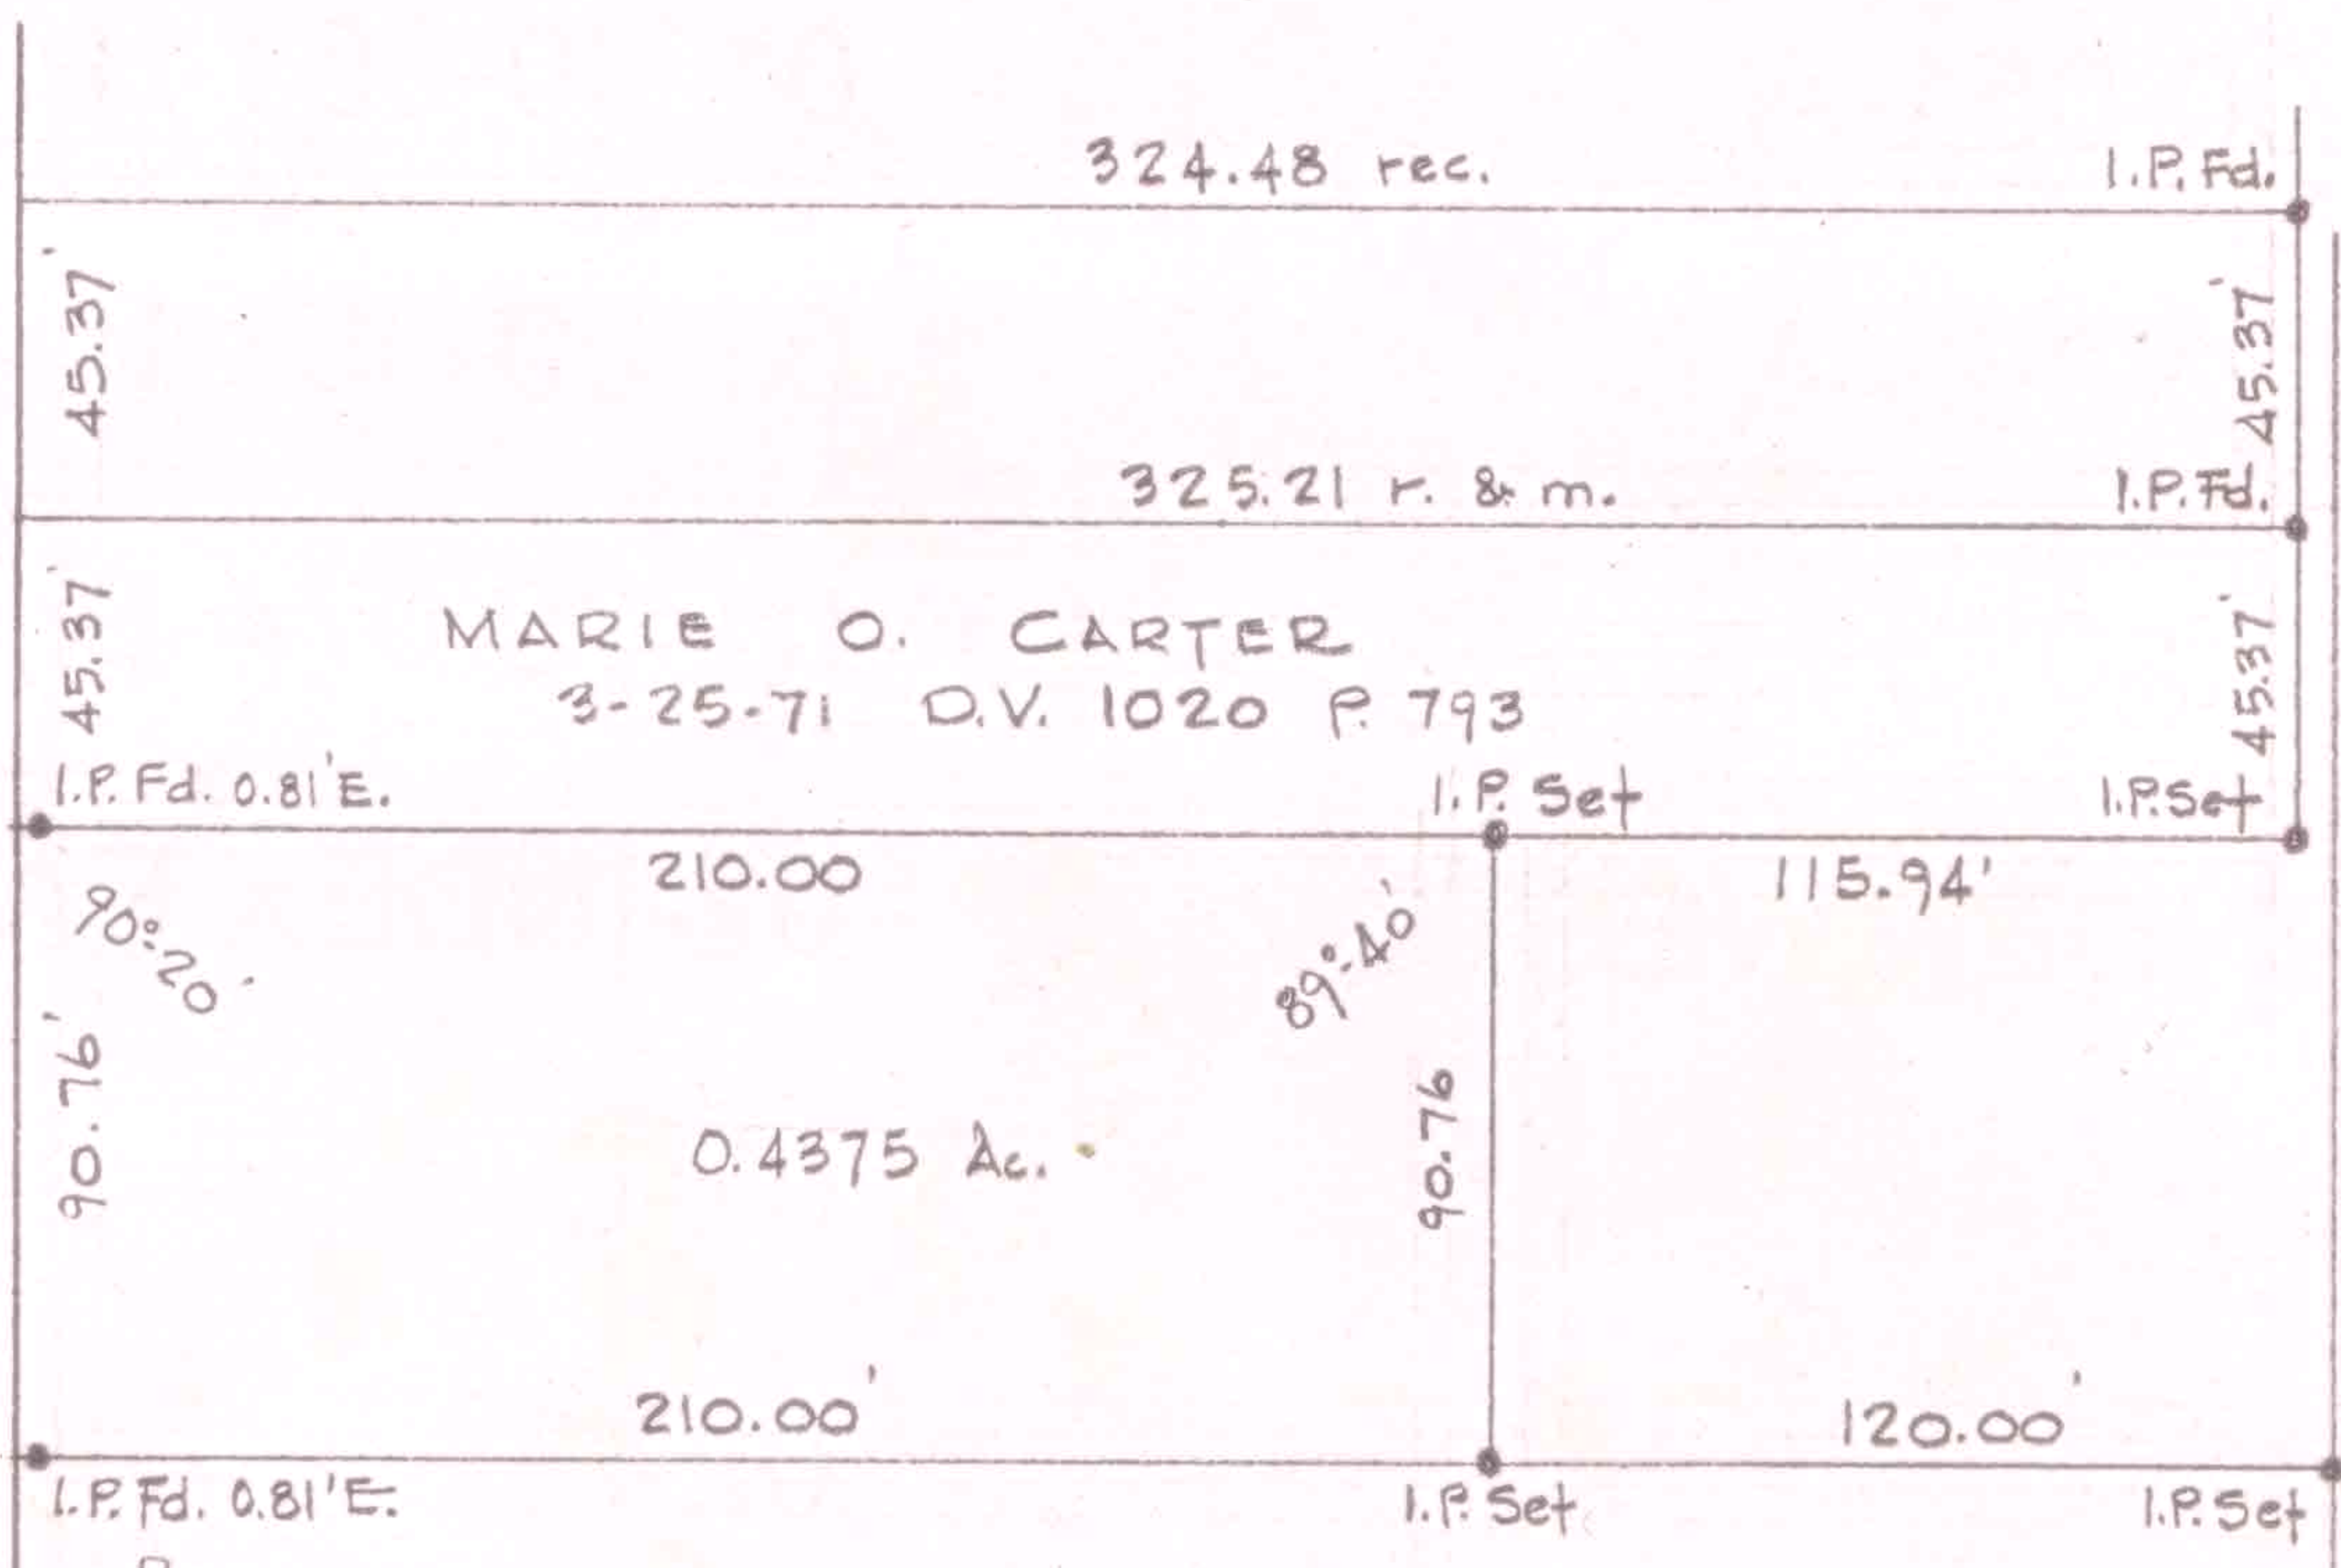

90°20' DUANE R. & LINDA L. KESSLER
10-18-74 D.V. 1113 P. 76



SURVEY FOR
ROBERT L. SCOTT

PART OF O.V.P. 42 O.L. 76 RUSSIA TWP.
CITY OF OBERLIN LORAIN COUNTY OHIO
SCALE 1"=60' DEC. 13, 1977
LAUNDON • SIMON • CAHL & ASSOC.
ENGINEERS SURVEYORS

Job 77-680 F.B. 160/29