


9-00-077-101-014
 9-00-077-A
 SCAN # 40560

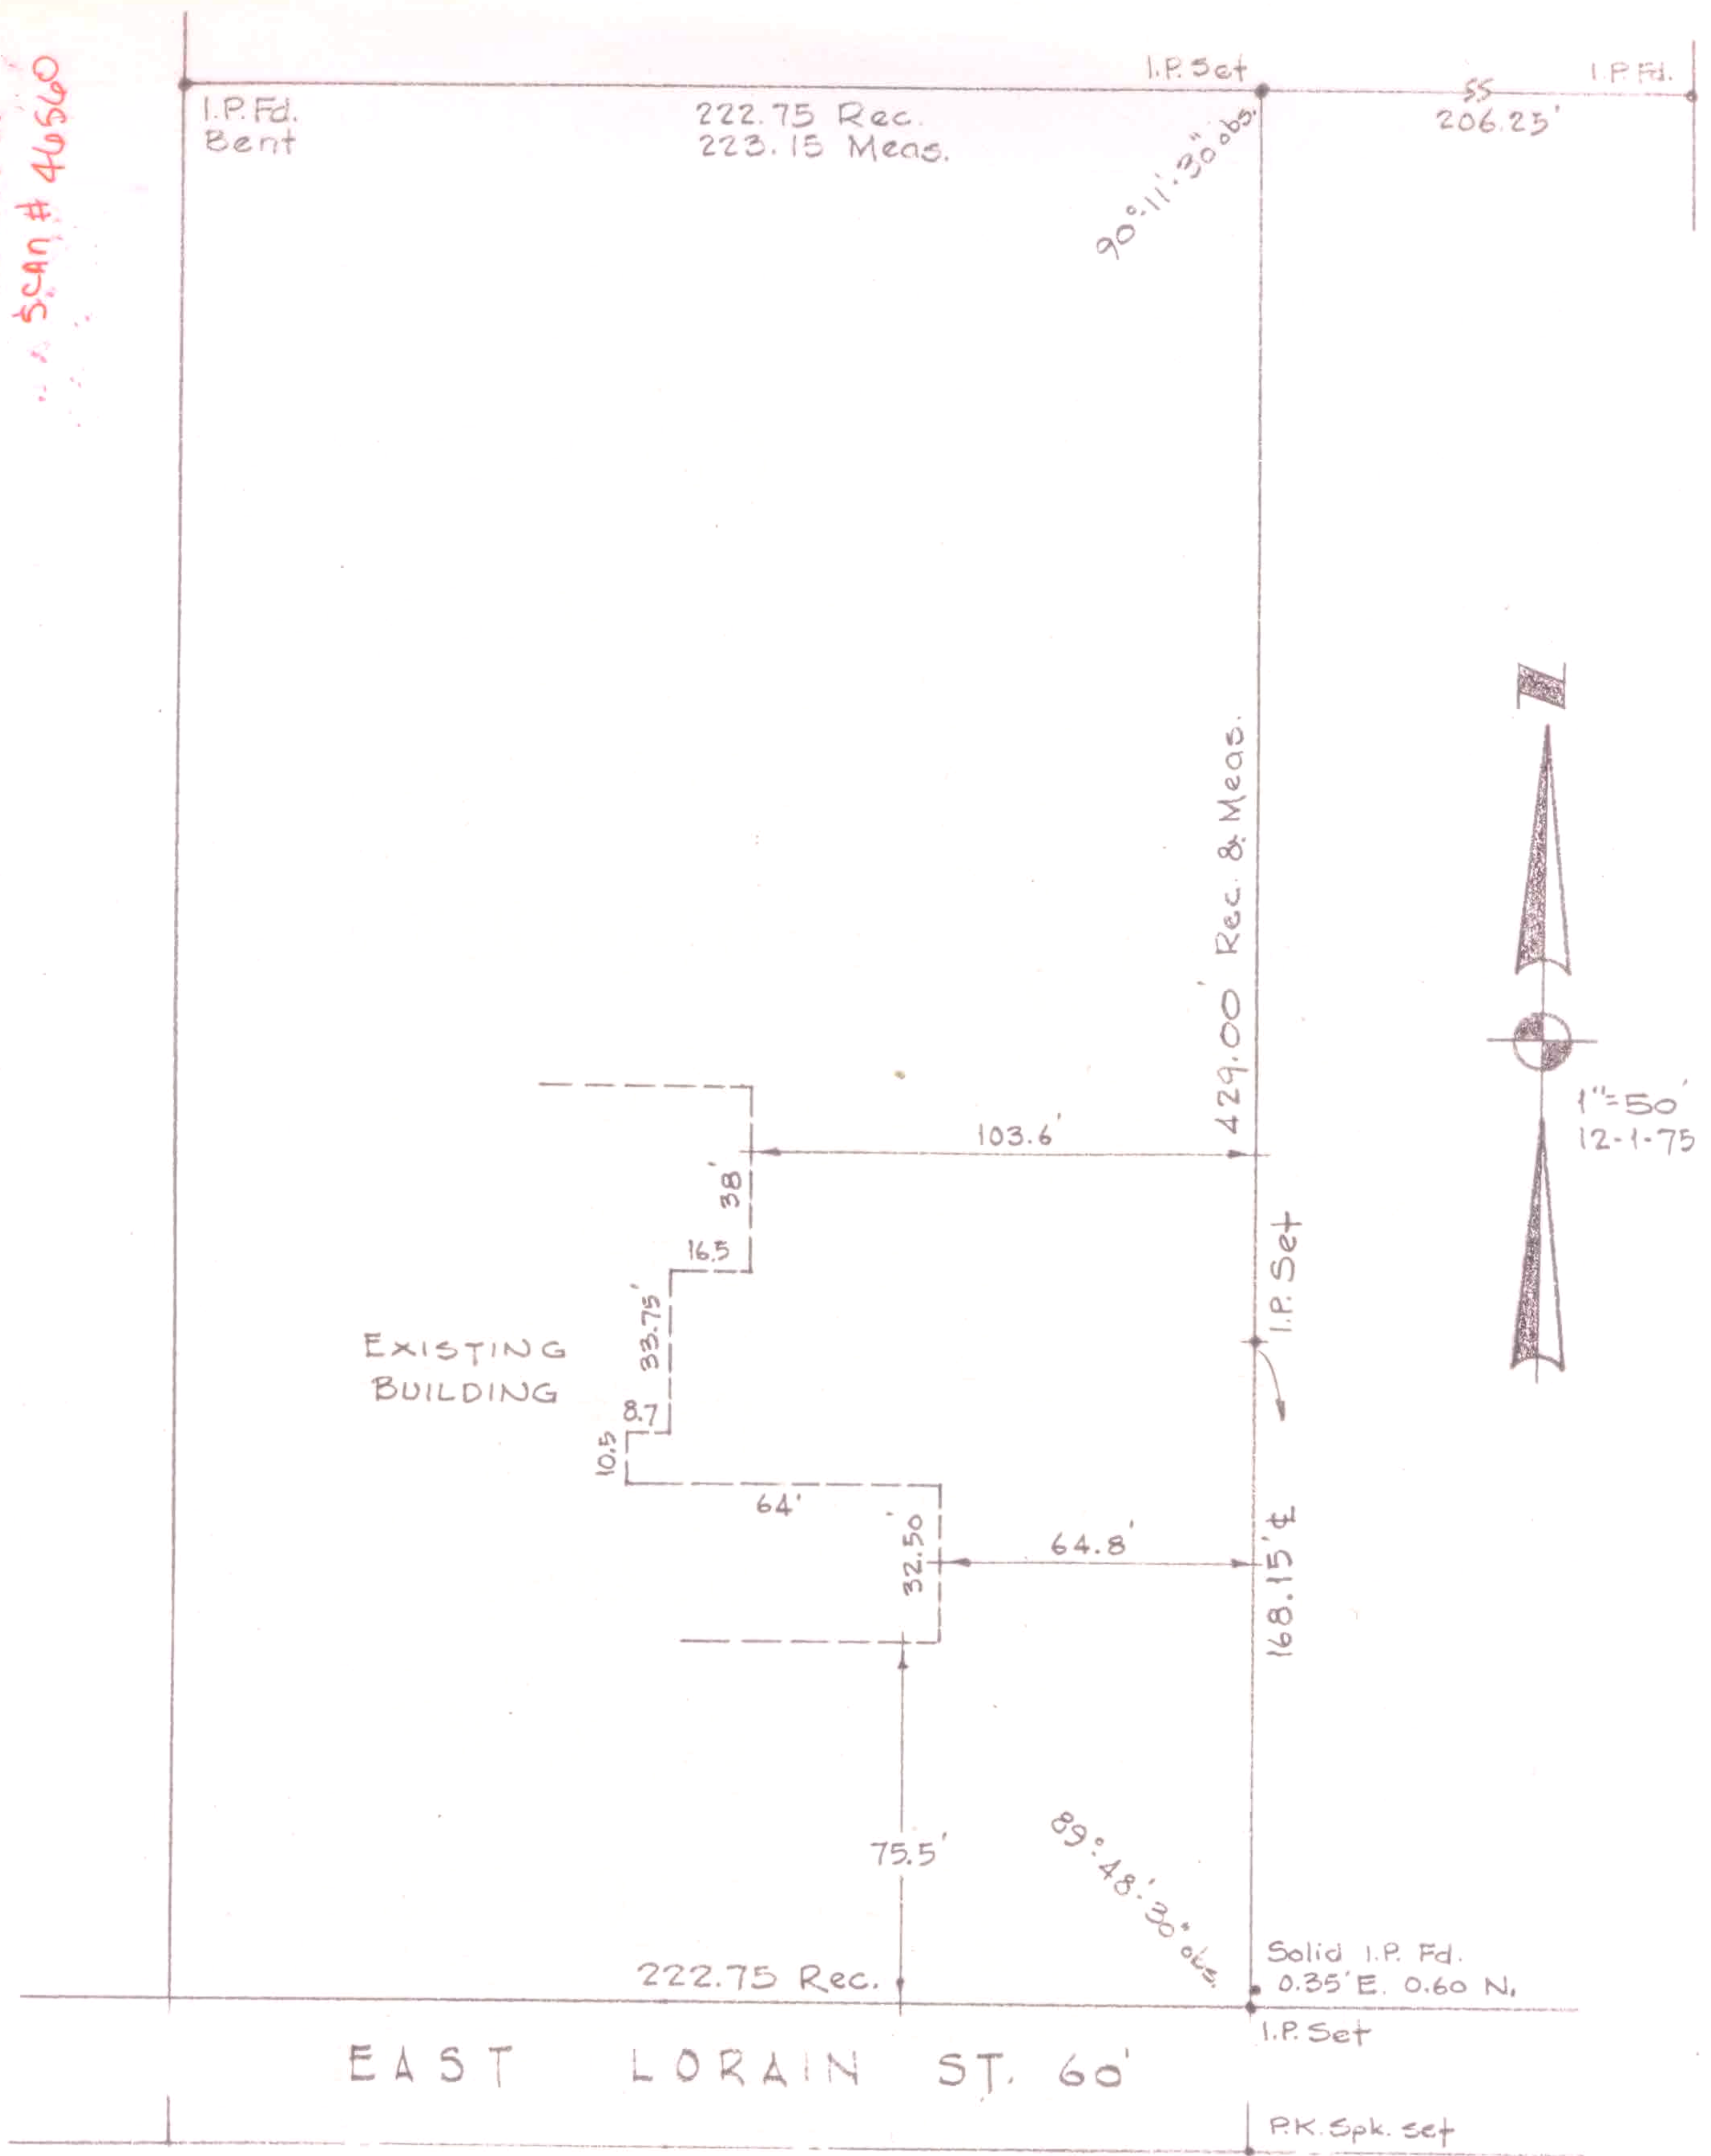

ESTABLISHMENT OF E. PROPERTY LINE
 CARTER NURSING HOME

O.L. 77 RUSSIA TOWNSHIP CITY OF OBERLIN
 LORAIN COUNTY OHIO

Job No. 75-447
 FB. 195-15

LAUNDON • SIMON • CAHL & ASSOC.
 ENGINEERS SURVEYORS