



LAUNDON • SIMON • CAHL and ASSOC.  
ENGINEERS  
504 MIDDLE AVE.

SURVEYORS  
ELYRIA, OHIO 4035


FOR: BARBARA R. SMITH

TOWNSHIP RUSSIA  
ORIG. LOT or SEC. 84  
CITY OBERLIN

VILLAGE  
COUNTY LORAIN  
STATE OHIO

DATE 3-31-82  
SCALE 1"=50'  
JOB NO. 82-1117 F.B.125/44

SURVEY OF WESTERLY 33.00' OF S/L 2  
AND ALL OF S/L 3 IN REAMER ADD'N.  
PLAT VOL. 7 PG. 35

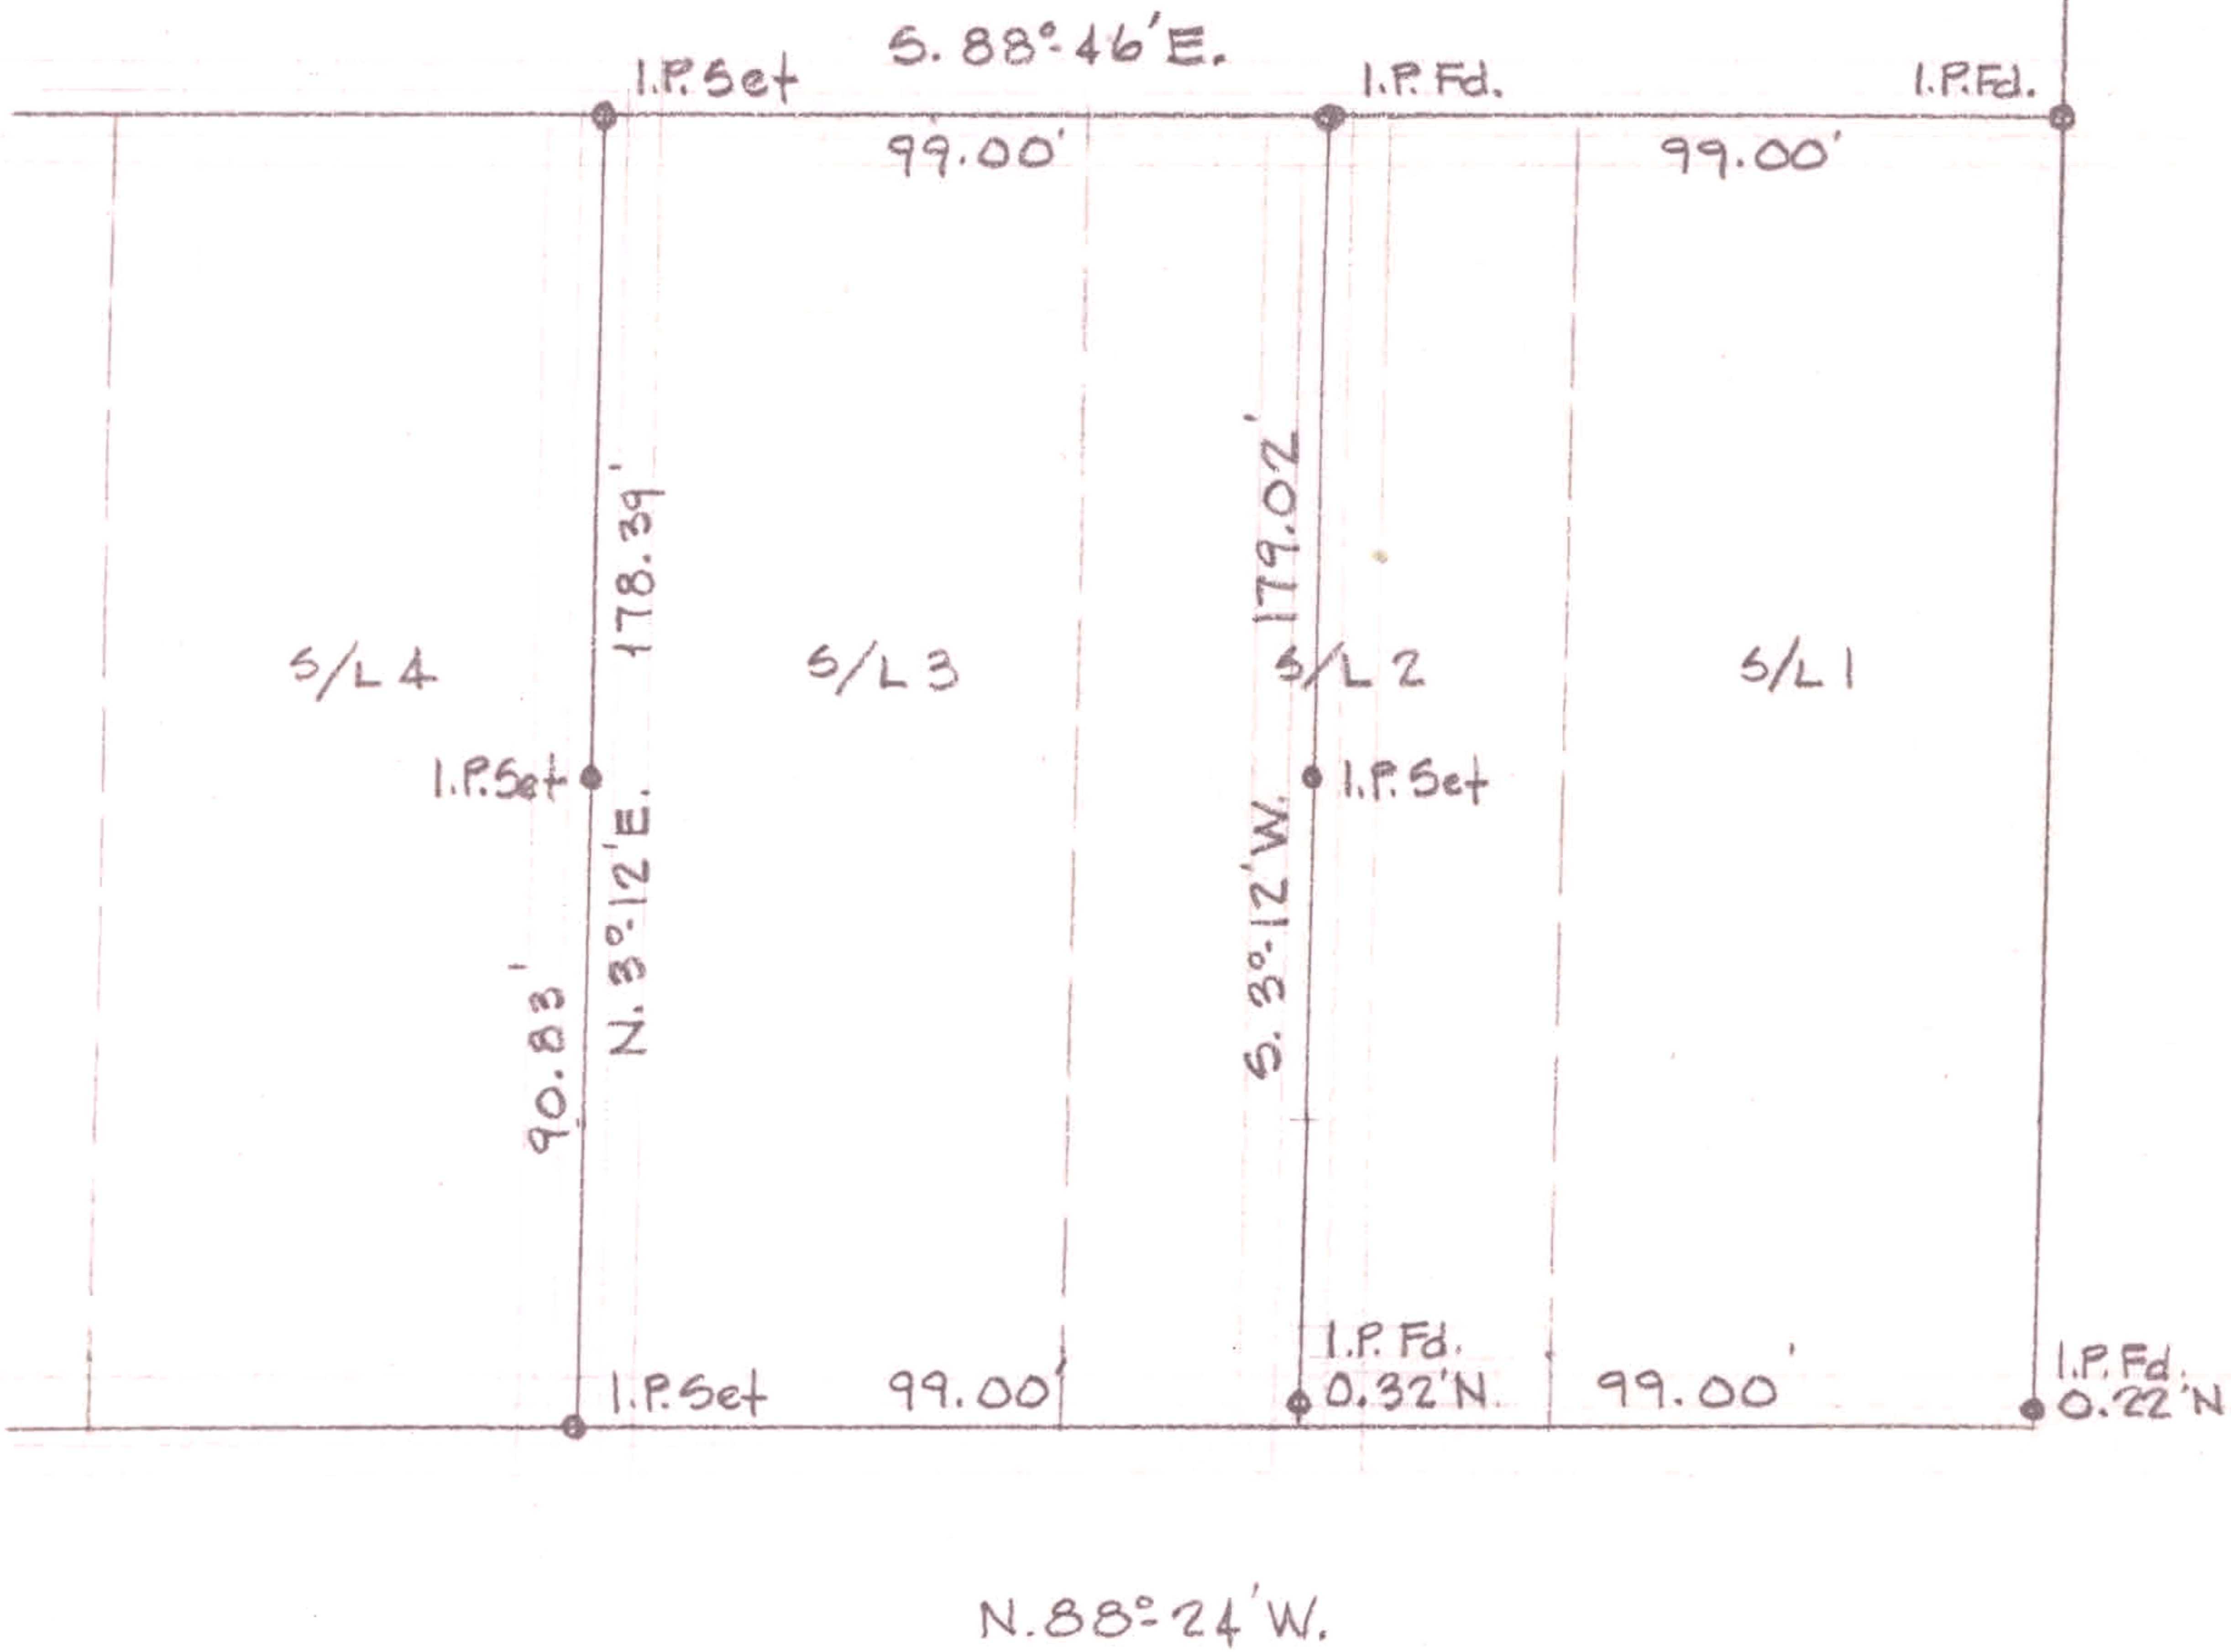

PROSPECT ST. 60'

REAMER PLACE 70'

OAK ST.

9-00-084-B

SCAN # 46569