


P4 9-00-085-101-029
9-00-085-A
SCAN # 46573

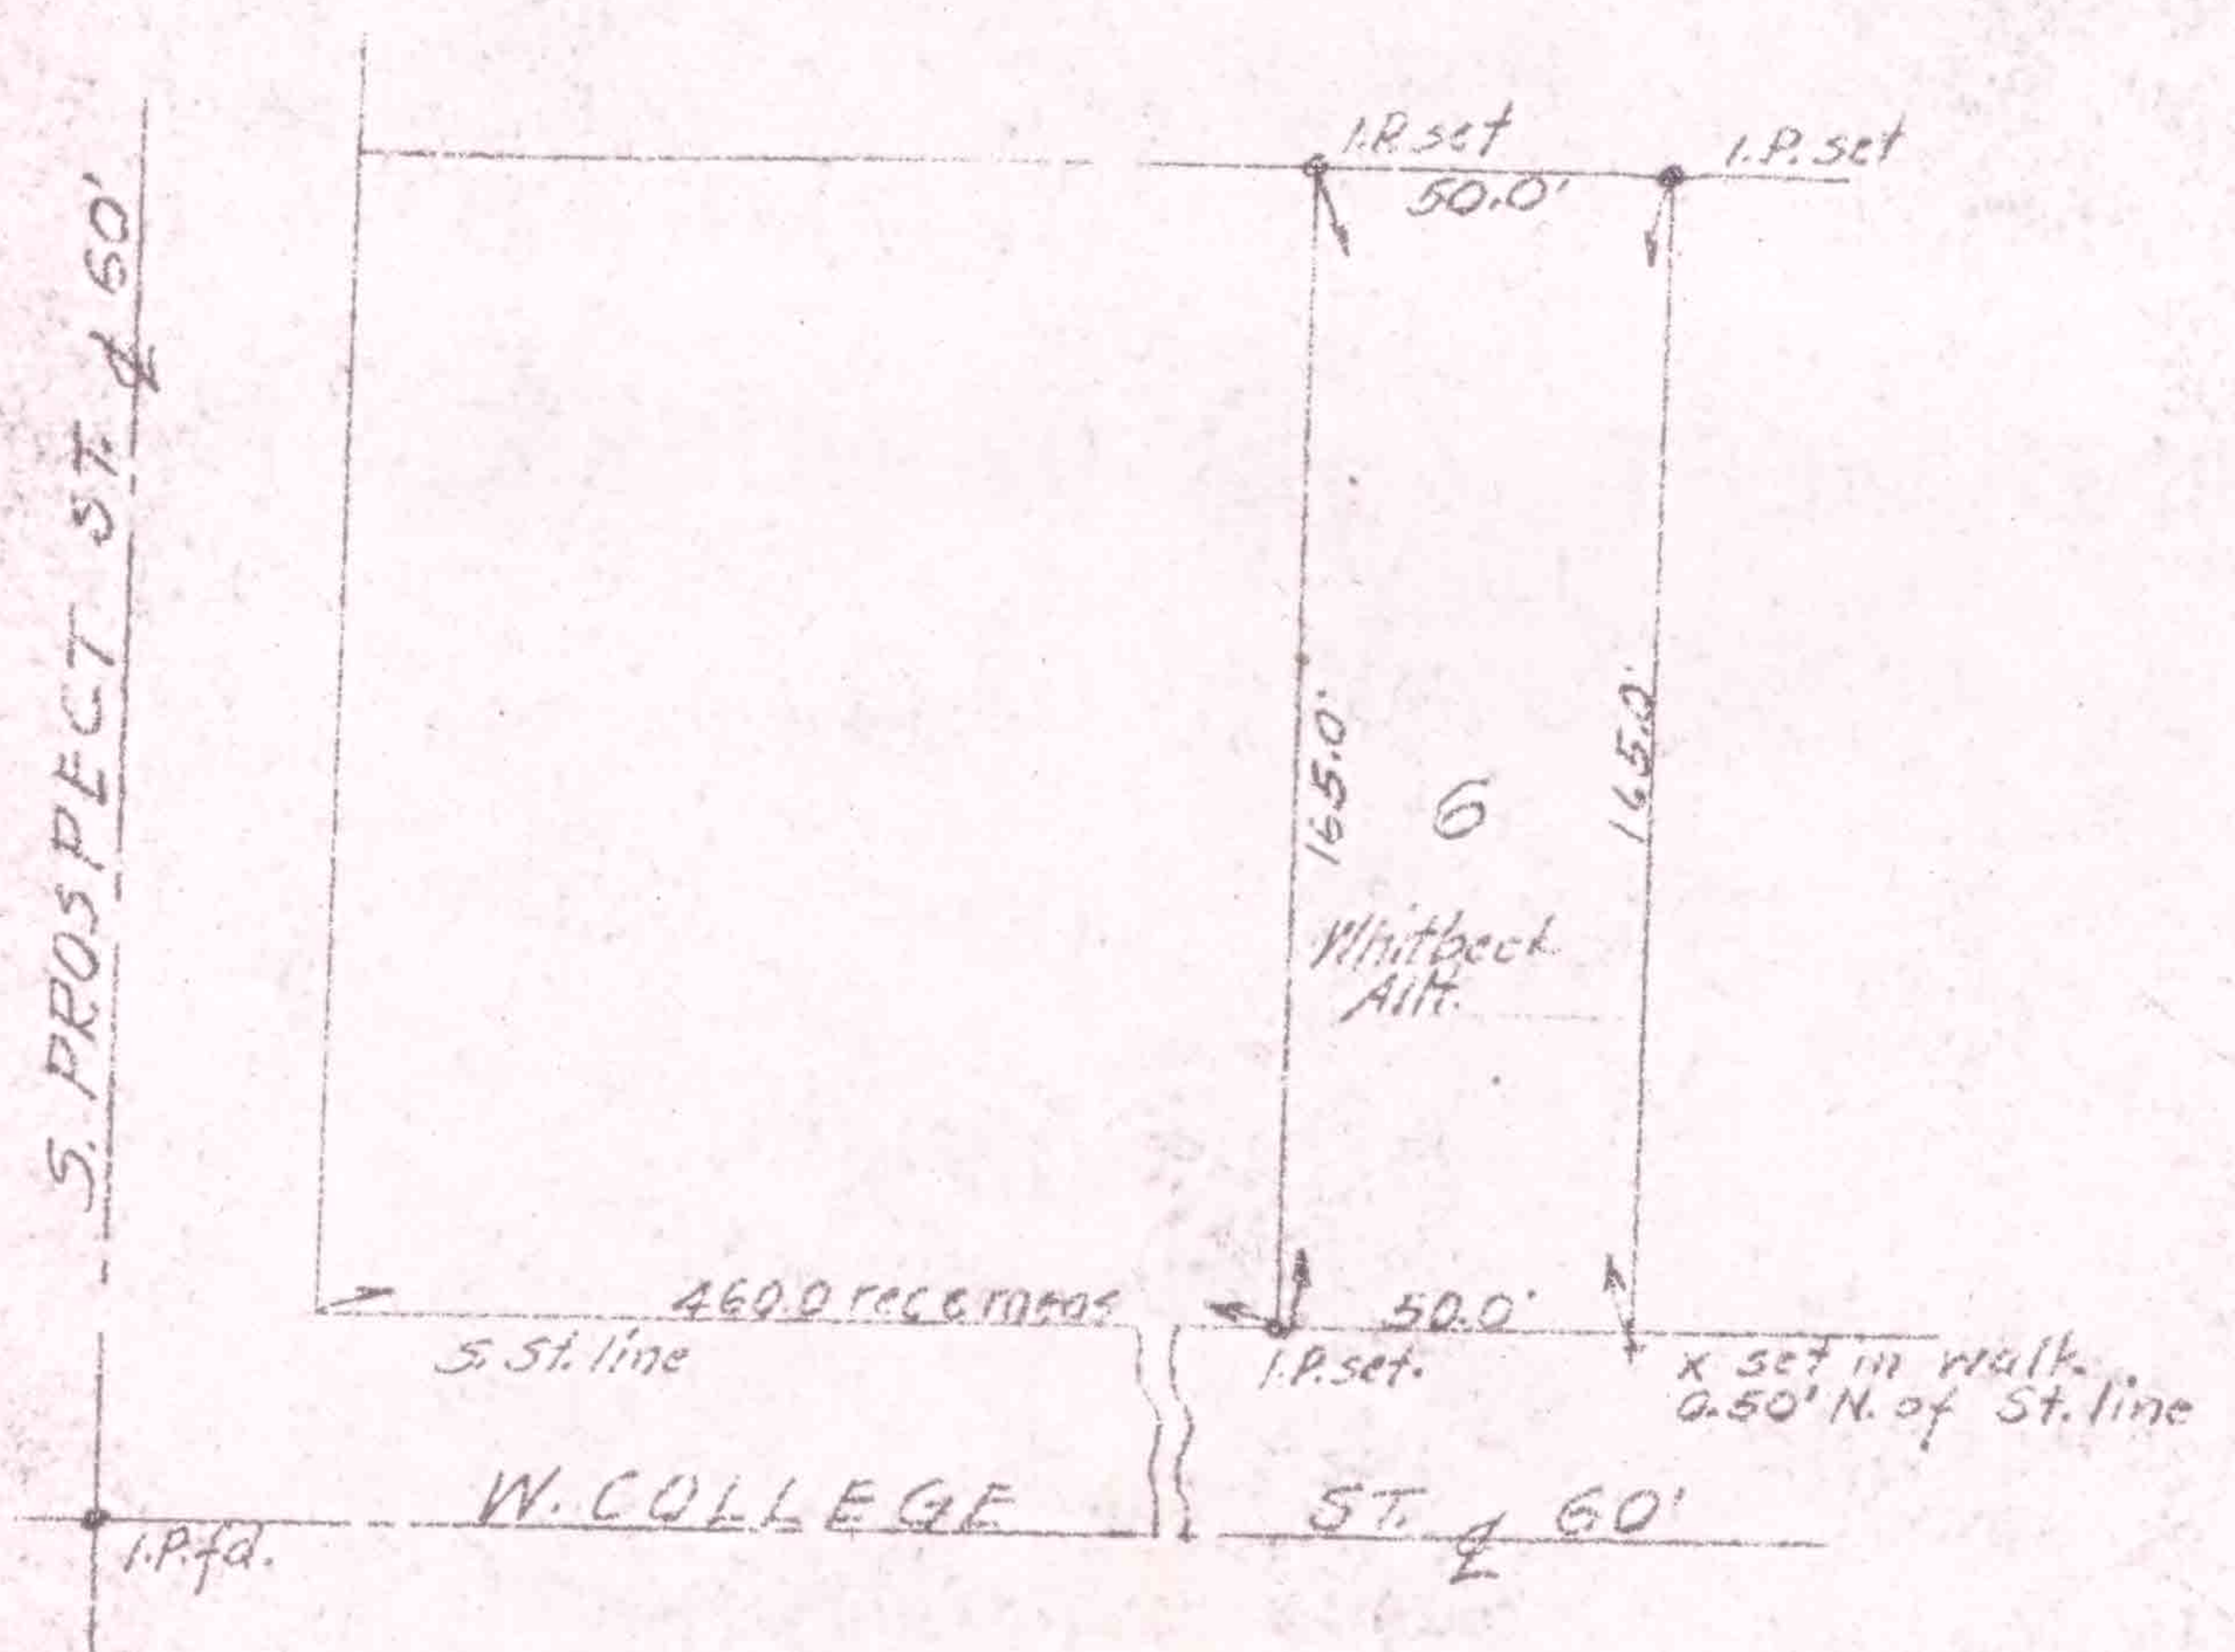

Sketch of Survey for Charity Kilgore
Lot 6 Whitbeck Alt. Oberlin Village
Lorain Co. Ohio Scale 1" = 50'
Feb. 15, 1944 T.W. Laudan, Reg. Surveyor.