


9-00-085-101-056
9-00-085-A
SCAN # 46575

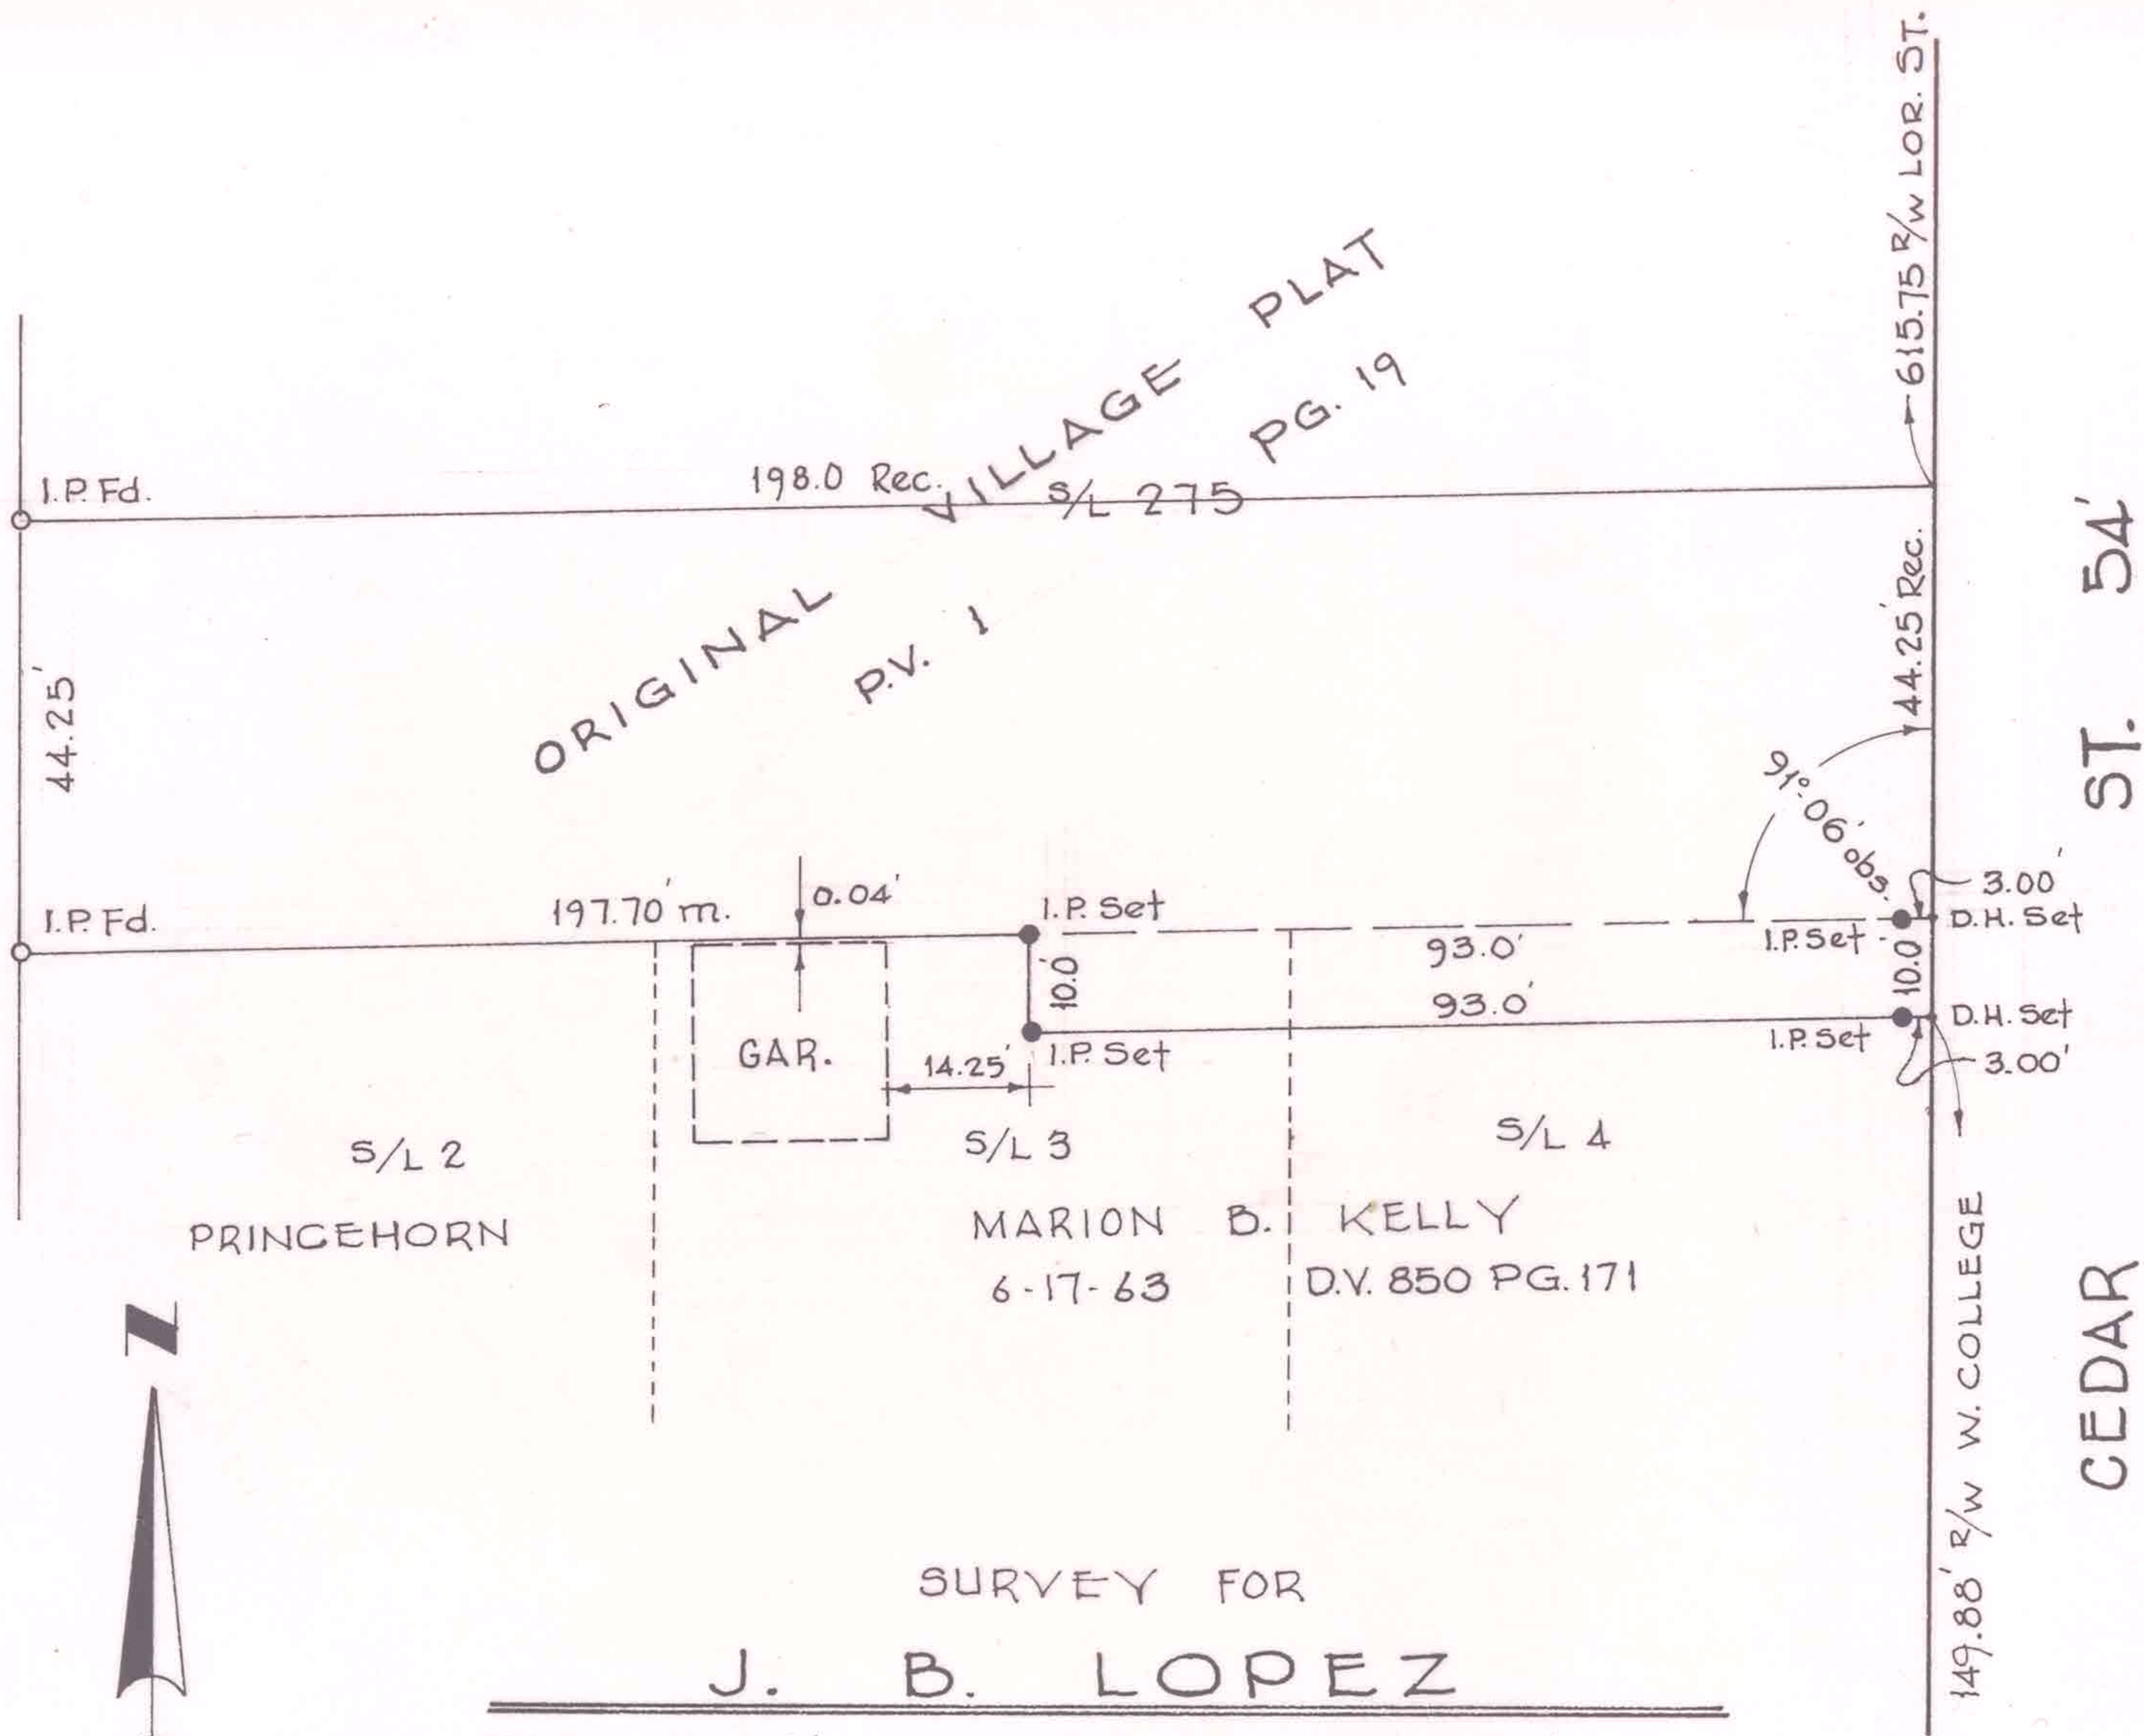

SURVEY FOR
J. B. LOPEZ
PART OF S/L's 3 & 4 BRADFIELDS ADD'N. P.V. 1-28
O.L. 85 RUSSIA TWP.
CITY OF OBERLIN LORAIN CO., OHIO
SCALE 1" = 30' NOV. 4, 1975
LAUNDON • SIMON • CAHL & ASSOC.
ENGINEERS SURVEYORS