


9-00-085-102-010  
9-00-085-A  
Scan # 46576

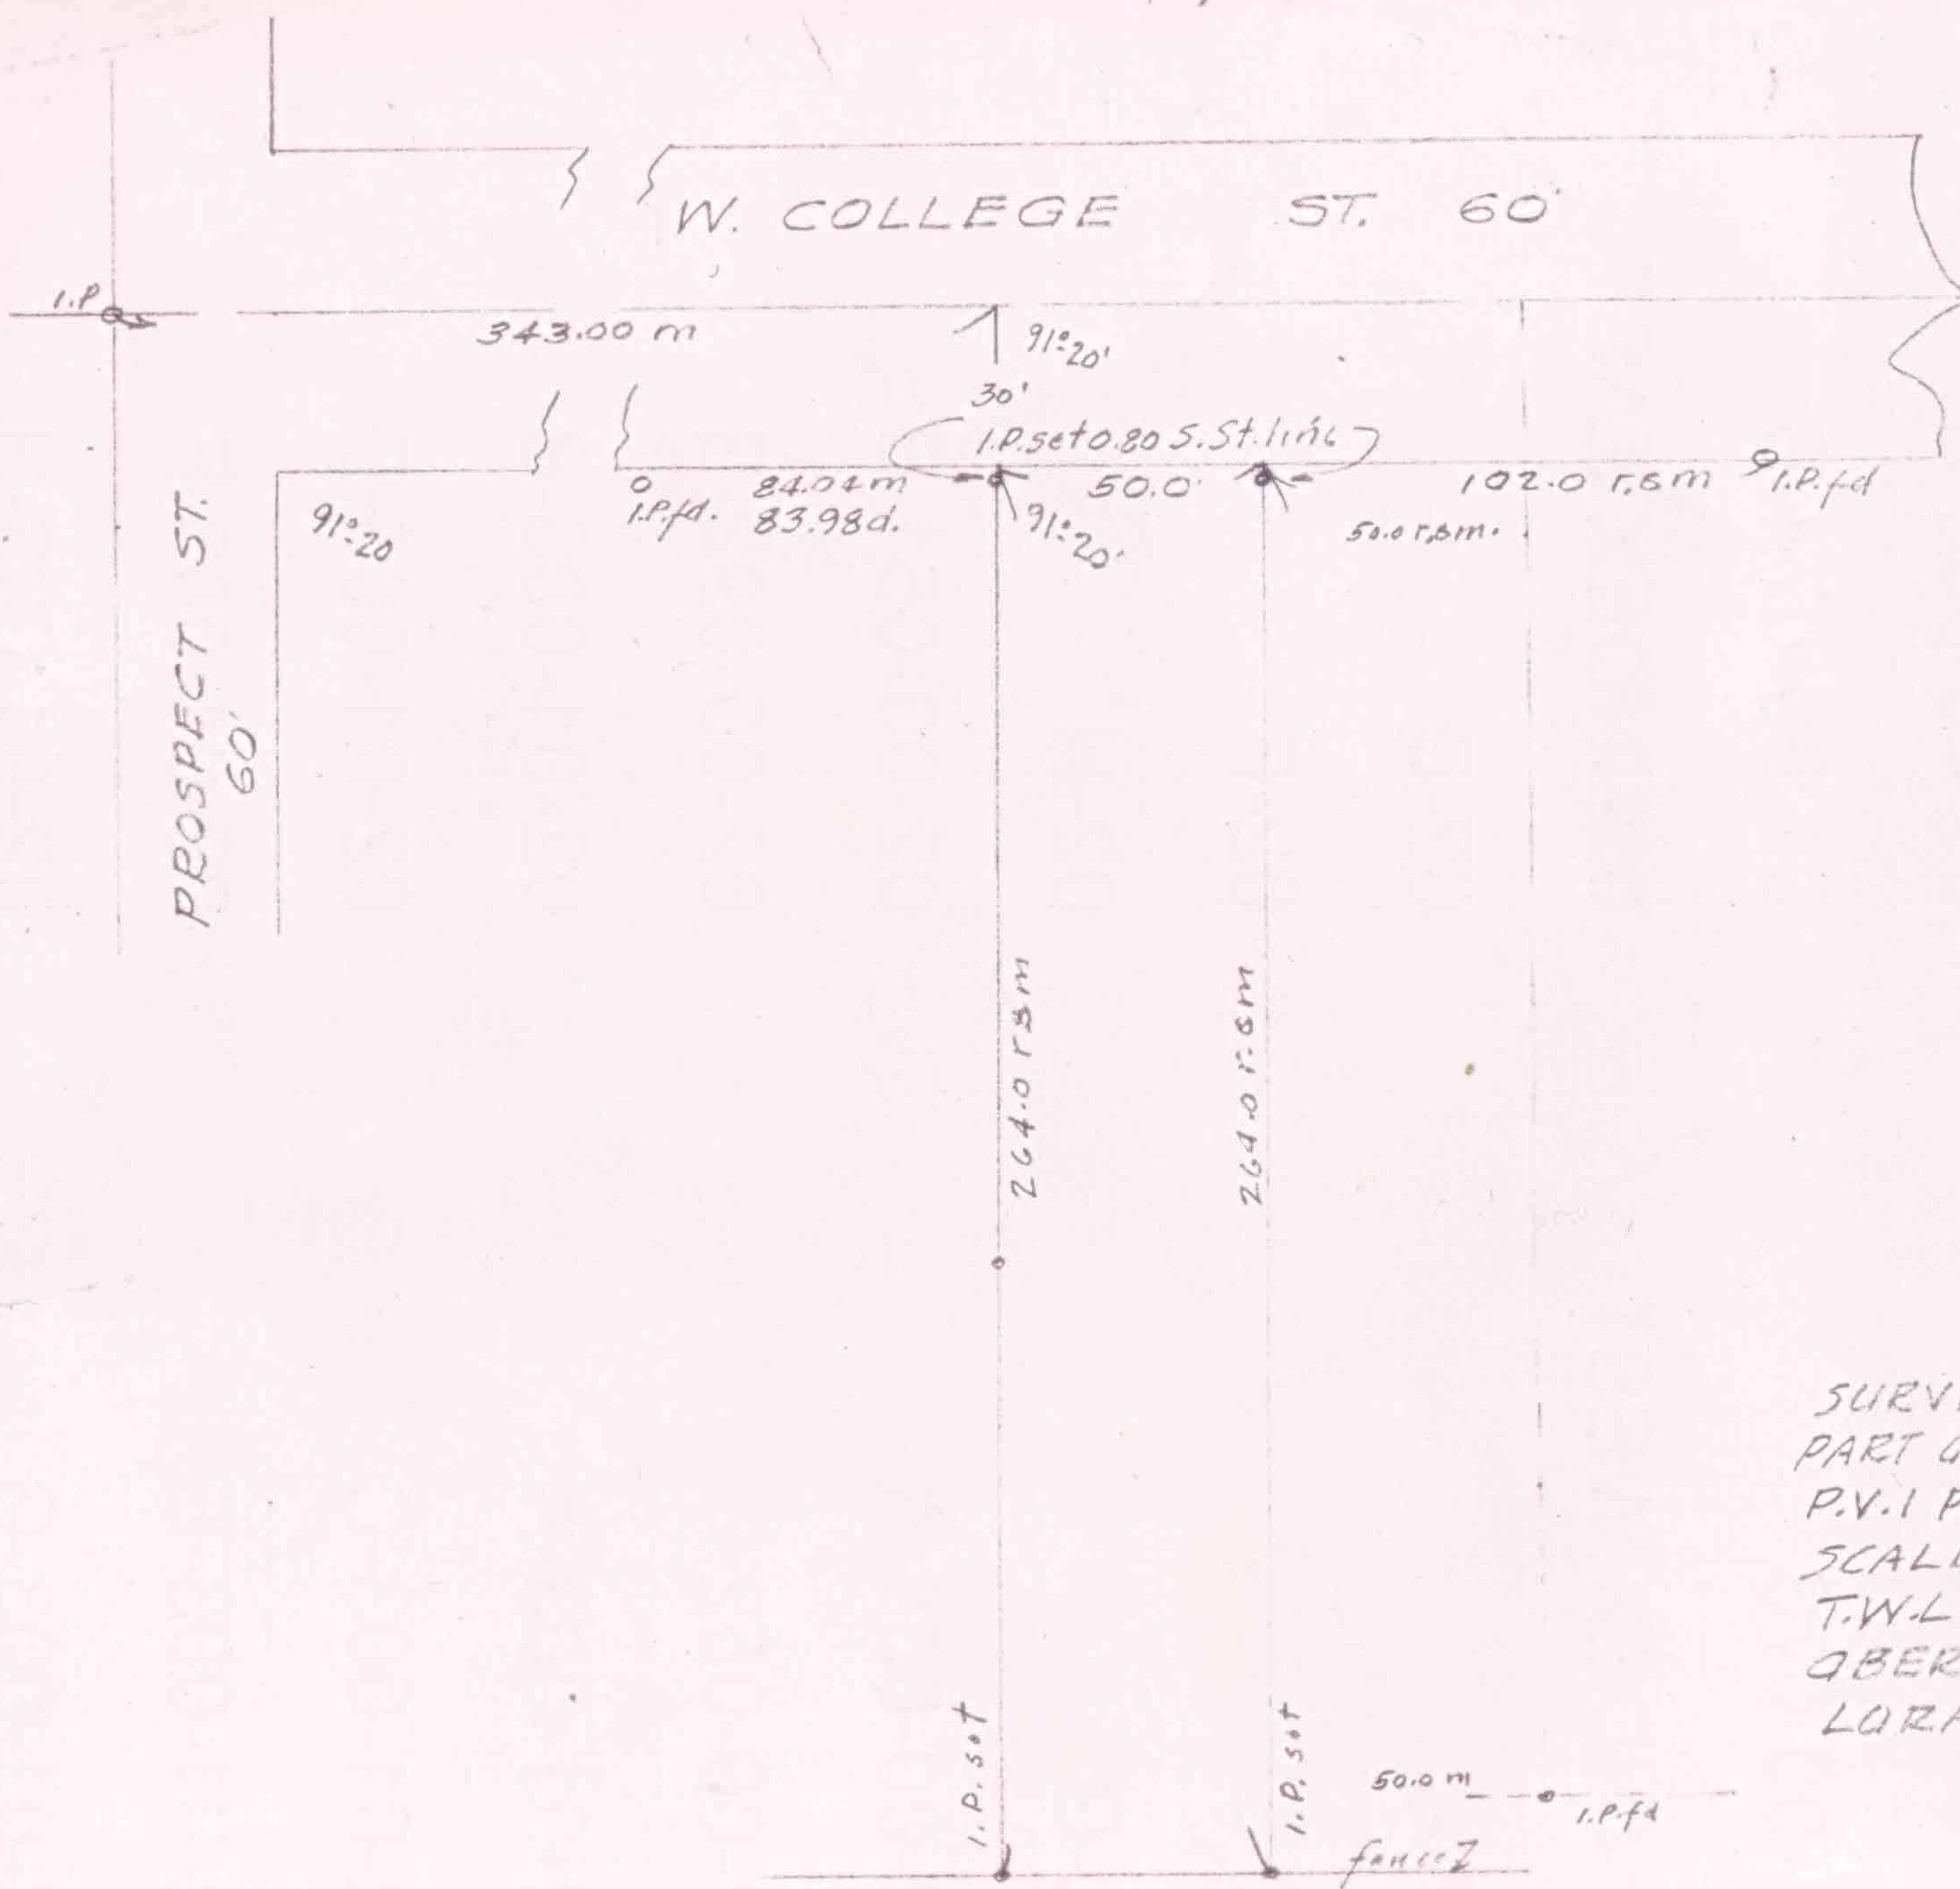

SURVEY OF CARL W. KINNEY LOT,  
PART OF LOT 2 URIAH HAWLEY SUBD  
P.V. 1 PG. 7 LOR. CO. REC. PLATS.  
SCALE 1"=50 OCT 10 1950  
T.W. LAUNDON REG. SURVEYOR,  
BERLIN VILLAGE  
LORAIN CO. OHIO.