

9-00-085-105-031
 9-00-085-105-032
 9-00-085-105-033
 9-00-085-A

Ohio
 Professional
 Surveyor
 No. 9094
 Exp. 3-21-11

SCAN # 46582

THOMAS W. LAUNDON
 CIVIL ENGINEER AND SURVEYOR
 405 Elyria Building
 ELYRIA OHIO

Municipal Engineering
 Surveys - City, Farm,
 Sub-divisions

W. COLLEGE ST 60'


SURVEY FOR ALFRED & ETHEL S.T.
 SCHLESINGER

LOT 5 URIAH HAWLEY ADDN. REC. PLAT, VOL 1, PG. 7.
 LORAIN CO. RECORD OF PLATS,
 OBERLIN VILLAGE LORAIN CO. OHIO

SCALE 1" = 60' MAY 17, 1946
 T.W. LAUNDON REGISTERED SURVEYOR

2 4

r = record or deed
 m = measured

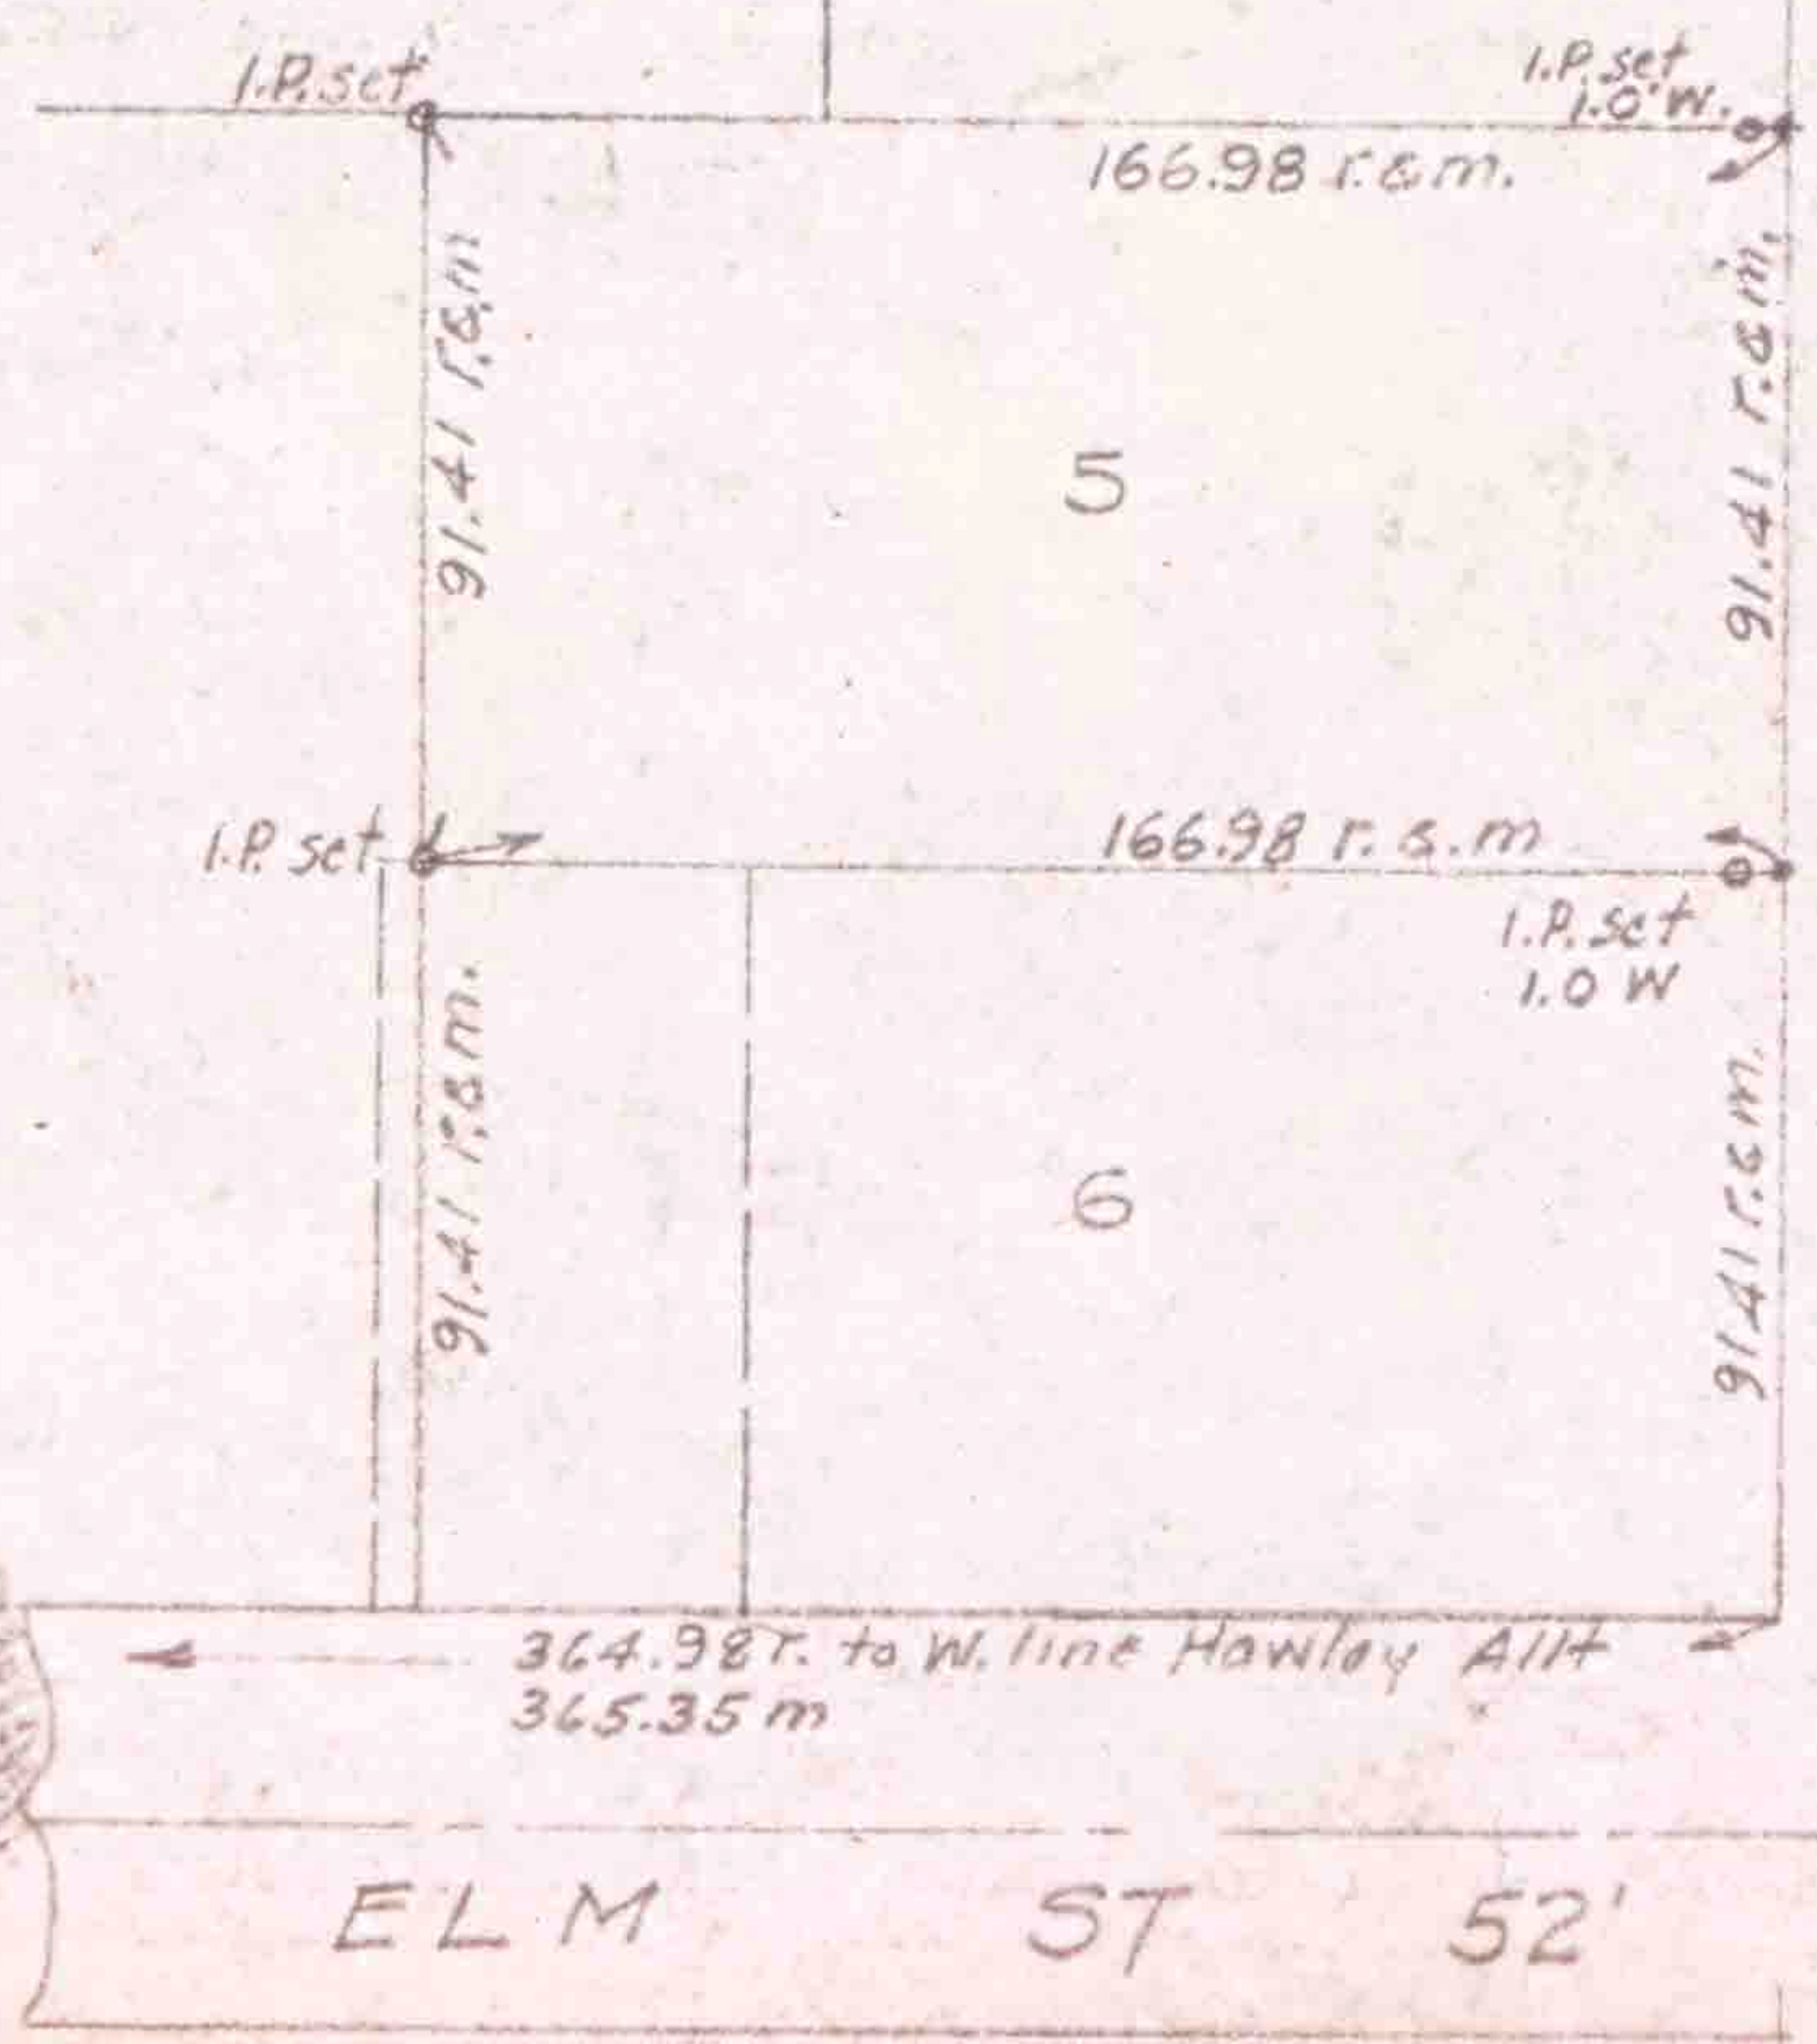

502.82 r.
 497.53 m.

S. CEDAR ST

ELM ST 52'

182.582
 2.64
 446.82
 502.82

