


9-00-085-106-
9-00-085-A
Scan # 46586

State of Ohio
Professional
and Surveyor
Home 2094
Office 3211

THOMAS W. LAUNDON
CIVIL ENGINEER AND SURVEYOR
405 Elyria Building
ELYRIA OHIO

Municipal Engineering
Surveys - City, Farm,
Sub-divisions

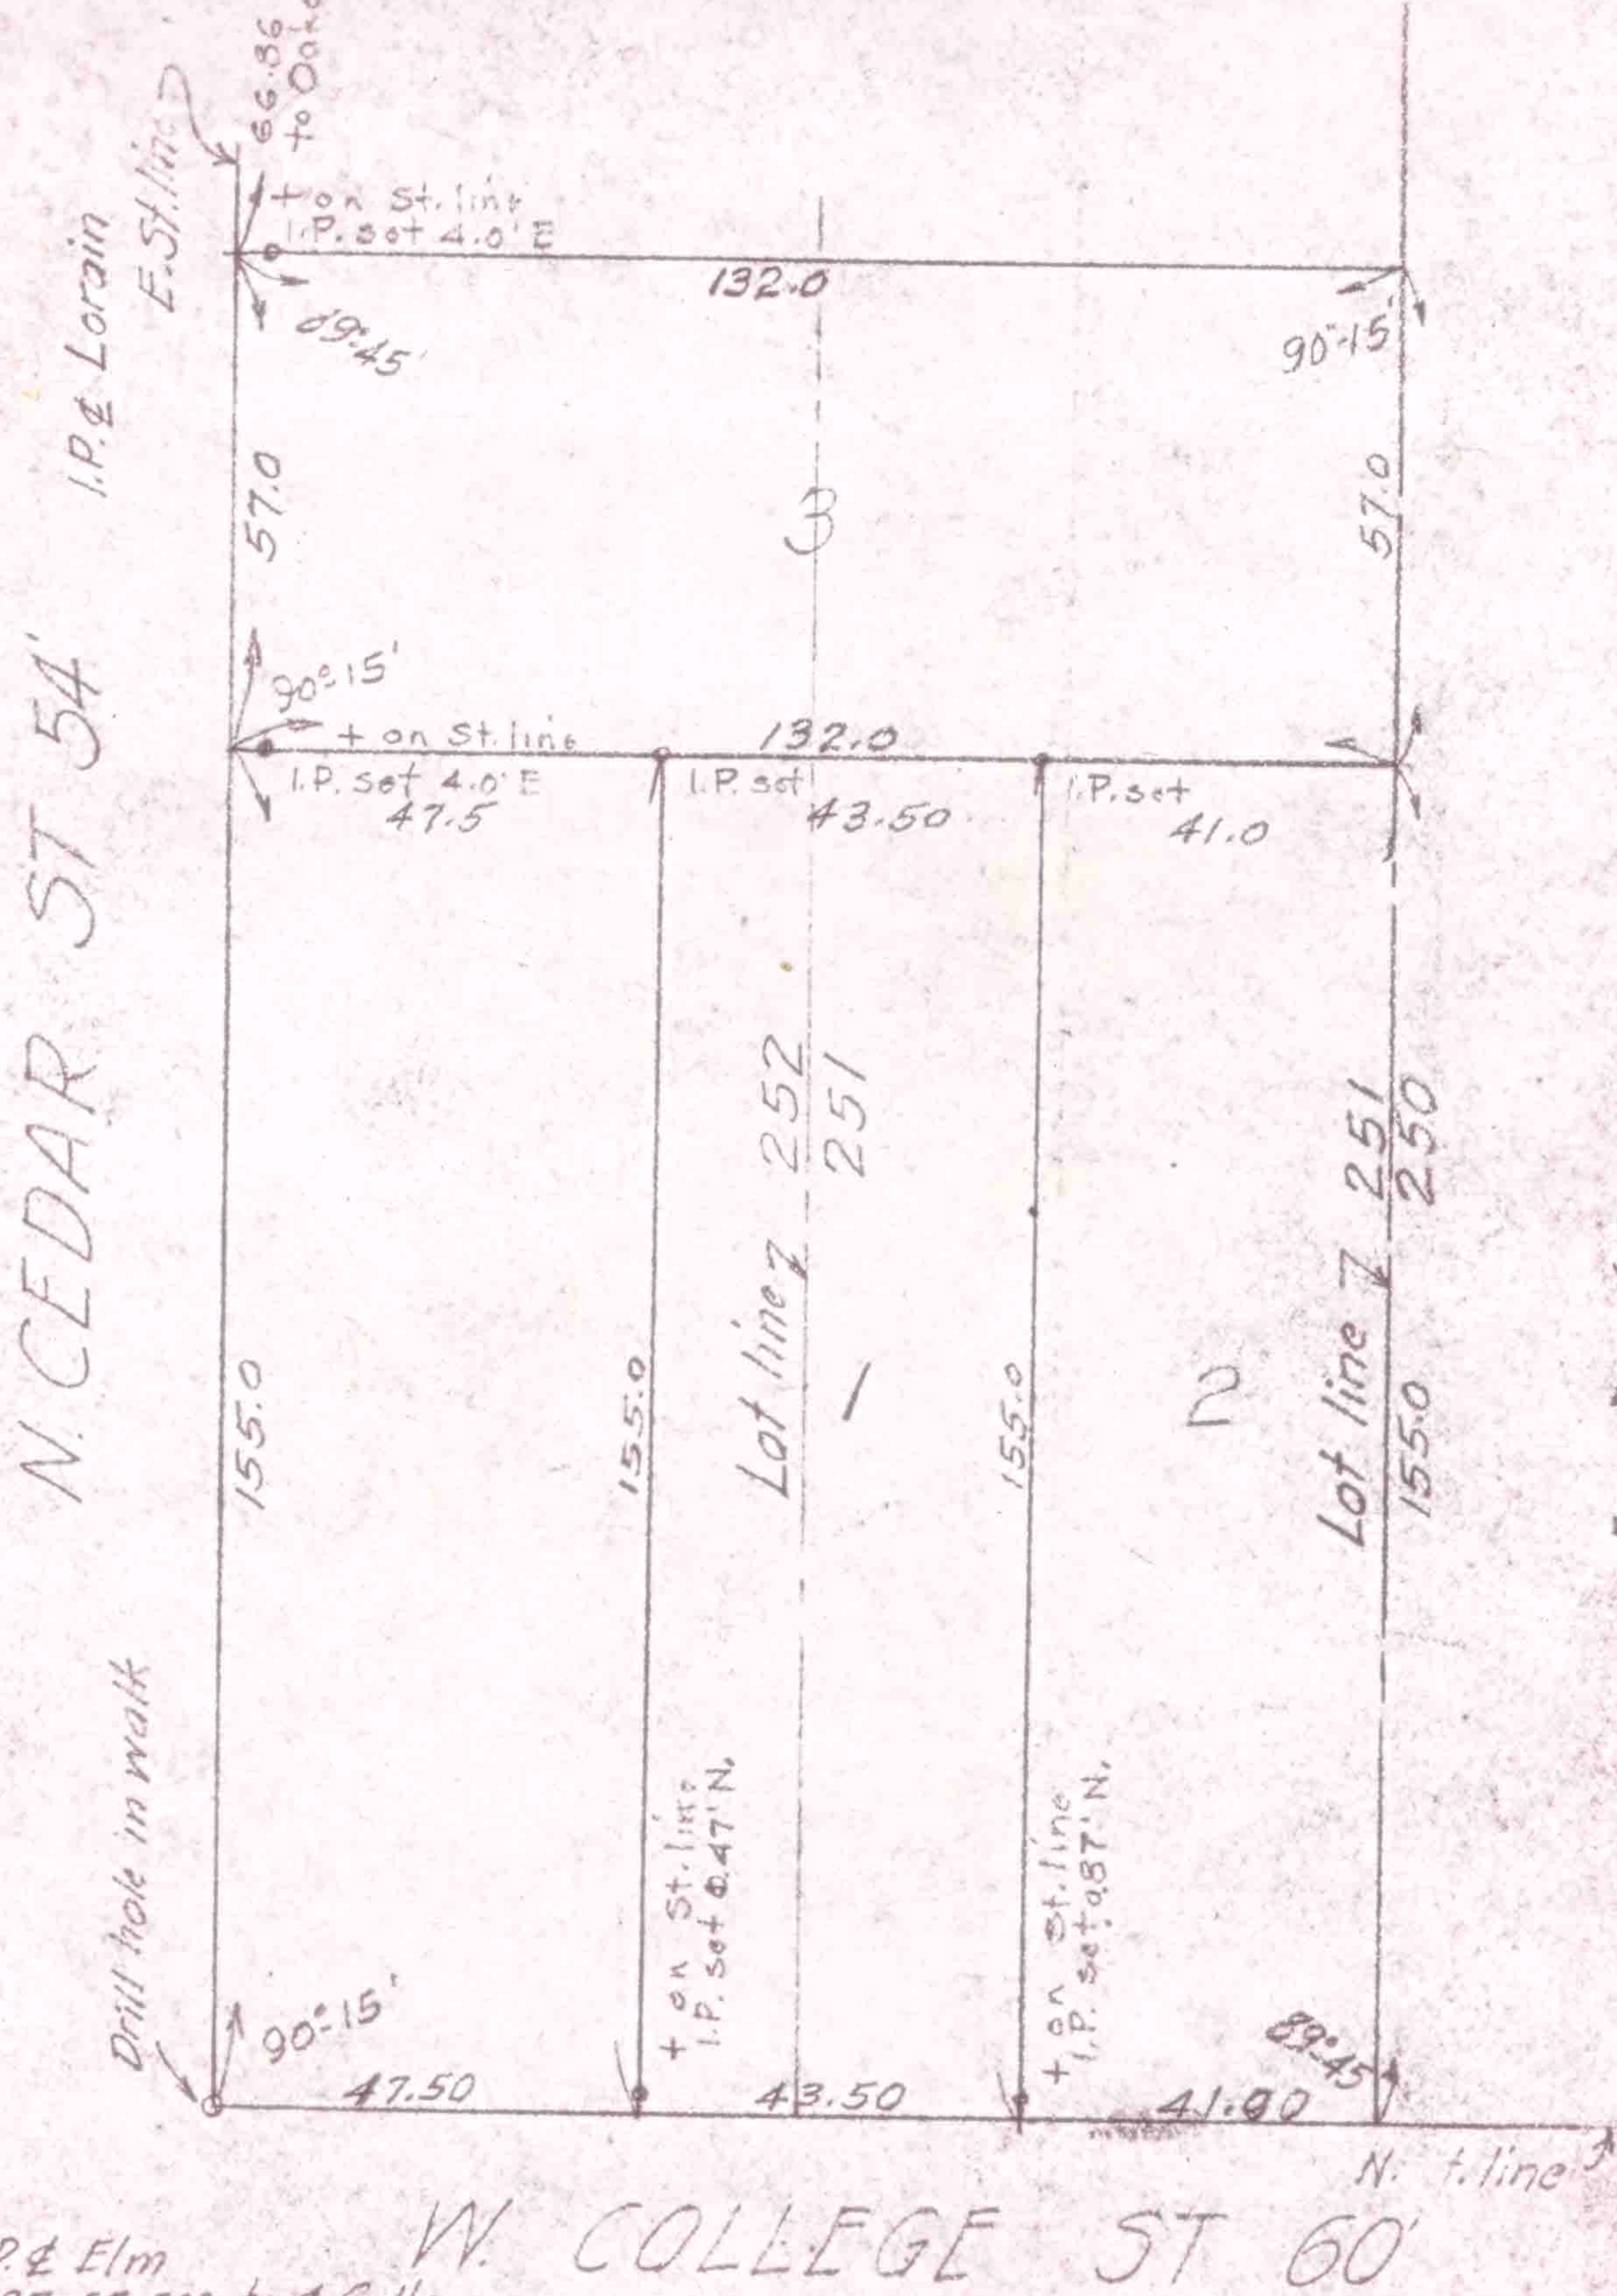

I.P. & Elm
497.57 rec. to College
497.53 meas " "

W. COLLEGE ST 60'

Scale 1" = 30' Sept. 20, 1943
T.W. Laundon Reg. Surveyor

SURVEY FOR OBERLIN COLLEGE
Parts of Lots 250-251-252 O.V.H.
OBERLIN VILLAGE, LURAIN CO. OHIO