


9-00-085-108-002
9-00-085-108-003
SCAN # 46590



ELM ST. 58.08'

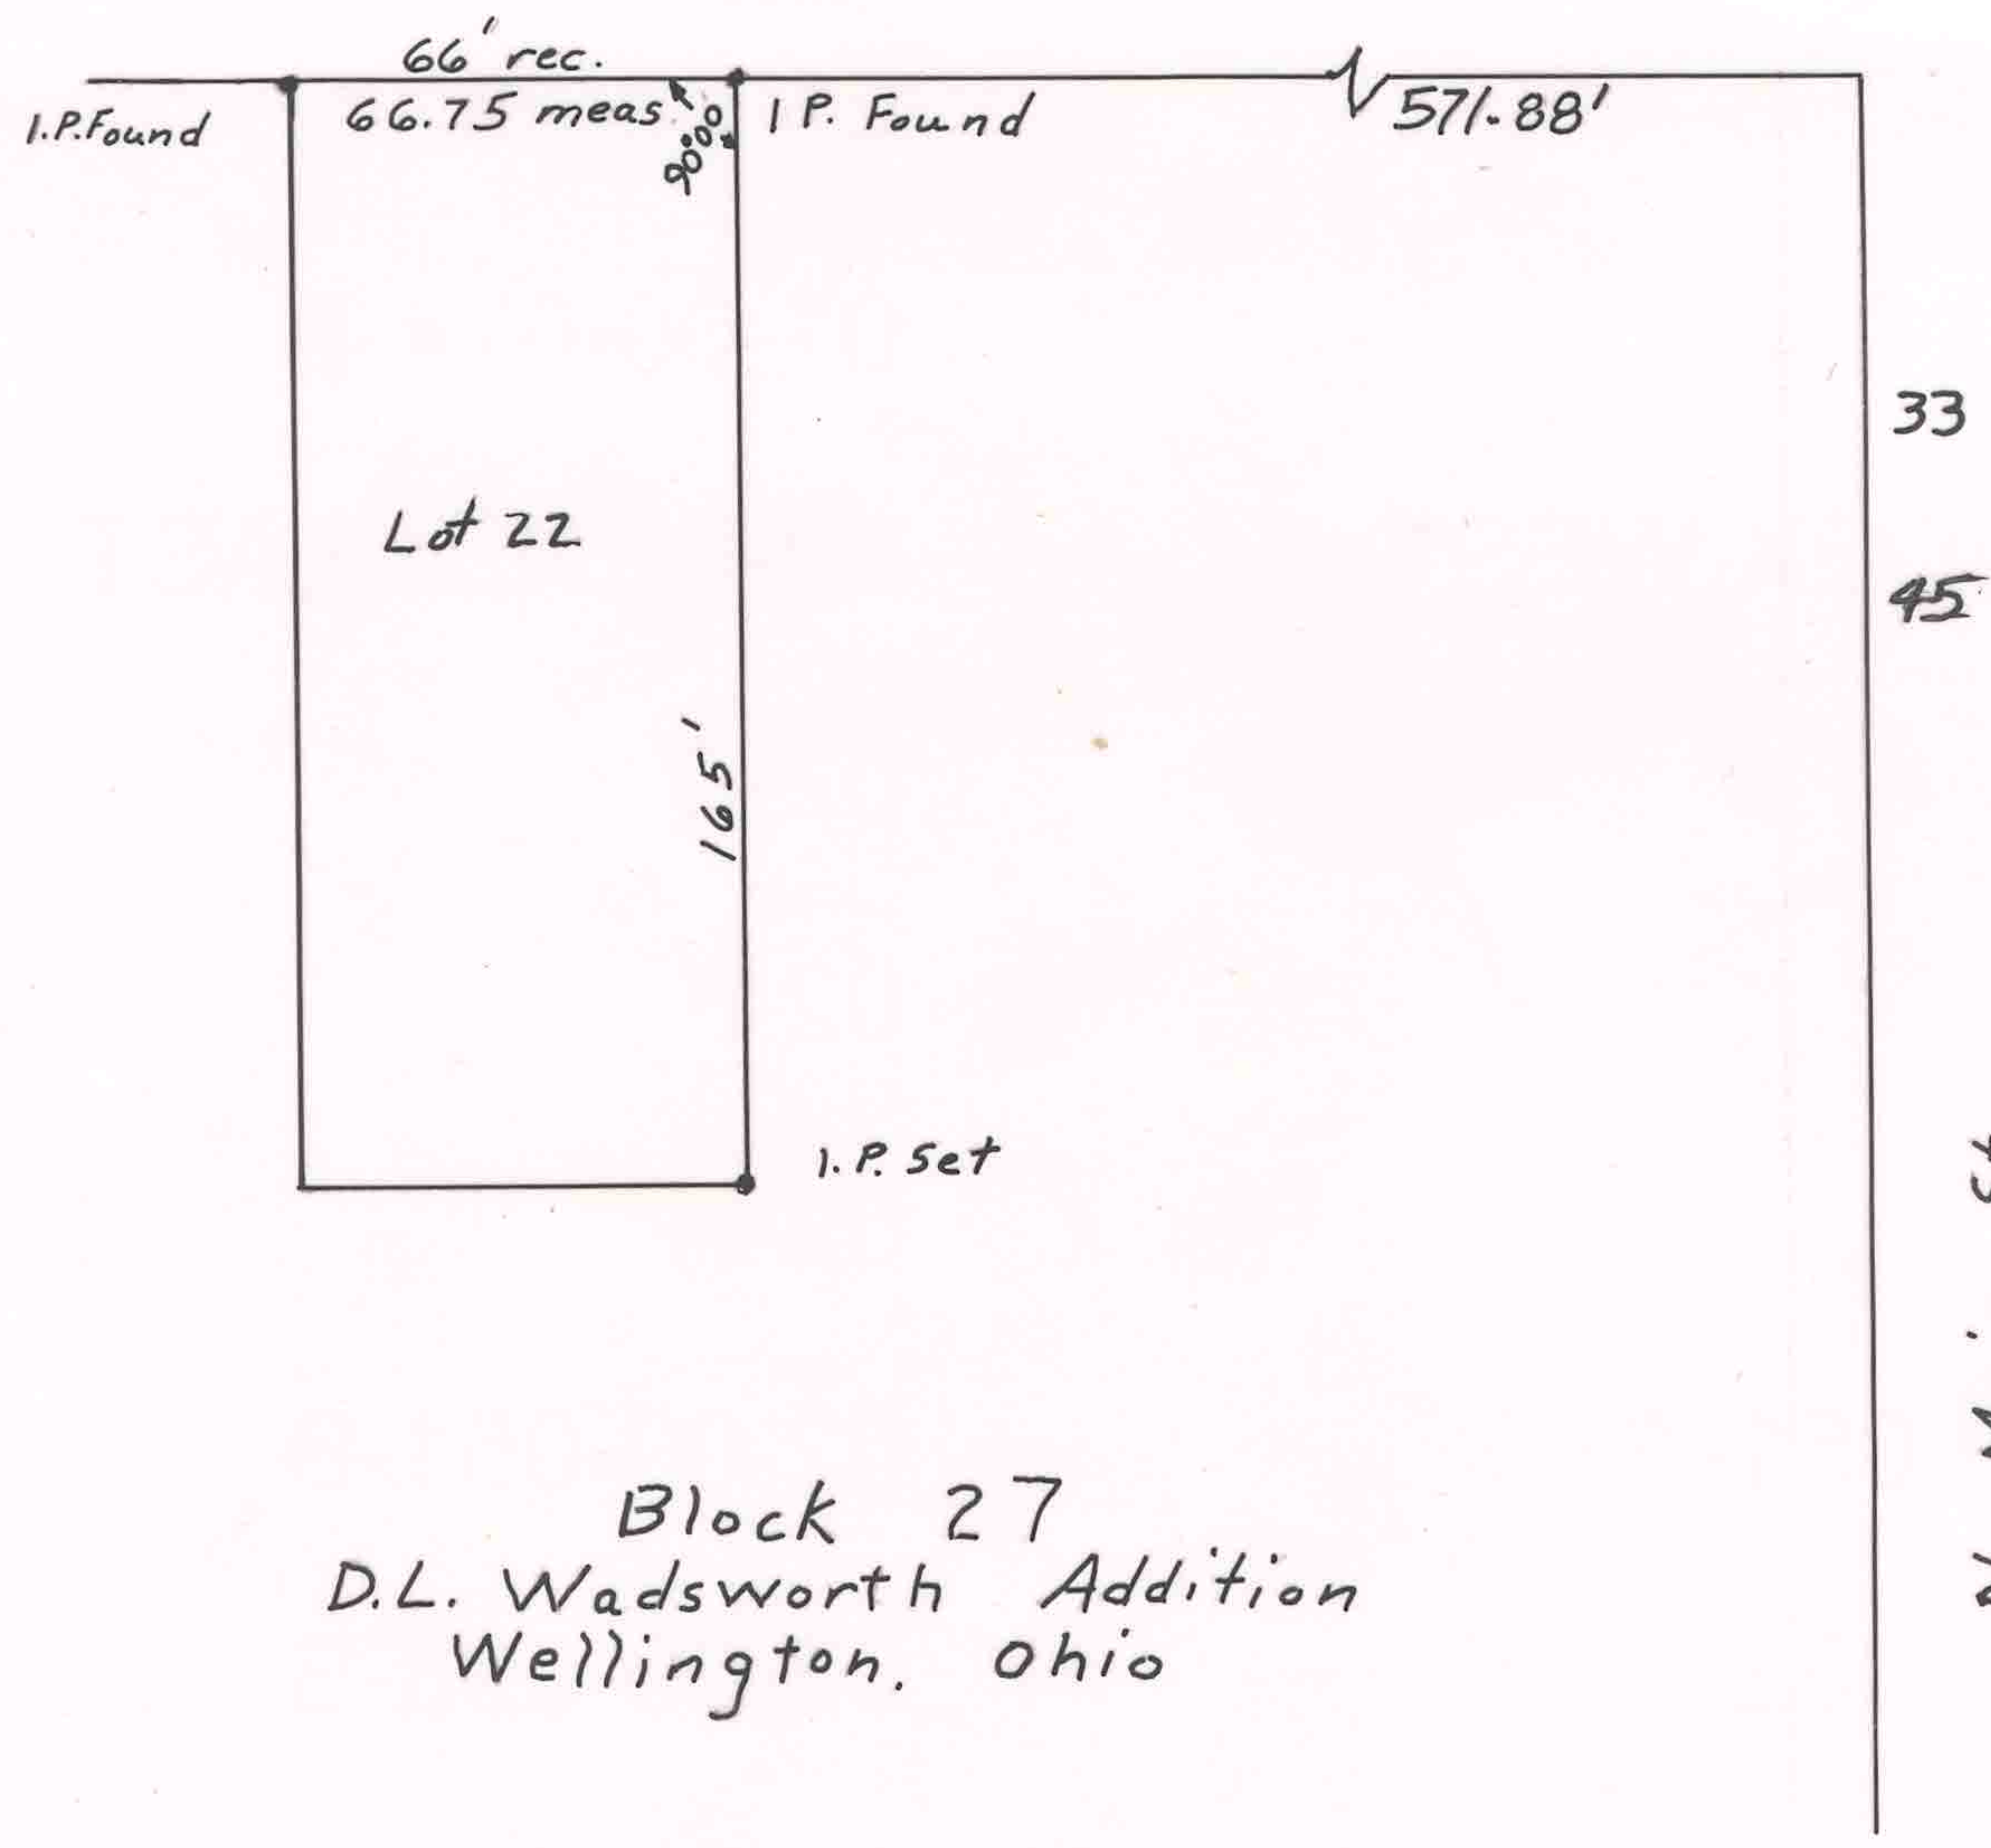

Block 27
D.L. Wadsworth Addition
Wellington, Ohio

Survey July 1957
O.S. Hillman