


9-00-085-B  
Scan # 46596

CROSS Fd.

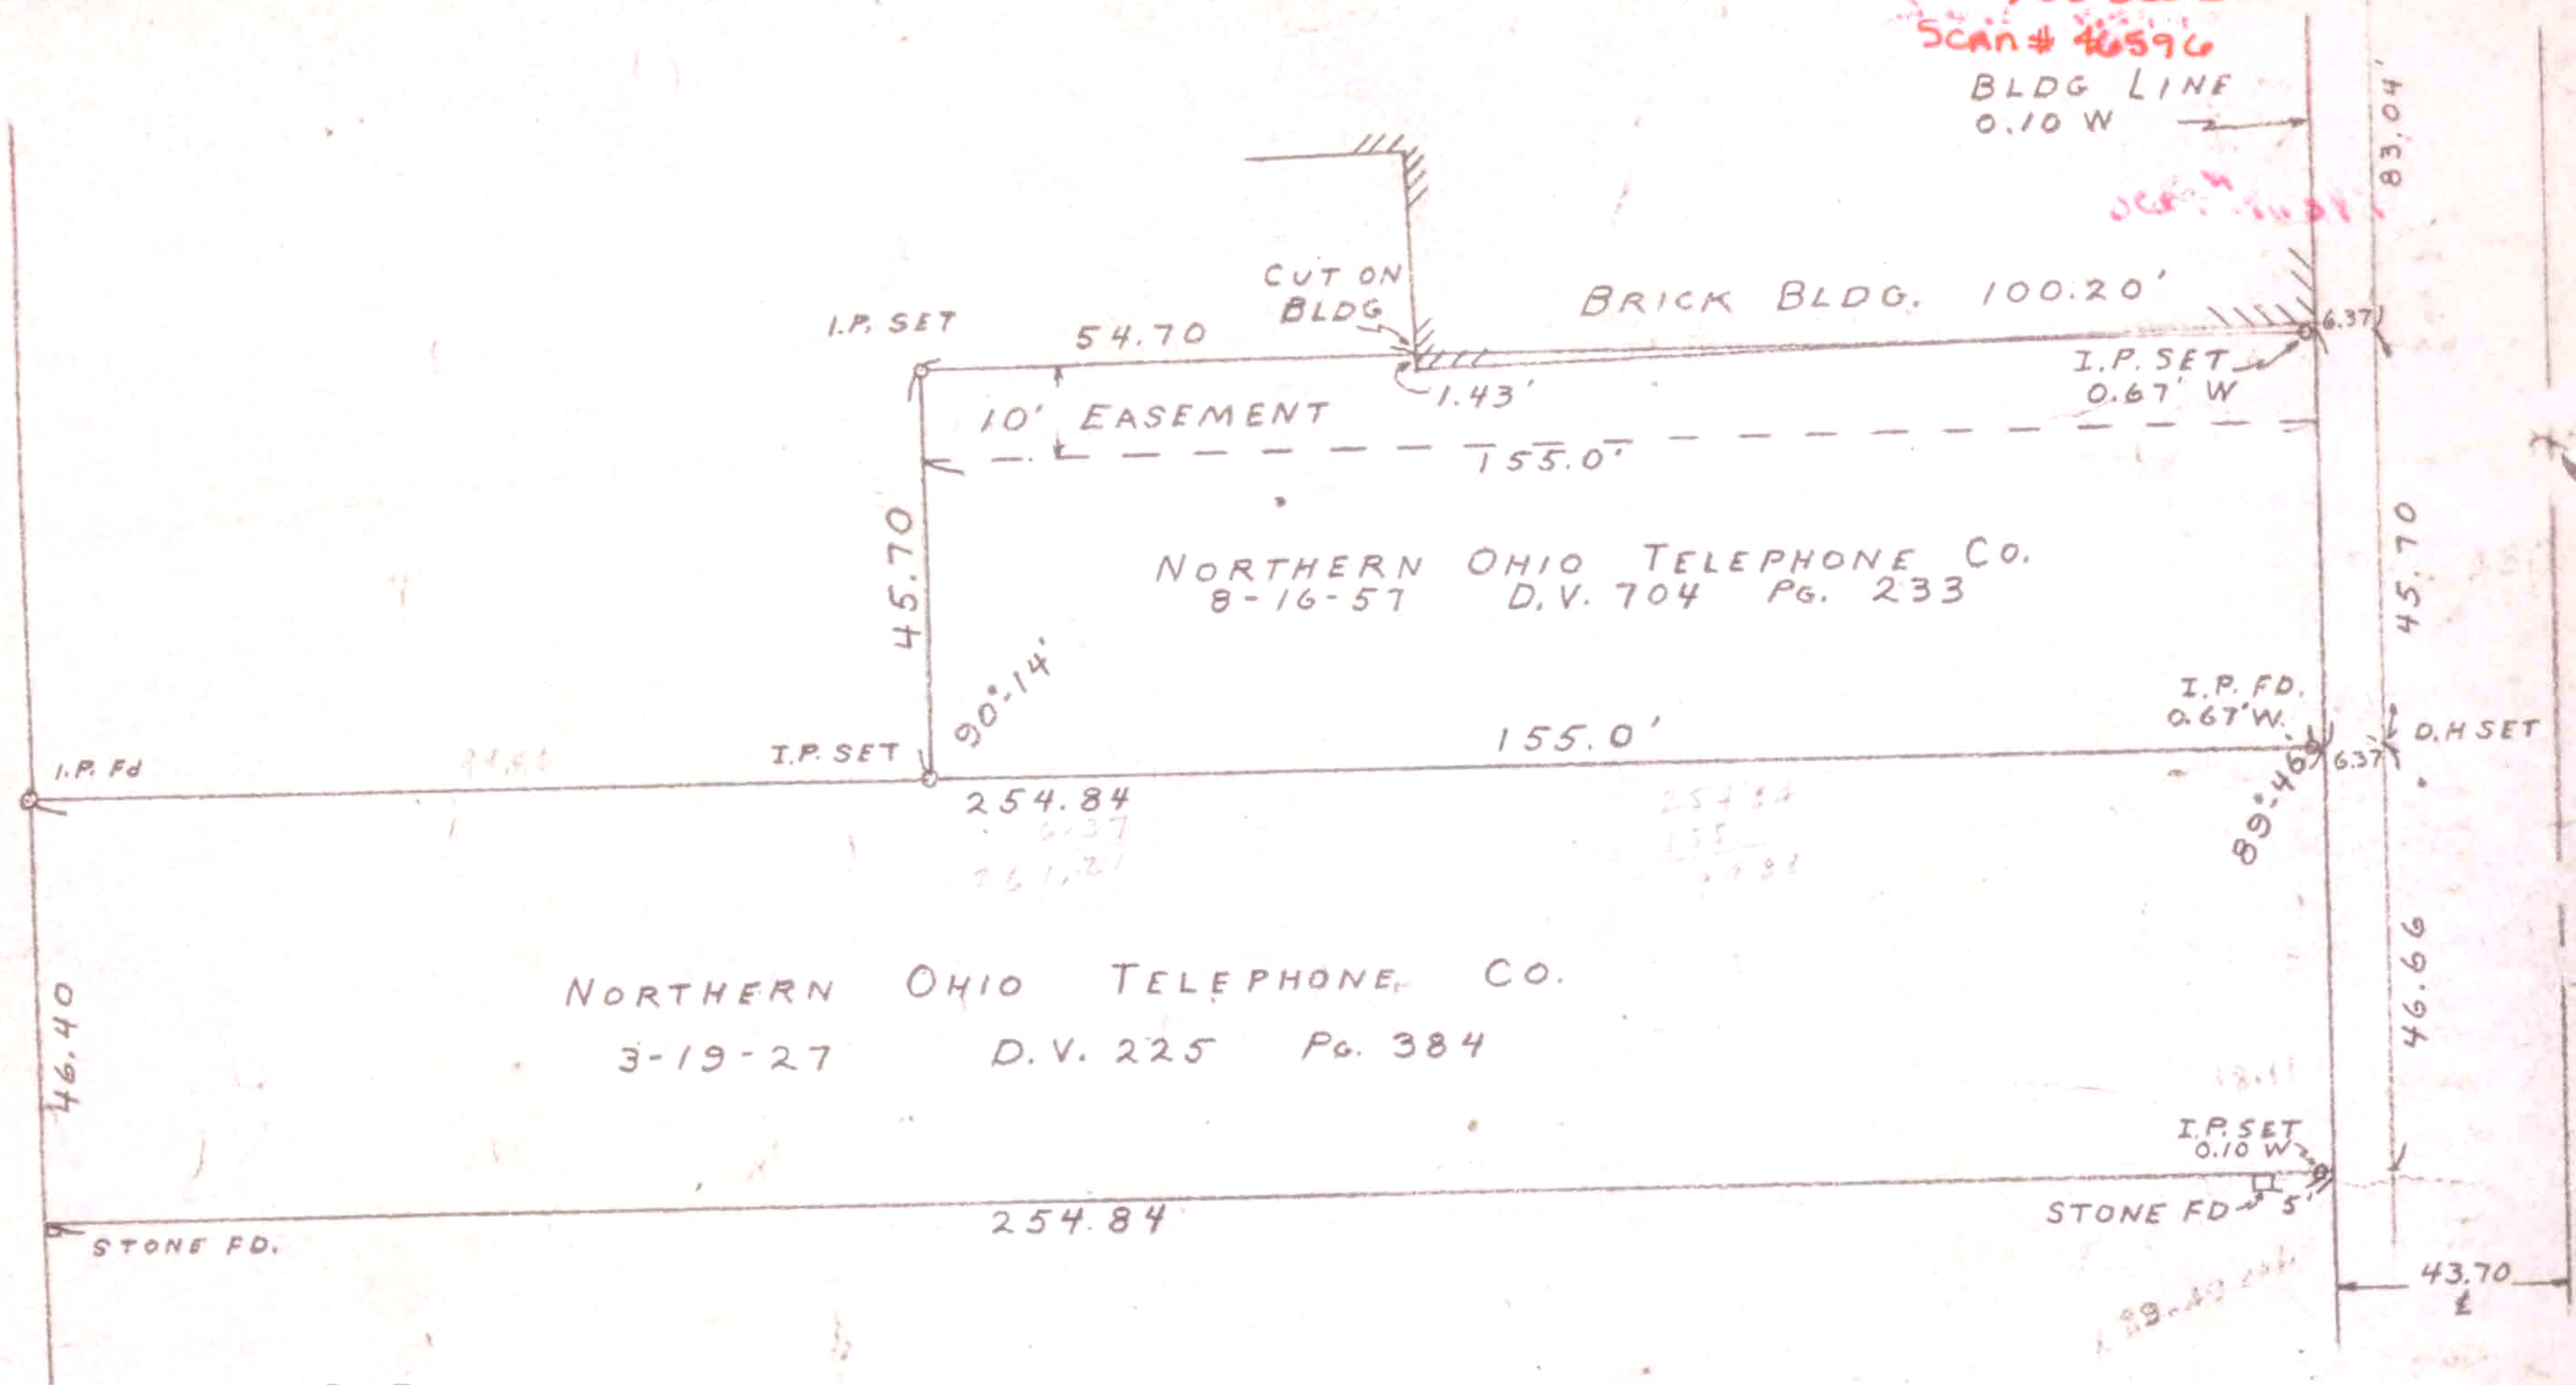

NORTHERN OHIO TELEPHONE CO.  
8-16-57 D.V. 704 Pg. 233

NORTHERN OHIO TELEPHONE CO.  
3-19-27 D.V. 225 Pg. 384



SURVEY FOR  
 NORTHERN OHIO TELEPHONE CO.  
 PART OF ORIG. VILLAGE LOT N<sup>o</sup> 74  
 CITY OF OBERLIN LORAIN CO. OHIO  
 SCALE 1"=30' OCTOBER 30 1957  
 T.W. LAUNDON REG. SURVEYOR

Main + College